

**GROUNDWATER MONITORING NETWORK
EVALUATION
Existing CCR Landfill
Rockport Plant
Indiana-Michigan Power Company
Rockport, Indiana**

Prepared for:
American Electric Power Service Corporation
and Indiana-Michigan Power Company
1 Riverside Plaza
Columbus, Ohio 43215



Prepared by:
Amec Foster Wheeler Environment & Infrastructure, Inc.
11003 Bluegrass Parkway, Suite 690
Louisville, Kentucky 40299



14 September 2017



TABLE OF CONTENTS

1.0 OBJECTIVE	1
2.0 BACKGROUND INFORMATION	1
2.1 Facility Location and Description	1
2.2 Description of CCR Unit	2
2.2.1 General	2
2.2.2 Surface Water and Leachate Control	3
2.2.3 Construction and Operational History	3
2.2.4 Area/Volume	4
2.3 Previous Investigations	4
2.4 Hydrogeologic Setting	5
2.4.1 Climate and Water Budget	5
2.4.2 Regional and Local Geologic Setting	6
2.4.2.1 Physiography and Drainage	6
2.4.2.2 Geology	6
2.4.2.3 Hydraulic Properties of Principal Groundwater Flow Zone	8
2.4.3 Surface Water and Surface Water-Groundwater Interactions	8
2.4.4 Water Users	9
2.4.4.1 Onsite Water Use	9
2.4.4.2 Offsite Water Users	10
3.0 MONITORING NETWORK EVALUATION	10
3.1 Hydrostratigraphic Units	10
3.1.1 Horizontal and Vertical Position Relative to CCR Unit	11
3.1.2 Piezometric Conditions	11
3.1.3 Overall Flow Conditions	12
3.2 Uppermost Aquifer	13
3.2.1 CCR Rule Definition	13
3.2.2 Identified Onsite Hydrostratigraphic Unit	13
3.3 Review of Existing Monitoring Network	14
3.3.1 Overview	14
3.3.2 Gaps in Monitoring Network	15
4.0 RECOMMENDED MONITORING NETWORK IMPROVEMENTS	15
4.1 General	15
4.2 Downgradient Monitoring Wells	16
4.3 Background Monitoring Wells	16
4.4 Vertical Screening Levels	16
4.5 Updated Well Survey	17
5.0 P.E. CERTIFICATION	17
6.0 REFERENCES	18



LIST OF TABLES

Table 1	Monitoring Well Construction Details
---------	--------------------------------------

LIST OF FIGURES

Figure 1	Site Location Map
Figure 2	Site Layout Map
Figure 3	Landfill Layout Map
Figure 4	Topographic Map
Figure 5	Surface Geology Map

APPENDICES

Appendix A	Current Landfill Permit (2015)
Appendix B	Maps and Cross Sections, 1983 Landfill Site Investigation
Appendix C	Well Construction and Lithologic Logs, Landfill Monitoring Wells
Appendix D	Piezometric Data
D-1	Ohio River Hydrograph, 2010-2015
D-2	Landfill Piezometric Maps, 2010-2013
D-3	Landfill Piezometric Data
D-4	Landfill Monitoring Well Hydrographs



1.0 OBJECTIVE

This Groundwater Monitoring Network Evaluation Report has been prepared by Amec Foster Wheeler Environment & Infrastructure, Inc. (Amec Foster Wheeler), on behalf of American Electric Power (AEP), to document the results of the monitoring well network evaluation conducted for the Ash Landfill at the Rockport Plant in Rockport, Indiana. The Groundwater Monitoring Network Evaluation was conducted to evaluate the adequacy of the existing monitoring well network and, if applicable, to make recommendations for additional well installations.

Specifically, the existing monitoring well network at the Ash Landfill was evaluated for compliance with the coal combustion residuals (CCR) Final Rule issued by the U.S. Environmental Protection Agency (USEPA) on 17 April 2015. Regulations pertaining to Groundwater Monitoring and Corrective Action are contained in the Code of Federal Regulations (CFR) 40 CFR 257.90 through 98. The focus of this evaluation was on §257.91 (Groundwater Monitoring Systems).

2.0 BACKGROUND INFORMATION

2.1 Facility Location and Description

The Rockport Power Plant is located in southwest Indiana (**Figure 1**) in Spencer County, on property extending into three Townships: Ohio, Hammond and Grass. The plant is situated on the north bank of the Ohio River, just northeast of the intersection of State Route (SR) 66, and United States (US) Highway 231. SR 66 runs along the river between the Town of Grandview (about 1.5 miles to the east) and the City of Rockport (about 1 mile to the southwest), and US 231 runs south from Interstate 64 (about 20 miles north of the plant), crossing the Ohio River into Kentucky via the William H. Natcher Bridge just southwest of the Power Plant.

The site is owned and operated by Indiana-Michigan Power Company, a regional unit of AEP. The property was developed in the late 1970s and early 1980s. The facility consists of two coal-fired 1,300-megawatt (MW) power generating units. The first unit went into operation in December 1984, and the second in December 1989. The facility has two existing CCR storage/disposal units consisting of the ash landfill located north-northeast of the generating plant, and two adjacent bottom ash (BA) ponds located just south of the generating plant at the north end of a wastewater pond complex. The general layout of the property and the locations of the CCR units are shown on **Figure 2**.

The following description of CCR generation and handling processes at the Rockport Plant is summarized from a letter sent by AEP to the Indiana Department of Environmental Management (IDEM) on 6 May 2009:

The plant burns about 9-10 million tons of coal per year. The coal, delivered by barge, is off-loaded to the coal storage yard then transported by conveyor into one of the two generating units, where it is pulverized to a powder then injected and burned. The heat produced in burning coal converts water to steam used to drive the turbine generators which produce electricity. The burning of coal produces two types of ash - fly ash and bottom ash. The Rockport Plant produces about 400,000 tons of fly ash and 140,000 tons of bottom ash per year.



Fly ash is the fine particulate matter entrained in the hot flue gases. To remove the fly ash prior to the gases exiting through the plant stack, the flue gas is routed through an electrostatic precipitator (ESP), where the ash particles adhere to electrically charged plates. Mechanical rappers knock the fly ash off the plates down into a series of collection hoppers. From the hoppers, the fly ash is pneumatically conveyed to a storage silo. From the silo, the ash is either loaded dry into closed trucks and shipped offsite for various uses, or conditioned with a small quantity of water and hauled by truck to the onsite landfill for disposal.

Bottom ash (BA) includes the heavier coal ash particles that fall to the bottom of the steam generator and are collected into refractory-lined hoppers. The hoppers are kept full of water to protect the lining and break the fall of large pieces of hot slag which shatter upon contact with the relatively cool water. From the hoppers, the BA-water mixture is routed to a crusher station where the ash is crushed to a size suitable for pumping. The BA is then pumped to one of the BA ponds located in the wastewater pond complex, where it precipitates out and can be reclaimed after the pond is drained.

2.2 Description of CCR Unit

2.2.1 General

The CCR unit referred to as the Ash Landfill, or Landfill, is located about 8,000 feet (1.5 miles) northeast of the generating plant. **Figure 3** shows the general layout of the landfill and the monitoring well locations, using the U.S. Geological Survey (USGS) topographic quadrangle map of 1964 (photorevised 1982) as a base. **Figure 4** is a topographic map for the whole plant area.

In March 1984, AEP submitted an application to develop 606 acres in the northern portion of the property for CCR disposal, including 460 acres for fly ash disposal (Storage Area 1) and 146 acres for bottom ash disposal (Storage Area 2). The Indiana Environmental Management Board (precursor agency to IDEM) issued a permit to construct in August 1985, and an operating permit (Facility Permit FP 74-2) in July 1987.

Because the bottom ash produced by the plant has been sold or used onsite for beneficial reuse purposes since the plant started operation, the portion of the property reserved for bottom ash storage and/or landfilling (Area 2) has never been used. The 1984 Permitted Boundary shown on the figures in this report includes only Area 1, the 460-acre area reserved for fly ash disposal. That area is transected by a north-south power line right-of-way (ROW). The area east of the ROW (Storage Area 1A) includes both closed and currently active portions of the fly ash landfill. The area to the west of the ROW has not been used for landfilling, but includes support facilities for the active landfill, including an office trailer, stockpile areas, leachate storage and ponds and a NPDES discharge structure.

The fly ash landfill is currently permitted by IDEM Office of Land Quality, Solid Waste Permits Section, as a Restricted Waste Site (RWS) under Indiana Administrative Code (IAC) 329 Title 10 (Solid Waste Landfill Disposal Facilities) Rule 9-4. A Restricted Waste Site may accept only one type, or related types, of waste. The waste is classified according to the results of certain leaching tests for specific parameters specified in the regulation. Classifications range from Type I (highest leachate concentrations) to Type IV (lowest leachate concentrations), and the landfill



requirements (including liner system and leachate handling requirements) are determined according to the waste class. The active landfill is permitted as a Restricted Waste Site Type I. The permit was most recently renewed on 10 February 2015, and expires on 11 February 2020. A copy of the permit is provided in **Appendix A**.

2.2.2 Surface Water and Leachate Control

As shown on the topographic maps in **Figures 3 and 4**, the original topography of the fly ash storage area was relatively flat, with grade elevations between 390 and 395 feet above Mean Sea Level (MSL, equivalent to the National Geodetic Vertical Datum of 1929, or NGVD29). Beyond the permitted boundary, the original topographic relief rose gently to the north-northwest, and more steeply toward hills to the northeast and northwest.

Stormwater from the landfill area is directed to perimeter drainage systems. The northeast, north and northwest perimeter of the landfill site is drained by Shafer Drain, part of a former agricultural drainage system that flows to Honey Creek southwest of the landfill. A perimeter ditch on the southeast landfill boundary also drains southwest to Honey Creek. Honey Creek flows southeast across the plant property to the Ohio River.

Leachate from the landfill cells is collected in lined ponds located north and west of the active landfill area. Prior to discharge, the leachate is transferred to the Leachate Treatment Pond (north of the West Leachate Pond), where it is diluted with well water from supply well PW-7. The effluent from the Leachate Treatment Pond is discharged and monitored under National Pollution Discharge Elimination System (NPDES) Permit No. IN0051845 at Station 002.

2.2.3 Construction and Operational History

Construction on the original fly ash landfill, located in the northeast portion of the permitted area (Area 1), was conducted between 1985 and 1987. In the early years of operation, much of the fly ash generated at the plant was beneficially reused (primarily for Ready-Mix concrete production), and filling of the landfill proceeded more slowly than anticipated at the time of permitting.

The original landfill cells were constructed on the east end of the permitted area, from north to south, with final cover being placed over the cells in this area (showed as Closed Landfill on the figures in this report) between 2000 and 2007. After 2007, expansion of the landfill continued into the southeast section of the area shown as the Active Landfill on the figures.

The ash that was landfilled originally (in the late 1980s and early 1990s) was generated from combustion of fuel high in western coal (relative to eastern coal), and was classified as Type II. This waste had very low permeability, and (consistent with the permit) was placed in cells lined with 5 feet of clay soil (either native in-situ soil or from borrow areas) having an average bulk permeability of 10^{-6} centimeters per second (cm/sec) or less. No leachate collection system exists between the CCR and the liner in the original landfill cells. Runoff from the cells was collected in a central pond west of the original landfill and within the currently active landfill area, and transferred from there to the leachate treatment pond for discharge via NPDES Station 002. In



2014, the original leachate collection pond in the active landfill area was removed and replaced with the perimeter leachate collection ponds (north and west).

Over a period of years after the mid-1990s, the chemistry of the fly ash changed due to changes in the sources of coal used for combustion at the plant, as well as the introduction of new materials used for emissions controls after 2007 (including sodium bicarbonate used for sulfur dioxide removal in a dry sorbent system, and granular activated carbon used for mercury removal). The landfill was reclassified as a Type I landfill through a permit modification approved by IDEM in August 2012. Under the modified permit, new cells are lined with a composite liner consisting (from the bottom up) of: 2 feet of clay with a bulk permeability of 10^{-7} cm/sec or less, a 30-mil PVC synthetic liner, and 2 feet of bottom ash containing a piping network for leachate collection. In some cells, bottom ash (which is still classified as a Type II waste) is also being placed below the composite liner to raise the subgrade level, to allow gravity drainage of the leachate collection system to the collection ponds. Current landfill construction is proceeding according to the design in the modified permit, *Fly Ash Landfill Redesign Construction Drawings, Storage Area 1A, RKP Permit #FP-74-2* prepared by Terracon and dated February 2012 (Terracon 2012).

2.2.4 Area/Volume

The total area inside the 1984 permit boundary for Area 1 is approximately 460 acres. The latest permit renewal, issued on 15 February 2015, indicates the total permitted landfill area is 554 acres, including 408 acres in Area 1 and 146 acres in Area 2 (the area designated for bottom ash storage). The permitted portions of Area 1 include Area 1A east of the power line ROW (approximately 175 acres), and Area 1B west of the ROW (approximately 233 acres). Area 1A includes the closed landfill area (approximately 41 acres) and the active landfill area (approximately 134 acres). Within the active landfill area, 110 acres have been approved for conversion from a Type II to a Type I RWS.

Based on information provided by AEP, the total permitted volume of landfill space for Type I waste is 10,840,300 cubic yards (CY). The total estimated volume of fly ash disposed in the Type I RWS through December 31 2015 was 324,523 CY, leaving 10,514,777 CY of capacity in Area 1A. Area 1B is expected to be developed for landfilling as Area 1A approaches capacity.

2.3 Previous Investigations

Site investigations were performed on the Plant property in the late 1970s and early 1980s to support design, construction and permitting in advance of plant start-up, which occurred in December 1984.

Specifically for the landfill area, AEP prepared a Landfill Application Package (AEP 1984) containing the methods and findings from a Site Investigation performed in 1983 by AEP Civil Engineering personnel of the northern portion of the plant property, to support permitting of the two CCR stockpile and landfilling areas. A location map and cross-sections as well as a bedrock topography map and a map showing the locations of existing oil and gas wells from that document are provided in **Appendix B**.



In addition, numerous subsequent submittals related to the landfill have been made by AEP to IDEM. These public records, including IDEM responses and notifications, are available for download from IDEM's online Virtual File Cabinet (VFC). They include additional borrow area investigation reports, landfill design submittals, permit modifications, and semi-annual groundwater monitoring reports (GWMRs). While an in-depth review of the totality of these records was beyond the scope of the current study, Amec Foster Wheeler has consulted selected documents available through the VFC for information on the landfill history and current permit status.

Information related to the monitoring wells installed at the landfill was provided to Amec Foster Wheeler by AEP, and construction details for those wells are summarized in **Table 1**. Monitoring well logs are reproduced in **Appendix C**.

2.4 Hydrogeologic Setting

The following sections provide information on the hydrogeologic setting of the AEP Rockport Plant, including climate, physiography and drainage, geology, hydraulic properties of the principal groundwater flow zone, surface water and interactions between surface water and groundwater, and water users.

2.4.1 Climate and Water Budget

The area of Rockport has a continental climate regime. As described by Ray (1965), summers are long hot and humid, and winters are damp and relatively mild, with brief periods of intense cold. Mean monthly temperatures vary from 35 degrees Fahrenheit (°F) in January to 79°F in July.

The closest meteorological station with long-term data is Owensboro, Kentucky. Based on National Climatic Data Center (NCDC) data for the period from 1971 through 2000, as reported by the Midwest Regional Climate Center (MRCC, <http://mrcc.isws.illinois.edu/>), the normal annual precipitation in Owensboro is 45.07 inches. Precipitation is well distributed throughout the year, on average, but can be highly variable from month-to-month. Monthly normal precipitation varies from 2.67 inches in October to 4.66 inches in May. However, monthly extremes during the period from 1928 through 1990 ranged from 0.06 inches in October 1987 to 16.15 inches in March 1964.

Mean annual potential evapotranspiration in Owensboro is between 31 and 33 inches, according to mapped data available from the Kentucky Climate Center (<http://www.kyclimate.org/index.html>). The adjusted annual potential evaporation estimated in the Landfill Application Package (AEP 1984, Table 10), based on climatic data from Tell City, was 32.22 inches per year. The mean monthly water balance developed for the landfill resulted in the following breakdown (Table 11) for an estimated annual precipitation of 44.27 Inches:

- Surface Runoff – 13.23 inches (30%);
- Actual Evapotranspiration – 25.69 inches (58%);
- Percolation (groundwater recharge) – 5.44 inches (12%).



2.4.2 Regional and Local Geologic Setting

2.4.2.1 Physiography and Drainage

The area of Rockport lies in the western Interior Low Plateau physiographic province of the United States, in a subarea referred to as the Wabash Lowland. It is an area of broad alluviated valleys and dissected uplands of rolling to hilly terrain with gentle slopes and moderate relief (Ray 1965). The topography in the vicinity of the Rockport Plant is shown on the U.S. Geological Survey (USGS) topographic map reproduced in **Figure 4**.

Drainage in the area is provided by the Ohio River, which is adjacent to the plant property on the southeast, is over 2,000 feet wide in the vicinity of the plant, and flows to the southwest toward Owensboro, Kentucky. The plant property slopes gently across a terraced surface from elevations greater than 410 feet on its northern edge, where it is bordered by low hills and an upper terrace, to as low as 390 feet along the top of the bank of the Ohio River. Much of the property is drained by Honey Creek, which flows south-southeast to the Ohio River and is incised down to an elevation of approximately 380 feet. The power generation plant was developed on the portion of the property between US 231 on the west and Honey Creek on the east. It is located on a watershed divide between Honey Creek and an unnamed tributary offsite to the southwest.

The natural topography over most of the property (outside the channel of Honey Creek) prior to development of the power plant consisted of a relatively flat terrace surface marked by east-west oriented crests and swales. Multiple low-gradient drainage ditches crossed the area, connecting the two watersheds (Honey Creek and the watershed to the west). Regrading for development of the power plant and associated facilities (including construction of the wastewater pond complex) disrupted some of the existing natural drainage as well as the man-made drainage that existed on the surface of the terrace and is still depicted on the USGS topographic map in **Figure 4**.

2.4.2.2 Geology

The area of the site lies in the southern portion of a broad shallow downwarp structure referred to as the Illinois Basin (also known as the Eastern Interior Basin), and is underlain by sedimentary bedrock of Pennsylvanian age. The bedrock underlying the site and most of Spencer County is the Pennsylvanian age Raccoon Group, consisting of sandstone and shale with minor amounts of mudstone, coal and limestone (Grove 2006). The rock reported from onsite borings that extended through the unconsolidated overburden into bedrock has been described primarily as shale. The boring for bedrock wells finished at the MW-5 location (at the northeast landfill perimeter) encountered interbedded sandy claystone, sandy shale, limestone, coal and claystone.

The bedrock surface beneath the overburden is uneven, and includes rounded hills, ridges and valleys (draining southeast) representing the erosional surface that existed prior to filling of the valley with glaciofluvial sediments.



The geology of the near-surface unconsolidated Quaternary sediments associated with the Ohio River valley is depicted on the geology map in **Figure 5** (which excludes the far east portion of the Plant property), and described in detail by Ray (1965). These sediments range in thickness from about 20 feet on northern sections of the property, to as much as 130 feet along the Ohio River west of the mouth of Honey Creek. They include windblown sediments (loess) up to 30 feet thick that mantle bedrock on the northeast perimeter of the property, possibly merging with lacustrine deposits in the tributary valley at the northwest corner of the property, and two series of Wisconsin age valley-train deposits (Tazewell and Cary) under most of the property. The valley-train sediments that fill the broad river valley were deposited by meltwater from retreating continental glaciers to the north and northeast, and were subsequently reworked by modern drainage systems, including the Ohio River and the Honey Creek drainage on the plant property.

Generally, the valley train deposits thicken and coarsen to the southeast, from the loess-mantled bedrock hills along the valley wall, toward and beyond the course of the modern Ohio River. In the subsurface, the valley train sediments typically coarsen downward, and can be classified generally into finer-grained sediments near the surface (including silt, sandy silt, silty clay and clay), and coarser-grained sediments (fine to coarse sand and some gravel) at depth.

Interpretive cross-sections of the subsurface were generated by AEP from data collected in the 1983 Site Investigation of the landfill area, and have been included in **Appendix B**. In the report of the Site Investigation included in the Landfill Application Package (AEP 1984), the unconsolidated sediments encountered above bedrock were grouped into four units, described below in descending order:

- Unit No. 1 – surficial silt and clay. This unit was found to be 2 to more than 15 feet thick. The upper section is predominantly silty, sandy clay that is stiff, and of low to medium plasticity. Very fine-grained sand and silt are stratified with the clay toward the bottom of the unit, suggesting a lacustrine depositional environment where these finer-grained deposits are thickest.
- Unit No.2 – well sorted sand. This unit, where present, was found to extend from the bottom of the fine-grained surficial unit to elevations of 373-376 feet. It was found to consist of fine to medium-grained, well-sorted subangular to subrounded quartz sand.
- Unit No. 3 – poorly sorted sand. This lower sand unit, consisting of poorly sorted, very fine to very coarse-grained sand, is the dominant unit between elevations of 373-376 feet and the underlying bedrock, which is typically found at elevations of 290 to 300 feet under most of the property, and at shallower depths in the north and northwest portions.
- Unit No. 4 – sand and gravel. Unit No. 4, consisting of poorly sorted sand, gravel and gravelly sand, was found to be gradational with Unit No. 3, and to occur as lenses within Unit No. 3. Gravel in this unit is subangular to rounded, ranges in size from 3/8 to 1 inch in diameter, and commonly contains coal particles.



2.4.2.3 Hydraulic Properties of Principal Groundwater Flow Zone

The saturated section of the unconsolidated sand and sand and gravel body comprising subsurface Unit Nos. 2, 3 and 4 (as described in the preceding section) makes up the principal groundwater flow zone underlying the site. This zone is hydraulically connected to the Ohio River but the connection is buffered by lower-permeability sediments that line the river bottom. Because of its relatively high permeability and its connection to the Ohio River, this zone represents an aquifer capable of supplying large yields to pumping wells. The depth to water in this zone typically ranges from 20 to 35 feet BGS, and the saturated thickness (which generally increases toward the river) ranges from less than 15 feet to more than 80 feet. Groundwater occurs in this zone under unconfined conditions, or semi-confined conditions where the surficial silt and clay directly overlie the saturated zone.

AEP provided information concerning pumping tests of varying lengths performed in this zone using onsite supply wells, including a pumping test performed in 1977 that was documented in the Landfill Application Package (AEP 1984), a pumping test performed in 2004 at a new supply well installed at the landfill for leachate dilution, and yield tests performed in 2011 and 2012 at two new replacement wells used for fire water supply. Based on the information reviewed, the principal groundwater flow zone underlying the site has a transmissivity ranging from 126,000 to 250,000 gallons per day per foot (gpd/ft), corresponding to 17,000 to 34,000 square feet per day (ft²/day). The hydraulic conductivity of the formation ranges from 420 to 560 feet per day (ft/day), and the storage capacity (specific yield) ranges from 0.07 to 0.22. Pumping well yields range up to 1,000 gallons per minute (gpm), and specific capacities range from 48 to 121 gpm per foot of drawdown (gpm/ft).

2.4.3 **Surface Water and Surface Water-Groundwater Interactions**

The Ohio River at Owensboro drains a watershed of 97,000 square miles and the average flow is 121,200 cubic feet per second (cfs), according to Ray (1965). The stage in this section of the river is maintained by a downstream dam in Newburgh, Indiana above a minimum pool elevation of about 357.4 feet MSL (358 feet relative to the Ohio River Datum). The AEP Rockport Plant, located at River Mile (RM) 744-745, is halfway between the Newburgh Dam (RM 776) and the upstream Dam at Cannelton (RM 721). The river level at the Rockport Plant can be estimated by averaging the gauge data reported by the US Army Corps of Engineers (USACE) at Newburgh and Cannelton. A hydrograph (graph of water level over time) of the estimated daily stage in the Ohio River at the Rockport Plant from 2010 through 2015 is provided in **Appendix D-1**.

The water level in the Ohio River typically remains close to pool elevation in the summer and fall, and fluctuates at a relatively high frequency (for a few days to weeks), up to 20 feet above pool elevation, in the winter and spring months. The river stage typically reaches an elevation of 377 feet at least once in most years. The elevation of the 10-year flood is 387.7 feet, the 100-year flood level is 392 feet, and the level of the highest flood of record in the area (the flood of 1937) is 397 feet.



Groundwater levels and gradients in the glaciofluvial (valley train) sediments that fill the valley are strongly influenced by the Ohio River. Under low-water (pool) conditions, groundwater in the sediments flows under a low gradient toward the Ohio River. As the river level fluctuates in winter and spring, groundwater levels fluctuate along with it, although the effects are increasingly dampened with distance from the river. During rapid rises in river level, the groundwater gradient can be temporarily reversed to some distance from the river bank, resulting in excess groundwater being stored in the sediment (bank storage), and then draining slowly back toward the river again as the river stage falls.

2.4.4 Water Users

The Indiana Department of Natural Resources (IDNR) Division of Water maintains an online database of Significant Water Withdrawal Facilities (<http://www.in.gov/dnr/water/4841.htm>). A Significant Water Withdrawal Facility (SWWF) is defined as a facility that has the capacity to withdraw more than 100,000 gallons per day (gpd) in aggregate from surface water and/or groundwater, through one or more registered “sources” (individual pumping wells or stations). There are 10 SWWFs registered in Spencer County, of which the AEP Rockport Plant has the highest capacity.

2.4.4.1 Onsite Water Use

The main source of water used at the plant is the Ohio River. The plant’s registered capacity for surface water is 80,000 gpm. According to the IDNR database, in 2011 the plant’s actual average usage of river water was 22.3 million gallons per day (mgd), corresponding to an average surface water withdrawal of 15,500 gpm.

The plant also has seven registered water withdrawal wells. The locations of these supply wells are shown on **Figure 2**. The combined average withdrawal from these wells in 2011 was 0.59 mgd (410 gpm). Information available for the onsite water supply wells is summarized below (withdrawal rates are based on 2011 data available in the IDNR database):

- Wells PW-1 and PW-2 are used for plant potable supply. The combined average withdrawal rate for these two wells is approximately 120 gpm.
- Wells PW-3 and PW-4 are used for fire water supply as well as industrial supply. The combined average withdrawal rate for these two wells is approximately 120 gpm.
- Well PW-5 was installed on the west side of US 231 and was intended to be used for landscape watering around an energy education center constructed by AEP at that location. The well is inactive (no withdrawals since it was installed).
- PW-6 is a well installed immediately west of the active landfill to fill water trucks used for dust control. The average water withdrawal rate for this well is 17 gpm.
- PW-7 is a well installed southwest of the active landfill to provide water for treating landfill leachate prior to discharge, as required under the plant’s NPDES permit. The average water withdrawal rate for this well is 39 gpm.



2.4.4.2 Offsite Water Users

The other nine SWWFs in Spencer County include the following:

- The City of Rockport public supply (five wells with a combined capacity of 1,163 gpm).
- The Town of Grandview public supply (two wells with a combined capacity of 970 gpm).
- Reo Water, Inc., public supply for the City of Richland, west of Rockport (five wells with a combined capacity of 1,130 gpm).
- The City of Boonville public supply, northwest of Rockport (four wells with a combined capacity of 2,050 gpm).
- Corn Island Shipyard, a marine barge manufacturer on the Ohio River in Grandview (one well with a capacity of 450 gpm).
- Three agricultural irrigation users (Christmas Lake GC, Loehr Farms and Allen Gray LP II), all located remotely from the AEP Rockport Plant.
- One coal washing operation (Buckhorn Processing) using surface water, located in Lamar, Indiana north-northwest of the AEP Plant.

The Ohio River navigation charts (USACE 2014) show surface water intakes and other major structures along the river. The charts for sections of the river adjacent to and immediately downstream of the AEP Rockport Plant show the industrial intakes for the AEP plant and Rockport Terminals (a coal barging facility), and shoreline facilities in Rockport for one commercial marina, two crushed stone operations, and two loading facilities (ADM and Coal Inland).

3.0 MONITORING NETWORK EVALUATION

3.1 Hydrostratigraphic Units

Based on the available information, two generalized hydrostratigraphic units can be distinguished within the unconsolidated subsurface materials below the AEP Rockport Plant.

The upper unit, consisting of surficial silt and clay (locally containing sand), is typically 8 to 25 feet thick, and is generally not saturated. However, it can serve as a perching layer above which water can accumulate in surface depressions or in more permeable surface fill. Soil sampling and permeability testing performed as part of the 1983 landfill Site Investigation indicates the bulk vertical permeability of the material in this unit is on the order of 10^{-7} to 10^{-6} centimeters per second (cm/sec), or 0.003 to 0.0003 ft/day.

The lower unit extends from the bottom of the surficial silt and clay to the top of bedrock, and consists of granular outwash deposits. These deposits consist primarily of sand, ranging from well-sorted fine sand to poorly-sorted fine to coarse sand, with lenses of gravelly sand and sandy gravel. This unit has an uneven bottom surface, but generally thickens to the southeast, toward the Ohio River. The lower section of this unit is saturated and represents the principal groundwater flow zone beneath the property. The saturated thickness in this unit ranges from less than 15 to more than 80 feet, and the bulk horizontal permeability (hydraulic conductivity) of this unit is on the order of 500 ft/day.



Bedrock underlying the unconsolidated deposits consists predominantly of shale, and is expected to have low permeability. Bedrock in the area of the Rockport Plant does not represent a significant medium for flow or storage of recently recharged (meteoric) groundwater, and is not a reliable source of fresh water supply, relative to the much more available source in the sandy overburden.

3.1.1 Horizontal and Vertical Position Relative to CCR Unit

Stratigraphic information for the area of the landfill is available from the lithologic logs for the monitoring wells (**Appendix C**) as well as the 1983 Site Investigation results illustrated in the maps and cross-sections in **Appendix B**, and several studies of nearby borrow areas.

The interface between the surficial silt and clay and the underlying granular outwash deposits occurs at an elevations of approximately 380 to 382 feet MSL below most of the landfill area (based on the logs for monitoring well locations MW-1, MW-2, MW-3, MW-8, and MW-18), or about 10 to 15 feet below original grade. On the northeast landfill perimeter (at locations MW-15, MW-16 and MW-17), the elevation of the interface is somewhat lower, closer to 370 feet. In a few locations (MW-4, MW-21), the surficial deposits are thin (less than 10 feet) and contain sandy interlayers. Bedrock elevations (at the base of the outwash deposits) rise from 286 to 290 feet at the southeast landfill perimeter to as high as 358 feet (at location MW-14) on the northern perimeter. Essentially, the outwash deposits thin and then pinch out moving northward from the landfill, as bedrock becomes shallower and the unconsolidated deposits overlying bedrock transition from outwash to less permeable terrace, lacustrine and loess deposits. Location MW-5 is located on top of a buried bedrock high, where bedrock is only 21 feet deep, and the overburden consists primarily of silty clay.

From the available documents, it appears that CCR in the closed sections of the landfill was placed close to or slightly below original grade, after removal of the top 1.5 feet of soil (including topsoil), and confirmation that at least 5 feet of in-situ silty clay soil was present. In the active landfill, bottom ash (a Type II waste) is still being placed at grade in some areas to raise the subgrade level for the Type I waste cell liner. A conservative estimate of the lowest elevation of CCR (including both bottom ash and flyash) in the landfill would be 390 feet MSL. The minimum separation between the bottom of the CCR and the underlying outwash deposits is 5 feet, by landfill design. In most locations, at least 10 feet of surficial silt and clay deposits would be expected to underlie the CCR. The outwash deposits underlying the surficial deposits thicken from about 15 feet or less near the northern landfill perimeter to as much as 90 feet at the southern perimeter.

3.1.2 Piezometric Conditions

Groundwater level data are available from piezometric measurements made in the landfill monitoring wells since 1985, and reported to IDEM in semi-annual groundwater monitoring reports (GWMRs). Each GWMR contains a plan sheet with a table summarizing water level and field parameter measurements, and a piezometric contour map (also known as a potentiometric map). Seven piezometric maps from May 2010 through May 2013 are reproduced in **Appendix D-2**



(more recent maps were not available in the IDEM VFC). **Appendix D-3** contains a summary of the piezometric data provided by AEP for the period from November 1992 through May 2015. Hydrographs (graphs of water level elevations over time, by well), for the period from November 1998 through May 2015, are provided in **Appendix D-4**.

A review of the data indicates that water levels in the wells north of the landfill, including MW-9S, MW-10S and MW-5S and 5I (both finished in bedrock at the north perimeter of the landfill) are significantly higher (by 20 to 25 feet) than in the rest of the landfill wells. These three locations are located at the fringes, or outside of, the principal groundwater flow zone (i.e., the sandy outwash deposits).

All of the other wells monitor the principal flow zone that extends under the landfill and thickens to the southeast toward the Ohio River. These wells exhibit relatively low seasonal fluctuations, on the order of 1 to 2 feet, in most years. The long-term amplitude of groundwater level fluctuations under the landfill area is on the order of 6 feet, between elevations of approximately 366 and 372 feet. At its highest level, groundwater below the landfill is approximately 18 feet below the lowest CCR elevation of 390 feet.

The dominant groundwater flow direction under the landfill is to the southeast. Due to the high permeability of this zone, hydraulic gradients are relatively low. The differences in water levels between clustered (shallow/intermediate and deep) wells at a single location is on the order of 0.1 feet or less, indicating almost no vertical gradient. The difference in water level elevations on any one date between upgradient locations at the northern perimeter (MW-14) and in the west (MW-8), and at the downgradient (southern) perimeter (such as MW-1 and MW-21) is on the order of 1 foot (ranging from 0.2 to 1.8 feet). The water level in well MW-12S, approximately 3,000 feet to the southeast of the southern landfill perimeter, is generally lower than in the landfill perimeter wells, ranging from about 0.3 to 2.0 feet lower than in MW-1S. In one event (May 2011), the water level elevation in MW-12S was higher than in the southern perimeter wells. This condition was related to a temporary flow reversal associated with a period of very high river levels, in which the Ohio River had spiked at 387.7 feet (the 10-year flood level) on April 28; this flow reversal was also observed in the wells monitoring the wastewater pond complex farther to the south. As illustrated on the piezometric map for May 2011 (**Appendix D-2**), however, this flow reversal only reached the southern landfill perimeter, and apparently did not propagate under the landfill, where the gradient continued to be southeasterly.

Based on the available data and the analysis described above, a water level elevation of 372 feet can be considered a high groundwater level in the sandy outwash deposits that underlie the active landfill.

3.1.3 Overall Flow Conditions

The principal groundwater flow zone underlying the landfill is the lower overburden unit consisting of granular outwash deposits (sand with some gravel). Recharge into this unit occurs laterally from hills and buried tributary valleys to the north-northwest. Recharge also occurs from the Ohio River to the southeast during relatively brief periods (spikes) of high water level in the river. Areal



recharge also occurs vertically from the surface. The rate of areal recharge varies locally according to the thickness and bulk permeability of the overlying silt and clay unit.

Groundwater flow in this zone is predominantly to the east-southeast, toward the Ohio River. Flow reversals occur during brief periods of high river level, but are temporary and do not extend under the landfill, therefore having no long-term effects on flow or migration of constituents in groundwater.

Supply wells are present to the southwest and west of the active landfill, including nearby wells PW-6 and PW-7. During a pumping test of PW-7 in 2004, in which that well was pumped at a rate of 1001 gpm for a period of 24 hours, significant drawdowns (ranging from 1.3 to 3.4 feet) were produced in nearby monitoring wells MW-18, MW-19 and MW-20. However, in actual operation, this well (like the other onsite supply wells) operates intermittently, and had an average pumping rate of 39 gpm in 2011. The intermittent operation and relatively low flow rates of the onsite pumping wells appear to be insufficient to affect flow directions at significant distances from the pumping centers on a long-term basis. However, during groundwater monitoring in May 2014, it was noted that groundwater flow was being pulled temporarily toward PW-7 due to an unusually high demand and longer-than-normal pump operation in this well. Therefore, temporary flow direction changes could be associated with onsite well operations.

Based on available data, the estimated horizontal average hydraulic gradient (i) beneath the landfill under typical flow conditions is 0.0003 feet/foot, and the hydraulic conductivity (K) is on the order of 500 ft/day. Assuming an effective porosity (n) of 0.20, the average flow velocity (v) through the principal flow zone can be estimated from the Darcy flow equation [$v = (Ki)/n$] as 0.75 ft/day, or 275 ft/year.

3.2 Uppermost Aquifer

3.2.1 CCR Rule Definition

As defined in the federal CCR Rule (§257.53 Definitions):

- *Aquifer* means a geologic formation, group of formations, or portion of a formation capable of yielding usable quantities of groundwater to wells or springs.
- *Groundwater* means water below the land surface in a zone of saturation.
- *Uppermost aquifer* means the geologic formation nearest the natural ground surface that is an aquifer, as well as lower aquifers that are hydraulically interconnected with this aquifer within the facility's property boundary. Upper limit is measured at a point nearest to the natural ground surface to which the aquifer rises during the wet season.

3.2.2 Identified Onsite Hydrostratigraphic Unit

Consistent with the definition in the CCR Rule, the hydrostratigraphic unit identified as the uppermost aquifer in this case is the saturated granular outwash deposit that underlies the Rockport Plant property including the ash landfill. The top of this unit would be the typical



seasonal high water level of 372 feet, approximately 18 feet below the lowest CCR elevation of 390 feet.

The bottom of the unit would be the top of bedrock. The shale bedrock underlying the granular outwash deposits does not represent a significant groundwater flow zone. The bedrock surface is expected to be irregular, generally sloping to the southeast, and to occur at elevations between 286 feet (at the southern landfill perimeter) and 371 feet (at a localized bedrock high in the vicinity of MW-5). The saturated thickness of this unit, therefore, is expected to range from 1 to 86 feet, thickening to the southeast.

3.3 Review of Existing Monitoring Network

3.3.1 Overview

Monitoring wells have been installed at 19 locations in or close to the landfill over a period of 30 years since the landfill began operations. Of those, two (located in the currently active area) have been abandoned to accommodate landfill expansion. At most locations, more than one well has been installed, most often as separate wells in a vertical cluster to monitor shallow (S), intermediate (I) and deep (D) conditions in the uppermost aquifer. At some locations to the north, northwest and northeast of the landfill, the overburden is thinner, and the saturated thickness is insufficient to accommodate more than one or two vertical levels of groundwater monitoring in the uppermost aquifer.

Well locations are shown on the map in **Figure 3**. The following paragraphs provide a listing of the wells by date of installation, and a summary of current status:

- MW-1S/I/D, MW-2S/I/D, MW-3S/I, MW-4S/I, MW-5S/I, MW-6S, MW-7S/I, MW-8S/I, MW-9S, and MW-10S (a total of 19 wells in 10 locations) were the original wells installed to monitor the landfill in 1984. No logging of subsurface materials was performed at the time of installation. Therefore, at the request of IDEM, stratigraphic borings were drilled near each well cluster in 1999 in order to establish the stratigraphy at each of the original monitoring locations. Of the original 10 well clusters, MW-3S/I and MW-4S/I have been abandoned and replaced with wells to the south. MW-8 is in an upgradient position relative to the other wells. The intermediate level well in the cluster (MW-8I) was added in 1992. The original well (MW-8S) experienced excessive siltation, and was abandoned and replaced with well MW-8SR in 2013. A total of 15 wells in 8 locations remain from this original group.
- MW-11S, MW-12S, MW-13S, MW-14S, MW-15S/I, MW-16S/I/D, and MW-17S/I/D (a total of 11 wells in 7 locations) were installed in 1992, to expand the monitoring network, in the sidegradient (MW-11S, MW-15S/I, MW-16S/I/D, and MW-17S/I/D), upgradient (MW-14S), and remote downgradient (MW-12S, MW-13S) directions.
- MW-18, MW-19, and MW-20 were installed in 2004, primarily for subsurface exploration and to serve as observation wells for the new supply well (PW-7) that was installed at that time. MW-18 is screened near the bottom of the aquifer (deep level), and MW-19 and



MW-20 are screened at the shallow level. They are relatively close together and are treated as a single monitoring location.

- The well cluster MW-21S/I/D was installed in 2009, as a replacement downgradient well location for the MW-3 and MW-4 locations that had to be abandoned due to landfill expansion.

All of these wells are constructed of 2-inch Schedule 40 PVC with factory slotted screens of nominal 10-foot length. Well construction details are summarized in **Table 1**, and well construction logs are provided in **Appendix C**. Well piezometric data are provided in **Appendix D**.

3.3.2 Gaps in Monitoring Network

No gaps have been identified in the existing downgradient monitoring network for the landfill. The following 16 wells at six locations have been designated as downgradient water quality monitoring wells for the landfill going forward: MW-1S/I/D, MW-2S/I/D, MW-15S/I, MW-16S/I/D, MW-17S/I, and MW-21S/I/D. These wells are located closest to the landfill perimeter in sidegradient/downgradient directions, and are spaced 800 to 1,500 feet apart, as approved by IDEM. Based on location and past performance, these wells appear to provide sufficient density of coverage both horizontally and vertically to adequately monitor groundwater passing the waste boundary in the uppermost unit in all potential downgradient flow directions. The other more remote sidegradient and downgradient monitoring wells will continue to be used for piezometric monitoring and preparation of piezometric maps with flow direction arrows.

Currently, AEP uses an intrawell statistical method (approved by IDEM), to establish intrawell prediction limits (IWPLs) for each monitored parameter in each well, and to identify statistically significant increases (SSIs) in concentrations that may occur in individual wells. Using this method, concentration data from upgradient or background wells are not required as part of the analysis. AEP also monitors selected wells (specifically MW-8S, MW-8I and MW-5I) as indicators of water quality in groundwater that is upgradient of, and not impacted by, CCR in the landfill. However, a review of the available monitoring wells in the uppermost aquifer (excluding MW-5S and I, which are screened in bedrock), suggests that the number of upgradient wells available to characterize background groundwater quality could be insufficient for statistical purposes.

4.0 RECOMMENDED MONITORING NETWORK IMPROVEMENTS

4.1 General

In summary, the performance standard for groundwater monitoring systems in the CCR Rule (§257.91) states that the system should consist of a sufficient number of wells, installed at appropriate locations and depths, to yield groundwater samples from the uppermost aquifer that:

- Accurately represent the quality of background groundwater, and
- Accurately represent the quality of the groundwater passing the waste boundary of the CCR unit in the uppermost aquifer, and
- Monitor all potential contaminant pathways.



The following subsections provide recommendations for improvements to the existing monitoring network, to meet the performance standard summarized above.

4.2 Downgradient Monitoring Wells

The existing monitoring wells are located and constructed in a manner appropriate for monitoring groundwater quality at the landfill. As noted above (Section 3.3.2), 16 wells at six locations have been designated as downgradient water quality monitoring wells for the landfill going forward: MW-1S/I/D, MW-2S/I/D, MW-15S/I, MW-16S/I/D, MW-17S/I, and MW-21S/I/D. No new wells are recommended for downgradient monitoring.

4.3 Background Monitoring Wells

The following wells, located in an upgradient direction from the landfill (to the north-northwest) are appropriate wells for monitoring background groundwater quality: MW-8SR, MW-8I and MW-14S. It is recommended that the upgradient monitoring network be augmented with additional wells located to the northeast, MW-6S and MW-11S. Although not directly upgradient, these wells are remote from the CCR in the landfill, and piezometric data indicate they are installed in the principal flow zone. Therefore, the addition of these two wells to the background groundwater monitoring network is appropriate for determining the full range of background concentrations for the parameters required to be monitored under the CCR Rule. Three wells (MW-6S, MW-11S, and MW-14S) were re-developed by AEP in 2016, between March 30 and April 1.

It is recommended that the background monitoring network be expanded to include the four locations (five wells) listed above. No new wells are recommended for upgradient monitoring.

4.4 Vertical Screening Levels

The saturated thickness of the principal flow zone is relatively thin in the upgradient direction from the landfill, which serves to limit the number of wells needed to monitor the vertical dimension of the uppermost flow zone.

The depth to bedrock at the MW-8 location is just under 70 feet (at elevation 323 feet), and the saturated thickness is on the order of 50 feet. Two wells, each with 10 feet of screen, are currently installed at the MW-8 location: MW-8SR (screened approximately between elevations of 351 and 361 feet) and MW-8I (screened approximately between elevations of 327 and 337 feet).

The depth to bedrock at the MW-14 location is even shallower (just under 35 feet BGS, at elevation 358 feet), and the saturated thickness is 8 to 15 feet. One well screen (MW-14S, screened between 361 and 371 feet) is sufficient to monitor the relatively thin flow zone at this location.

The depth to bedrock at the MW-11 location is 49 feet (at elevation 348 feet), and the saturated thickness is 18 to 24 feet. One well, MW-11S (screened approximately between elevations of 359 and 368 feet) monitors this location.



The bedrock elevation at the MW-6S location is estimated to be 310 feet based on Drawing 12-30095 in Appendix B (no lithologic log available). One well is present at this location, screened at the shallow level (between 353 and 363 feet).

4.5 Updated Well Survey


In a review performed in 2015 of the monitoring well construction logs and the data being used by AEP as reference point elevations (the level from which depth-to-water readings are measured) for piezometric monitoring, some discrepancies were noted. AEP surveyors performed a new survey of the ground surface and the reference point elevation at each well on 31 May 2016. **Table 1** is a well construction summary table that has been updated using the 2016 survey data. The well construction logs in **Appendix C** have also been annotated with the 2016 survey data for the reference points.

5.0 P.E. CERTIFICATION

By means of this certification, I certify that I have reviewed the available documents (discussed in this report) for the groundwater monitoring system at the existing CCR landfill at the AEP Rockport Plant located in Spencer County, Indiana, and have found that it meets the requirements in 40 CFR §257.91.



Nicholas G. Schmitt
Printed Name of Registered Professional Engineer

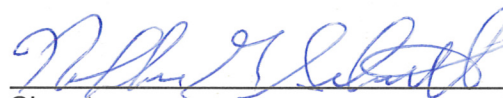
Signature


191576 Indiana 14 September 2017
Registration No. Registration State Date



6.0 REFERENCES

- American Electric Power Company (AEP), April 1984. *Application Package for Construction/Operating Permit for Solid Waste Management Facilities for Indiana and Michigan Electric Company's Ash Disposal Landfill for the Rockport Plant*. Submitted to Indiana Environmental Management Board. (AEP 1984).
- Grove, Glenn E., May 2006. *Bedrock Aquifer Systems of Spencer County, Indiana*. Indiana Department of Natural Resources (IDNR) map. (Grove, 2006).
- Ray, Louis L., 1965. *Geomorphology and Quaternary Geology of Owensboro Quadrangle, Indiana and Kentucky*. U.S. Geological Survey (USGS) Professional Paper 488, 72 p. (Ray 1965).
- Terracon Consulting Engineers and Scientists, February 2012. *Fly Ash Landfill Redesign Construction Drawings, Storage Area 1A, RKP Permit #FP-74-2*. Design drawings prepared for AEP Indiana Michigan Power Company, Rockport Plant. (Terracon 2012).
- United States Army Corps of Engineers (USACE), March 2014. *Ohio River Navigation Charts - Cairo, Illinois to Foster, Kentucky*. (USACE 2014)
- United States Department of Agriculture–Soil Conservation Service (USDA-SCS), 1973. *Soil Survey of Spencer County, Indiana*. (USDA 1973).

FIGURES

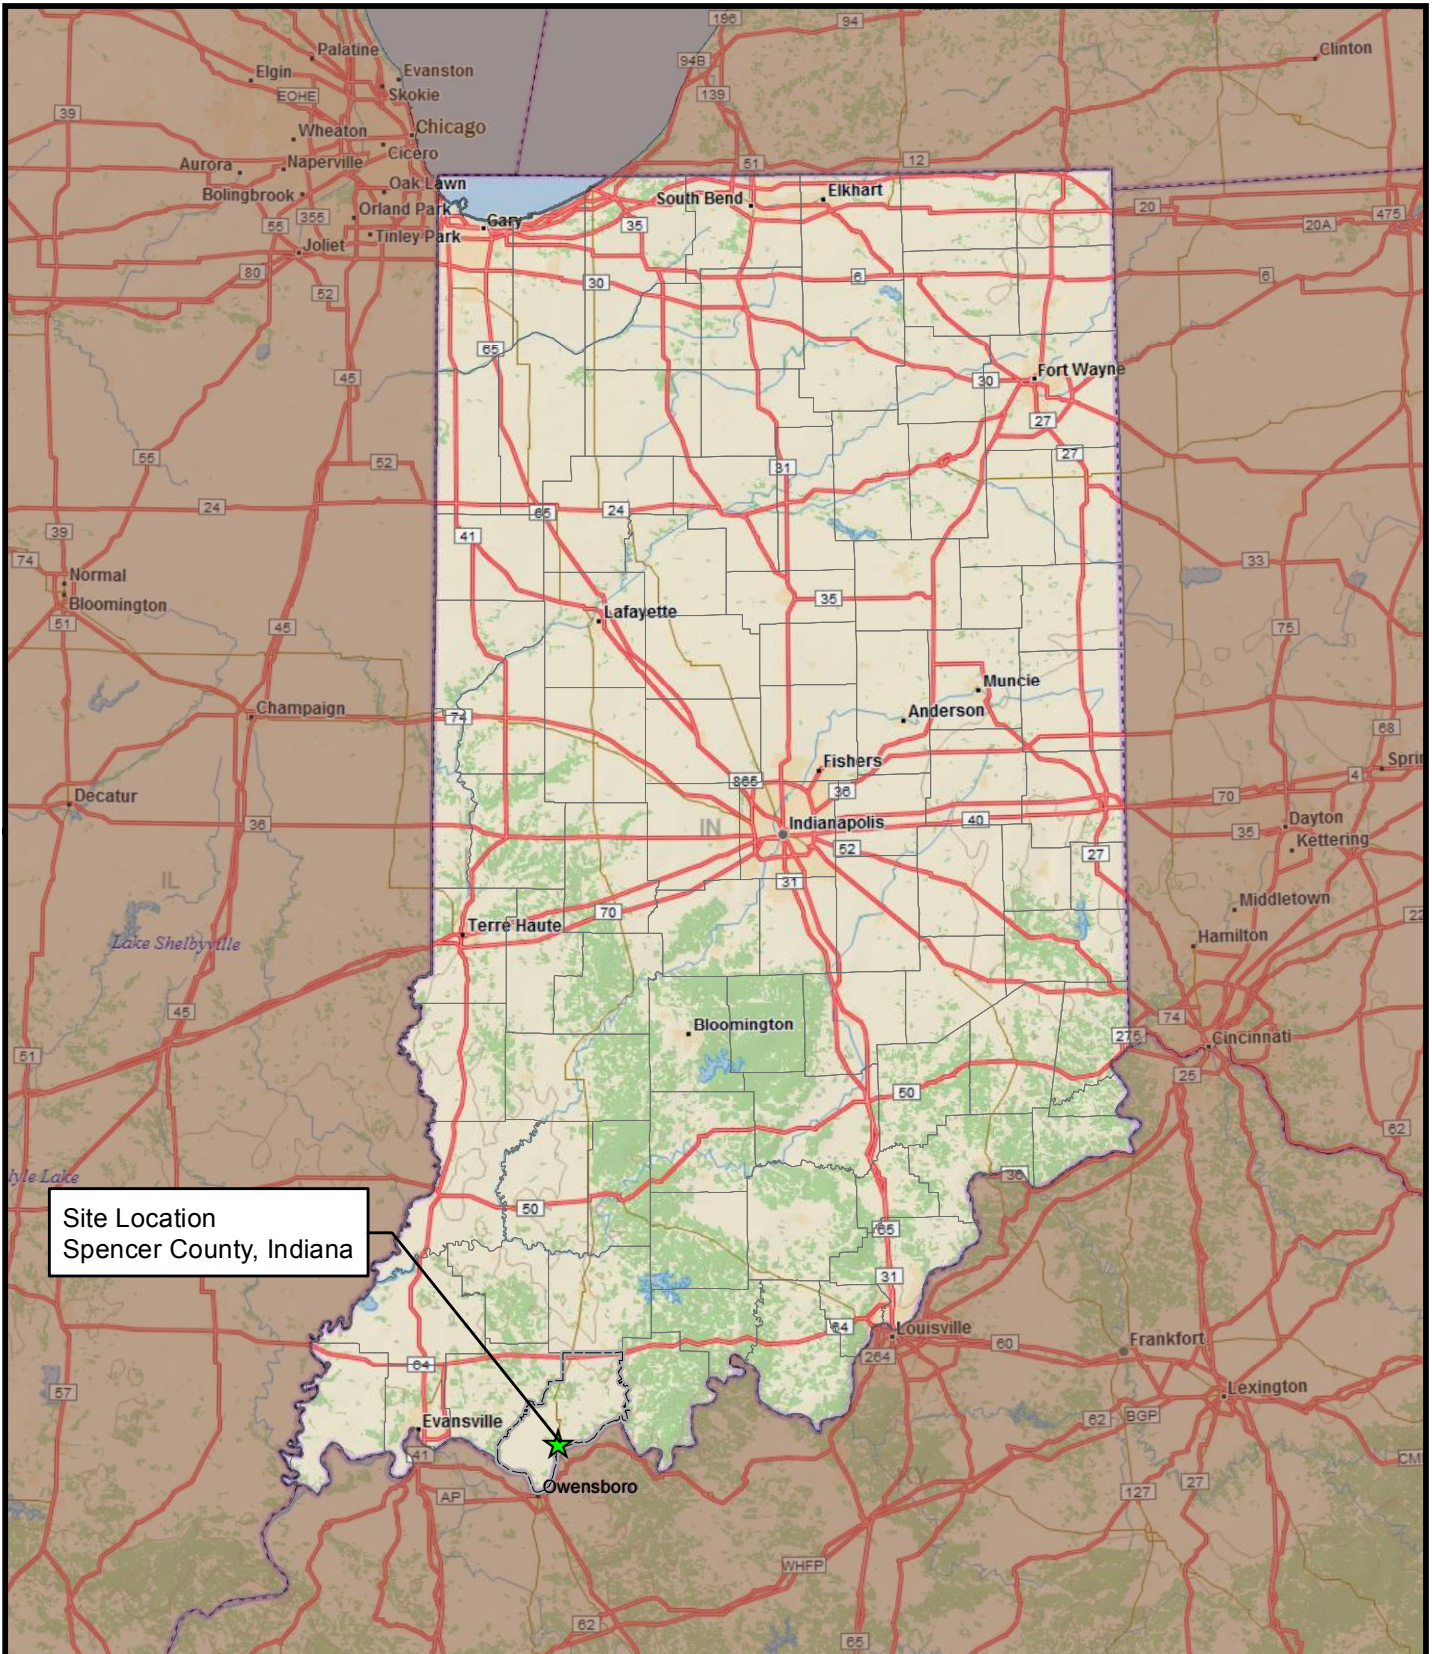

Site Location
Spencer County, Indiana



Legend
★ Site Location

Service Layer Credits: Copyright © 2015 DeLorme




2456 Fortune Drive, Suite 100
Lexington, Kentucky 40509
Phone: (859) 255-3308

SITE LOCATION MAP
American Electric Power, Rockport Plant
Rockport, Indiana

PROJECT NUMBER: 7382153161

SCALE	1" = 40 miles
DATE	9/11/2015
DRAWN BY	TMR
APPROVED BY	ALD

FIG. 1

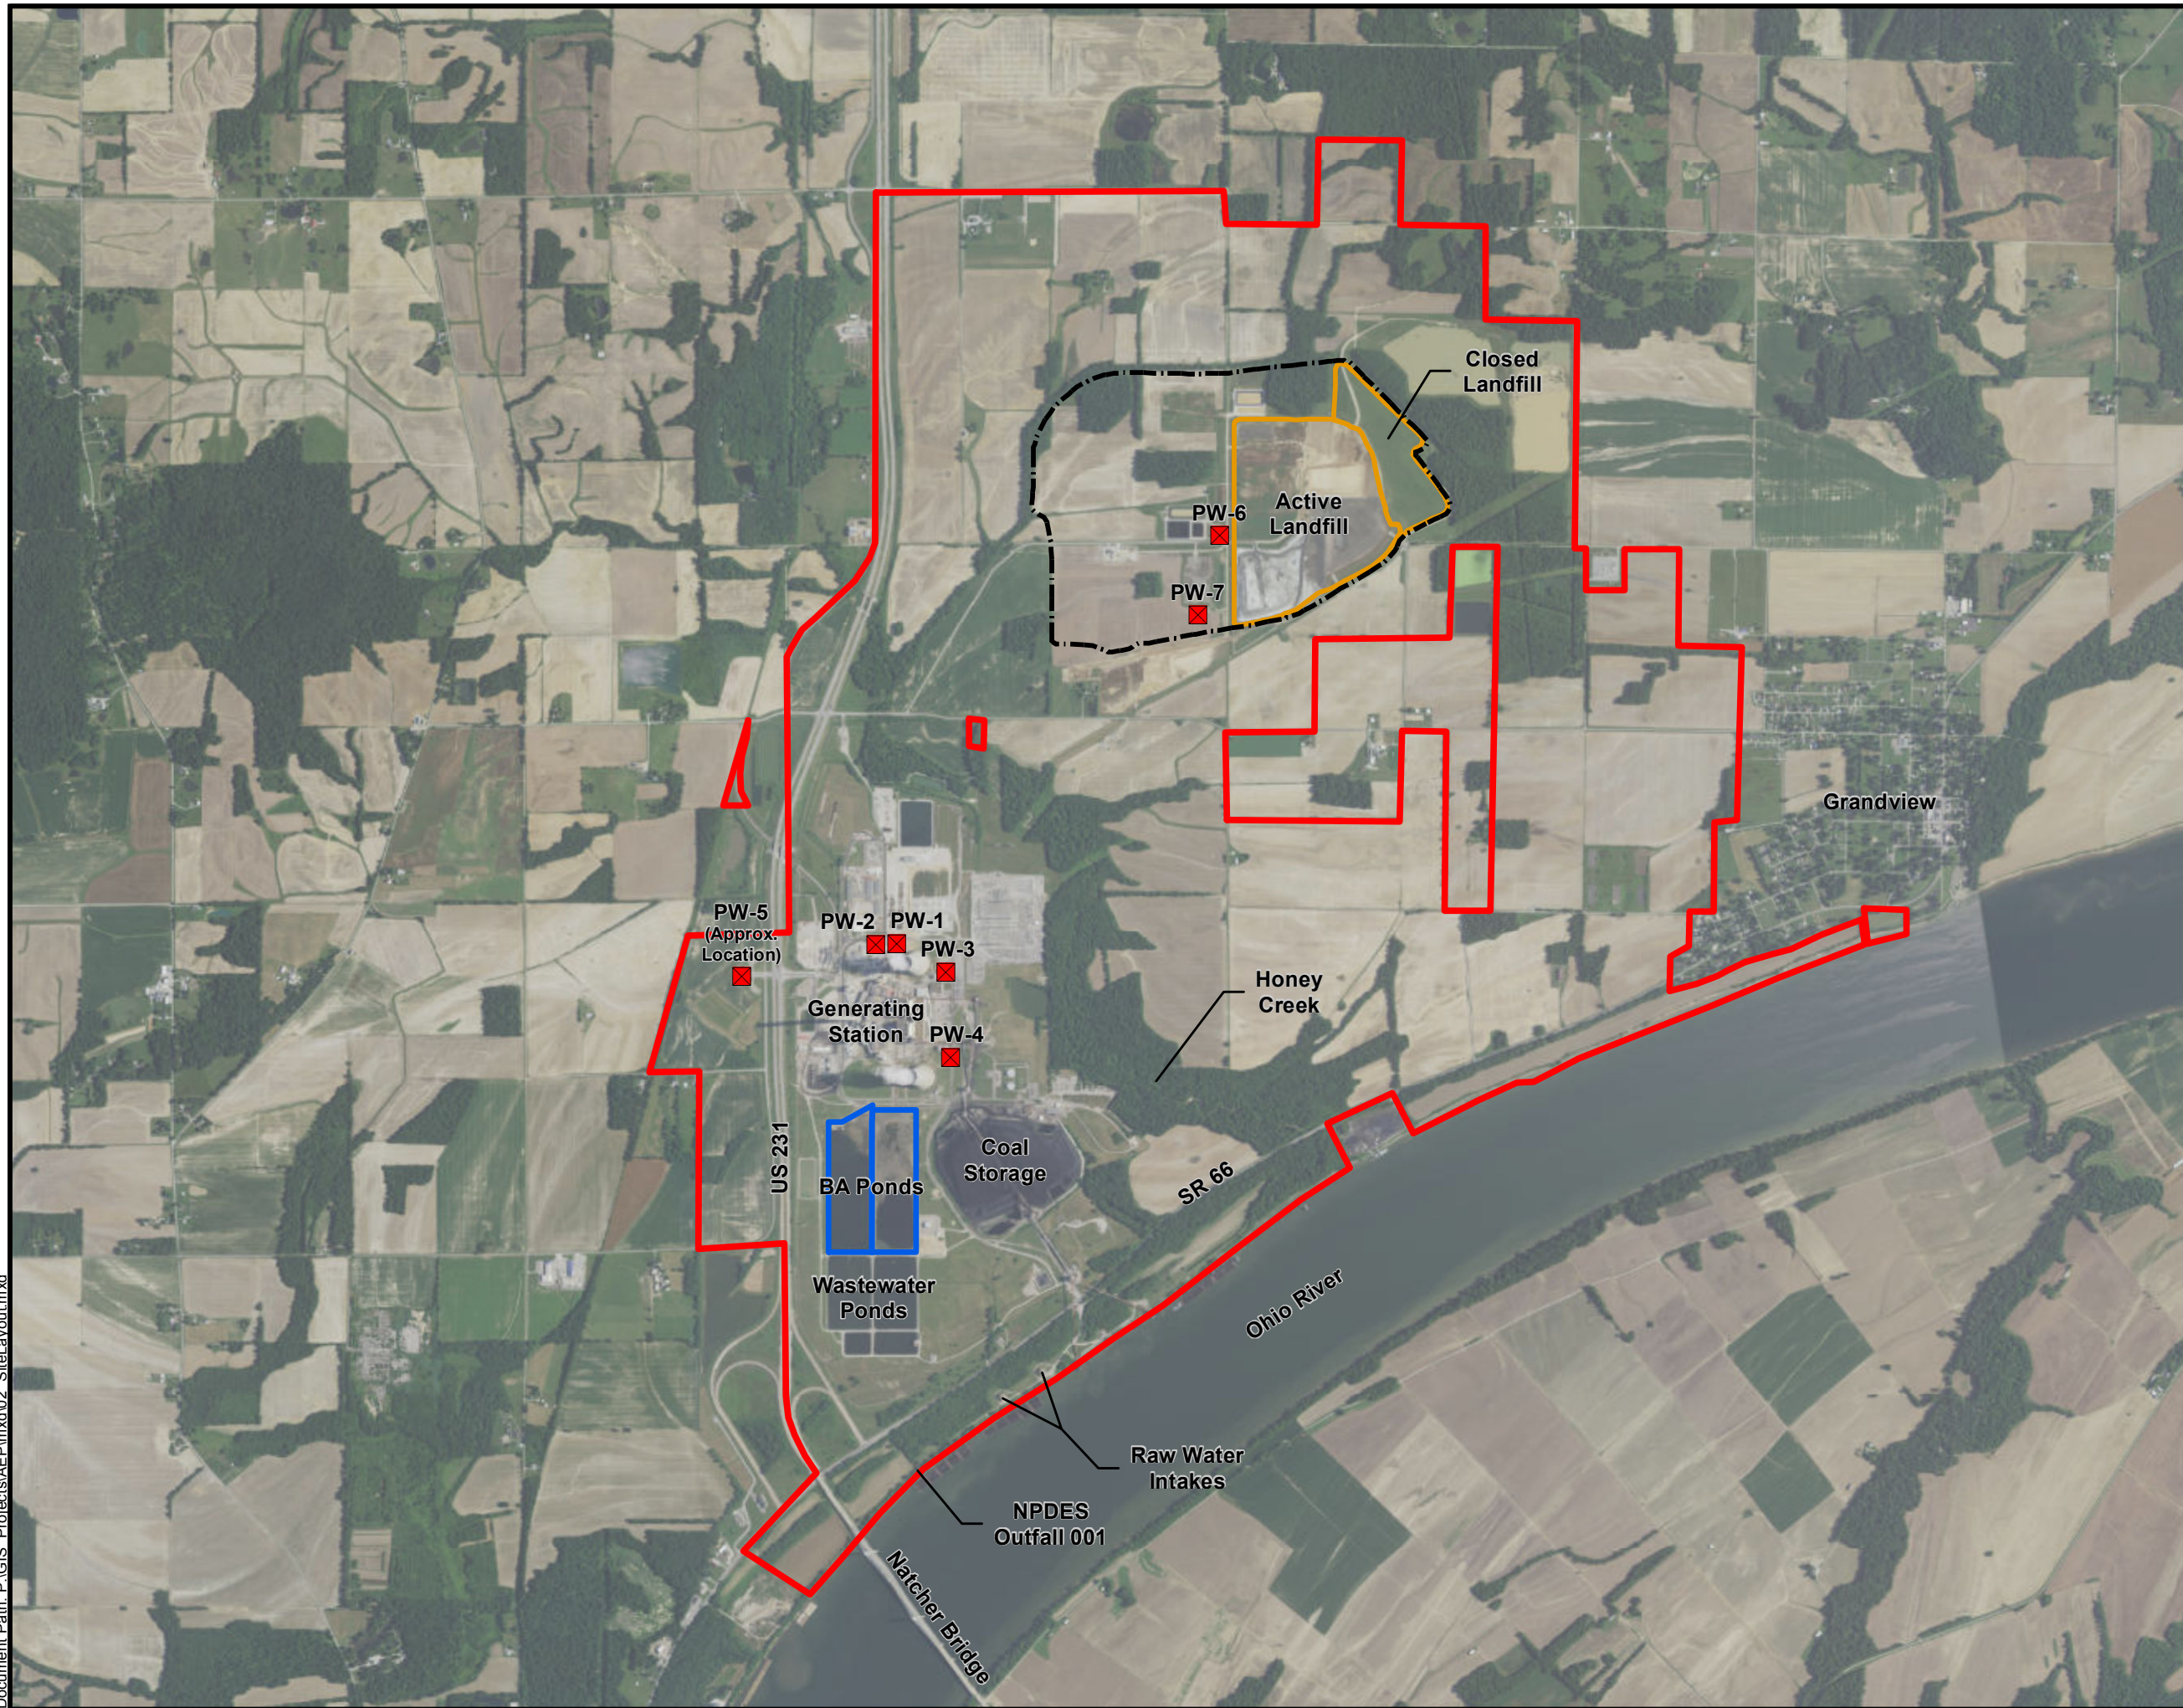

Legend

- Property Boundary
- 1984 Landfill Permit Boundary (Area 1)
- Landfill Area 1A (Active and Closed)
- Bottom Ash Pond
- ✖ Water Supply Well

Data Sources

Service Layer Credits: Source: Esri, DigitalGlobe, GeoEye, Earthstar Geographics, CNES/Airbus DS, USDA, USGS, AEX, Getmapping, Aerogrid, IGN, IGP, swisstopo, and the GIS User Community


Date of Photography: May-June 2016
 Source of Photography: U.S. Department of Agriculture, National Agriculture Imagery Program (NAIP)

0 1,200 2,400
 SCALE IN FEET

SITE LAYOUT MAP
 AEP - ROCKPORT, IN
 PROJECT NUMBER: 7382153161

SCALE	1" = 2,400'	FIG. 2
DATE	9/13/2017	
DRAWN BY	TMR	
APPROVED BY	ALD	

2456 Fortune Drive, Suite 100
 Lexington, Kentucky 40509
 Phone: (859) 255-3308

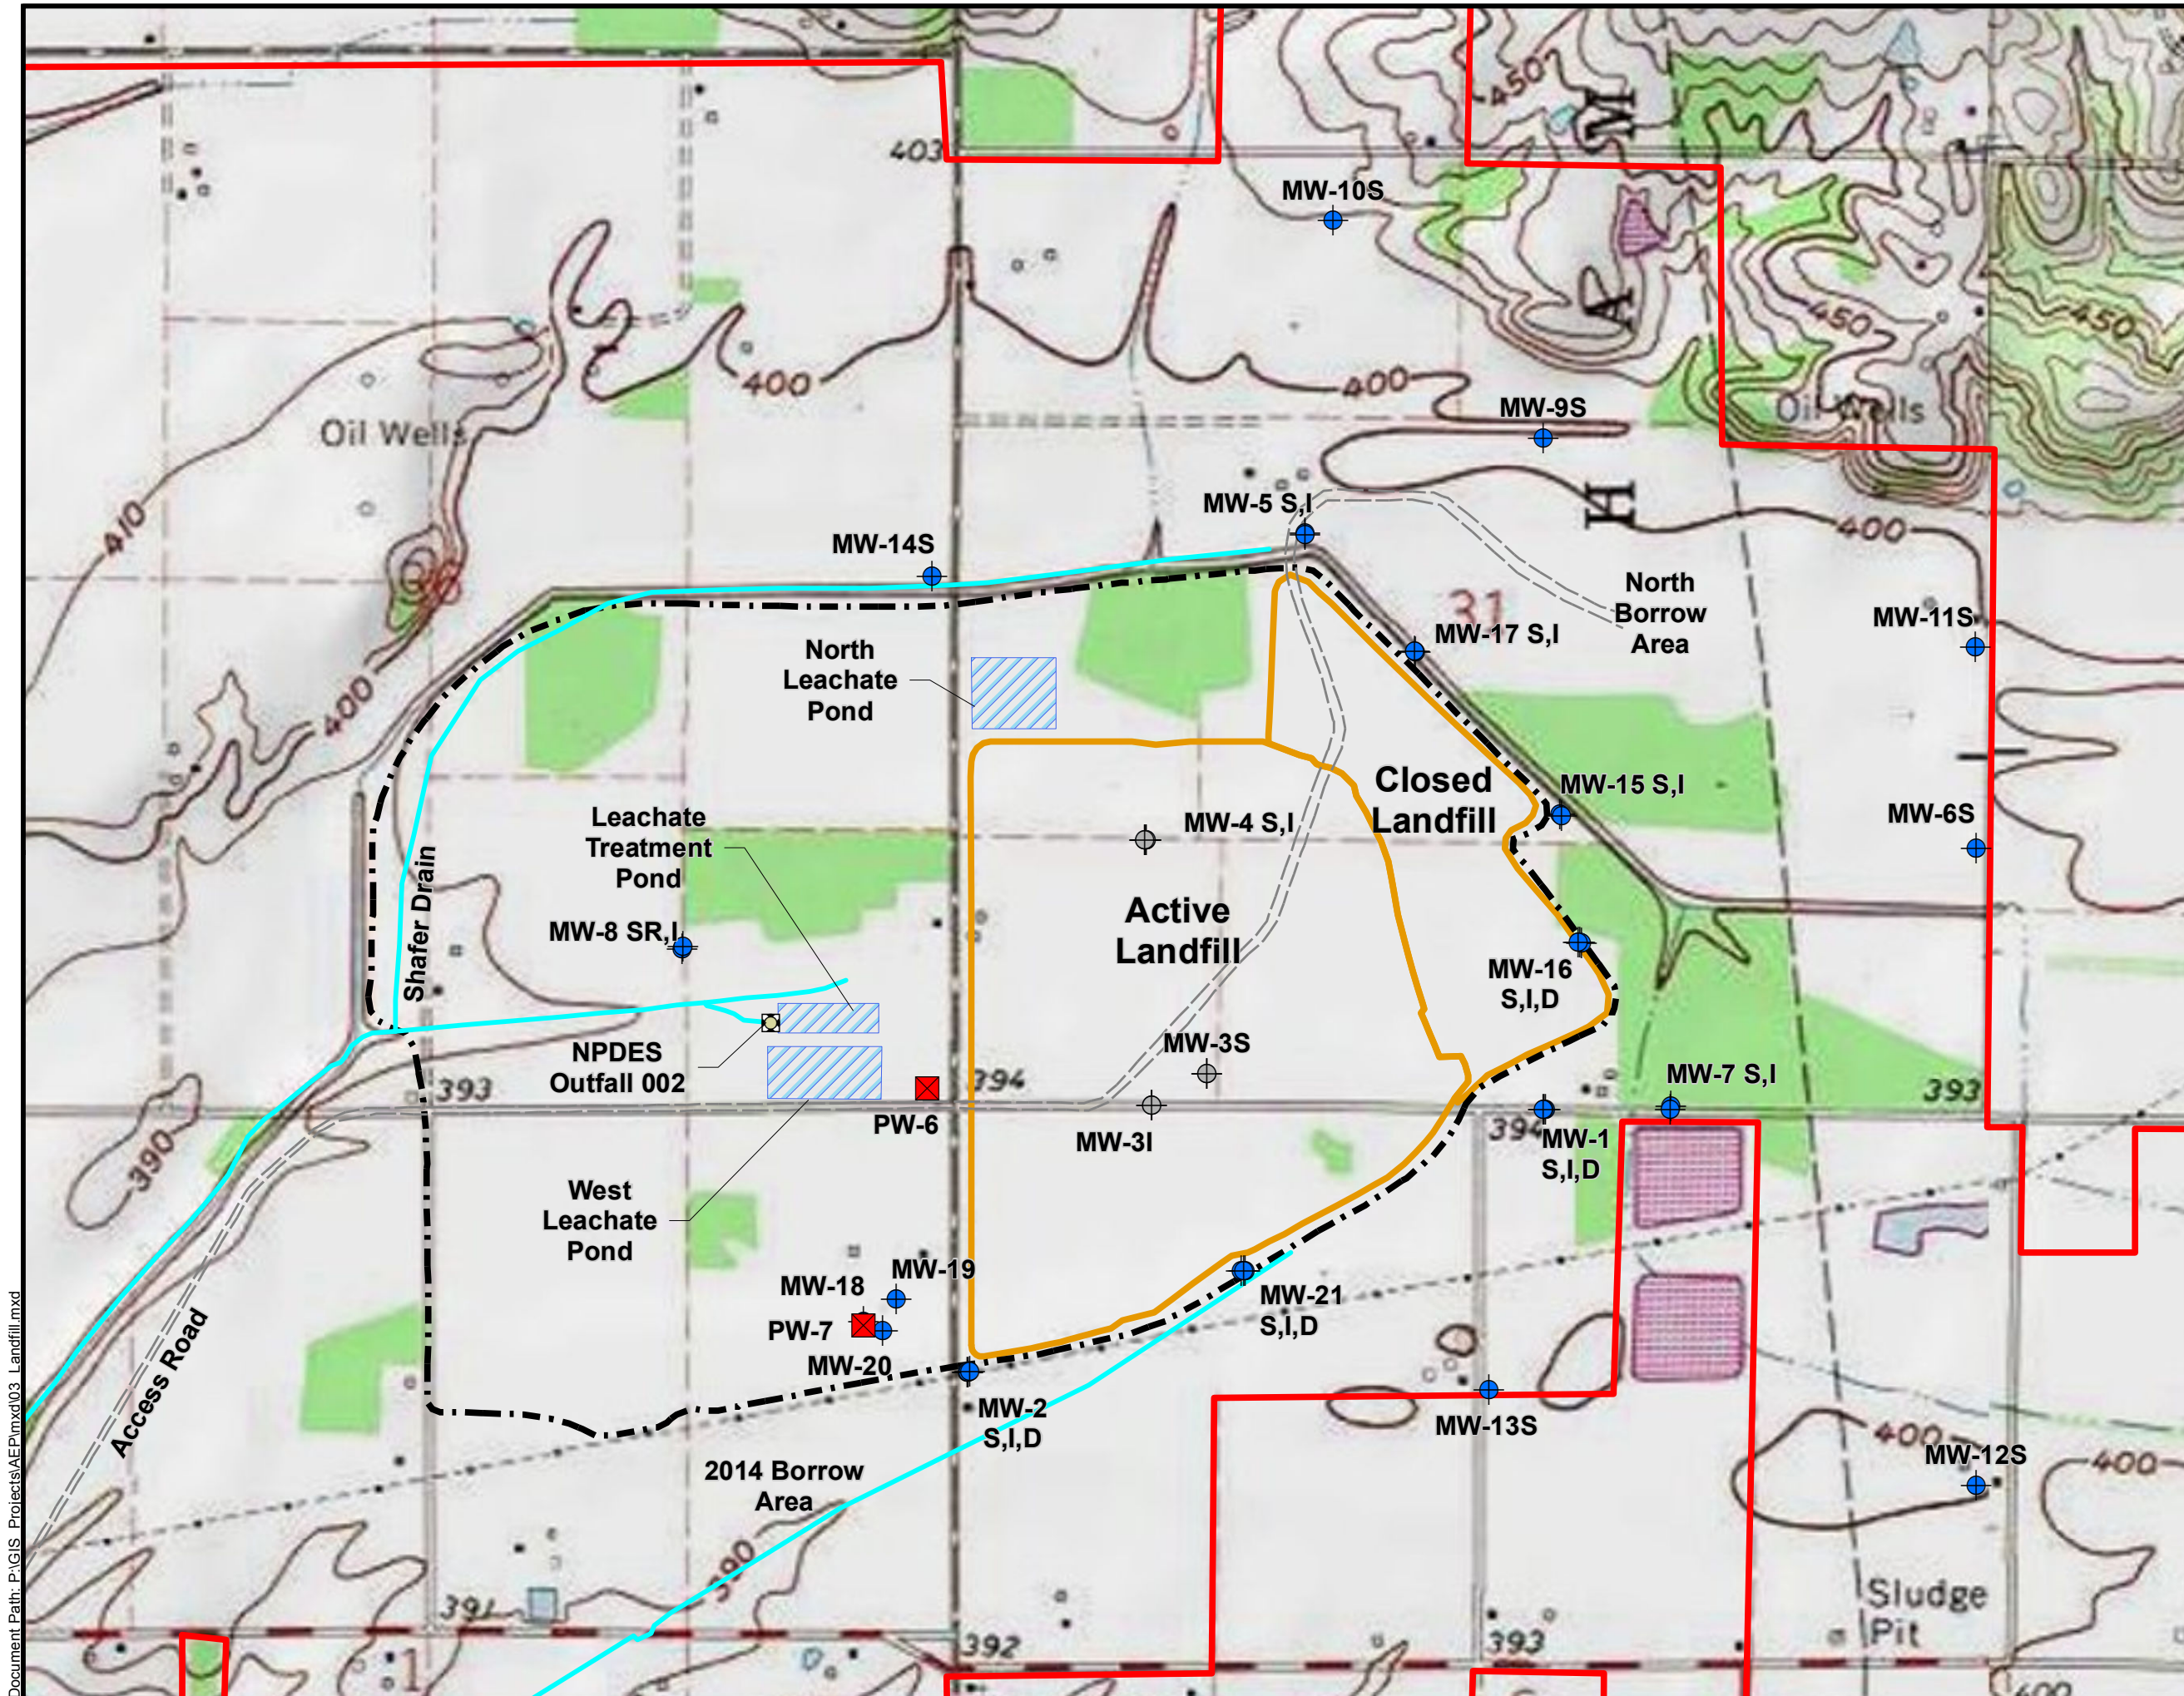


- Legend**
- NPDES Outfall 002
 - Monitoring Well (Abandoned)
 - Monitoring Well
 - Water Supply Well
 - Access Road
 - Drains / Ditches
 - Property Boundary
 - 1984 Landfill Permit Boundary (Area)
 - Landfill Area 1A (Active and)
 - Leachate Ponds

Data Sources

Service Layer Credits: Copyright © 2013 National Geographic Society, i-cubed

Source: USGS Rockport and Lewisport (IN/KY) Topographic Quadrangle Maps, 1964, photorevised 1982

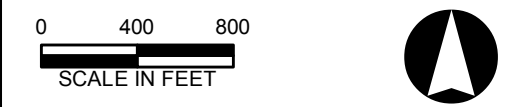


LANDFILL LAYOUT
AEP - ROCKPORT, IN
PROJECT NUMBER: 7382153161

SCALE	1" = 800'
DATE	10/5/2015
DRAWN BY	TMR
APPROVED BY	ALD

FIG. 3

2456 Fortune Drive, Suite 100
Lexington, Kentucky 40509
Phone: (859) 255-3308

Document Path: P:\GIS Projects\AEP\mxd\03_Landfill.mxd

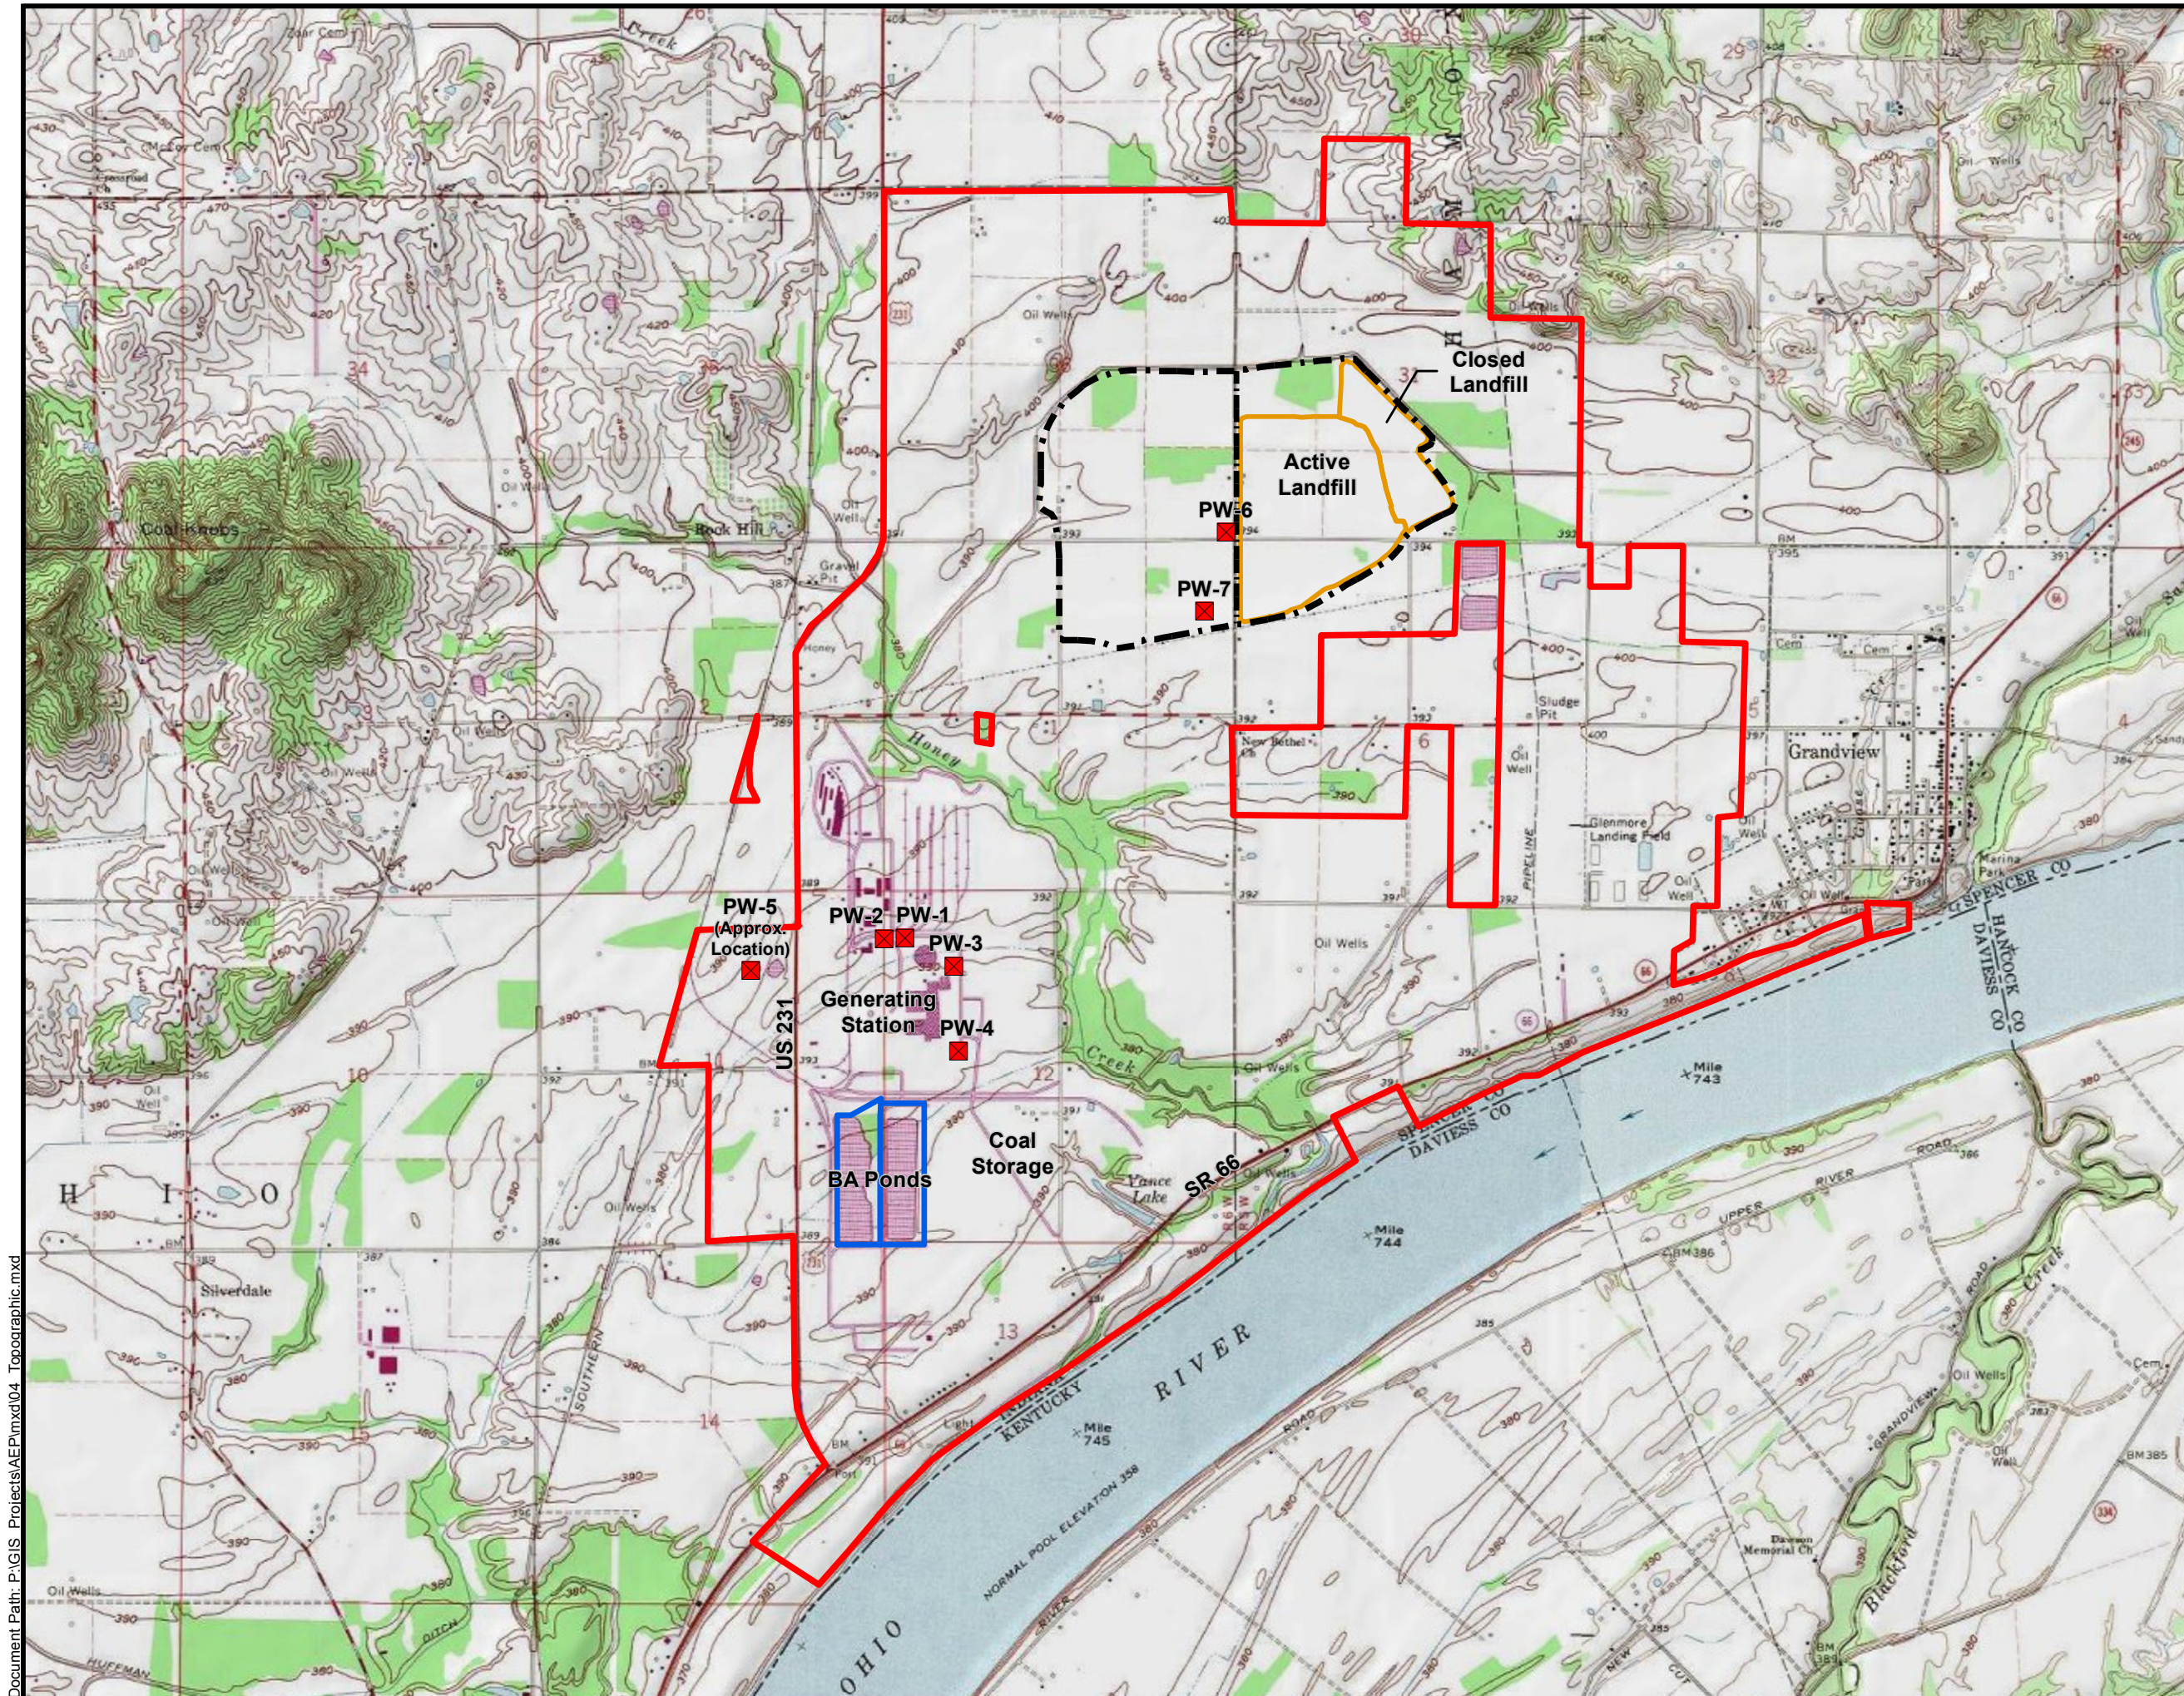


- Legend**
- Property Boundary
 - 1984 Landfill Permit Boundary (Area 1)
 - Landfill Area 1A (Active and Closed)
 - Bottom Ash Pond
 - Water Supply Well

Data Sources

Service Layer Credits: Copyright © 2013 National Geographic Society, I-cubed

Source: USGS Rockport and Lewisport (IN/KY) Topographic Quadrangle Maps, 1964, photorevised 1982

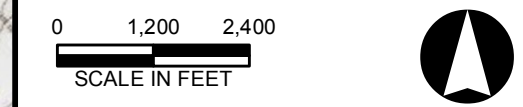


TOPOGRAPHIC MAP
AEP - ROCKPORT, IN
PROJECT NUMBER: 7382153161

SCALE	1" = 2,400'	FIG. 4
DATE	9/13/2017	
DRAWN BY	TMR	
APPROVED BY	ALD	

**amec
foster
wheeler**

2456 Fortune Drive, Suite 100
Lexington, Kentucky 40509
Phone: (859) 255-3308

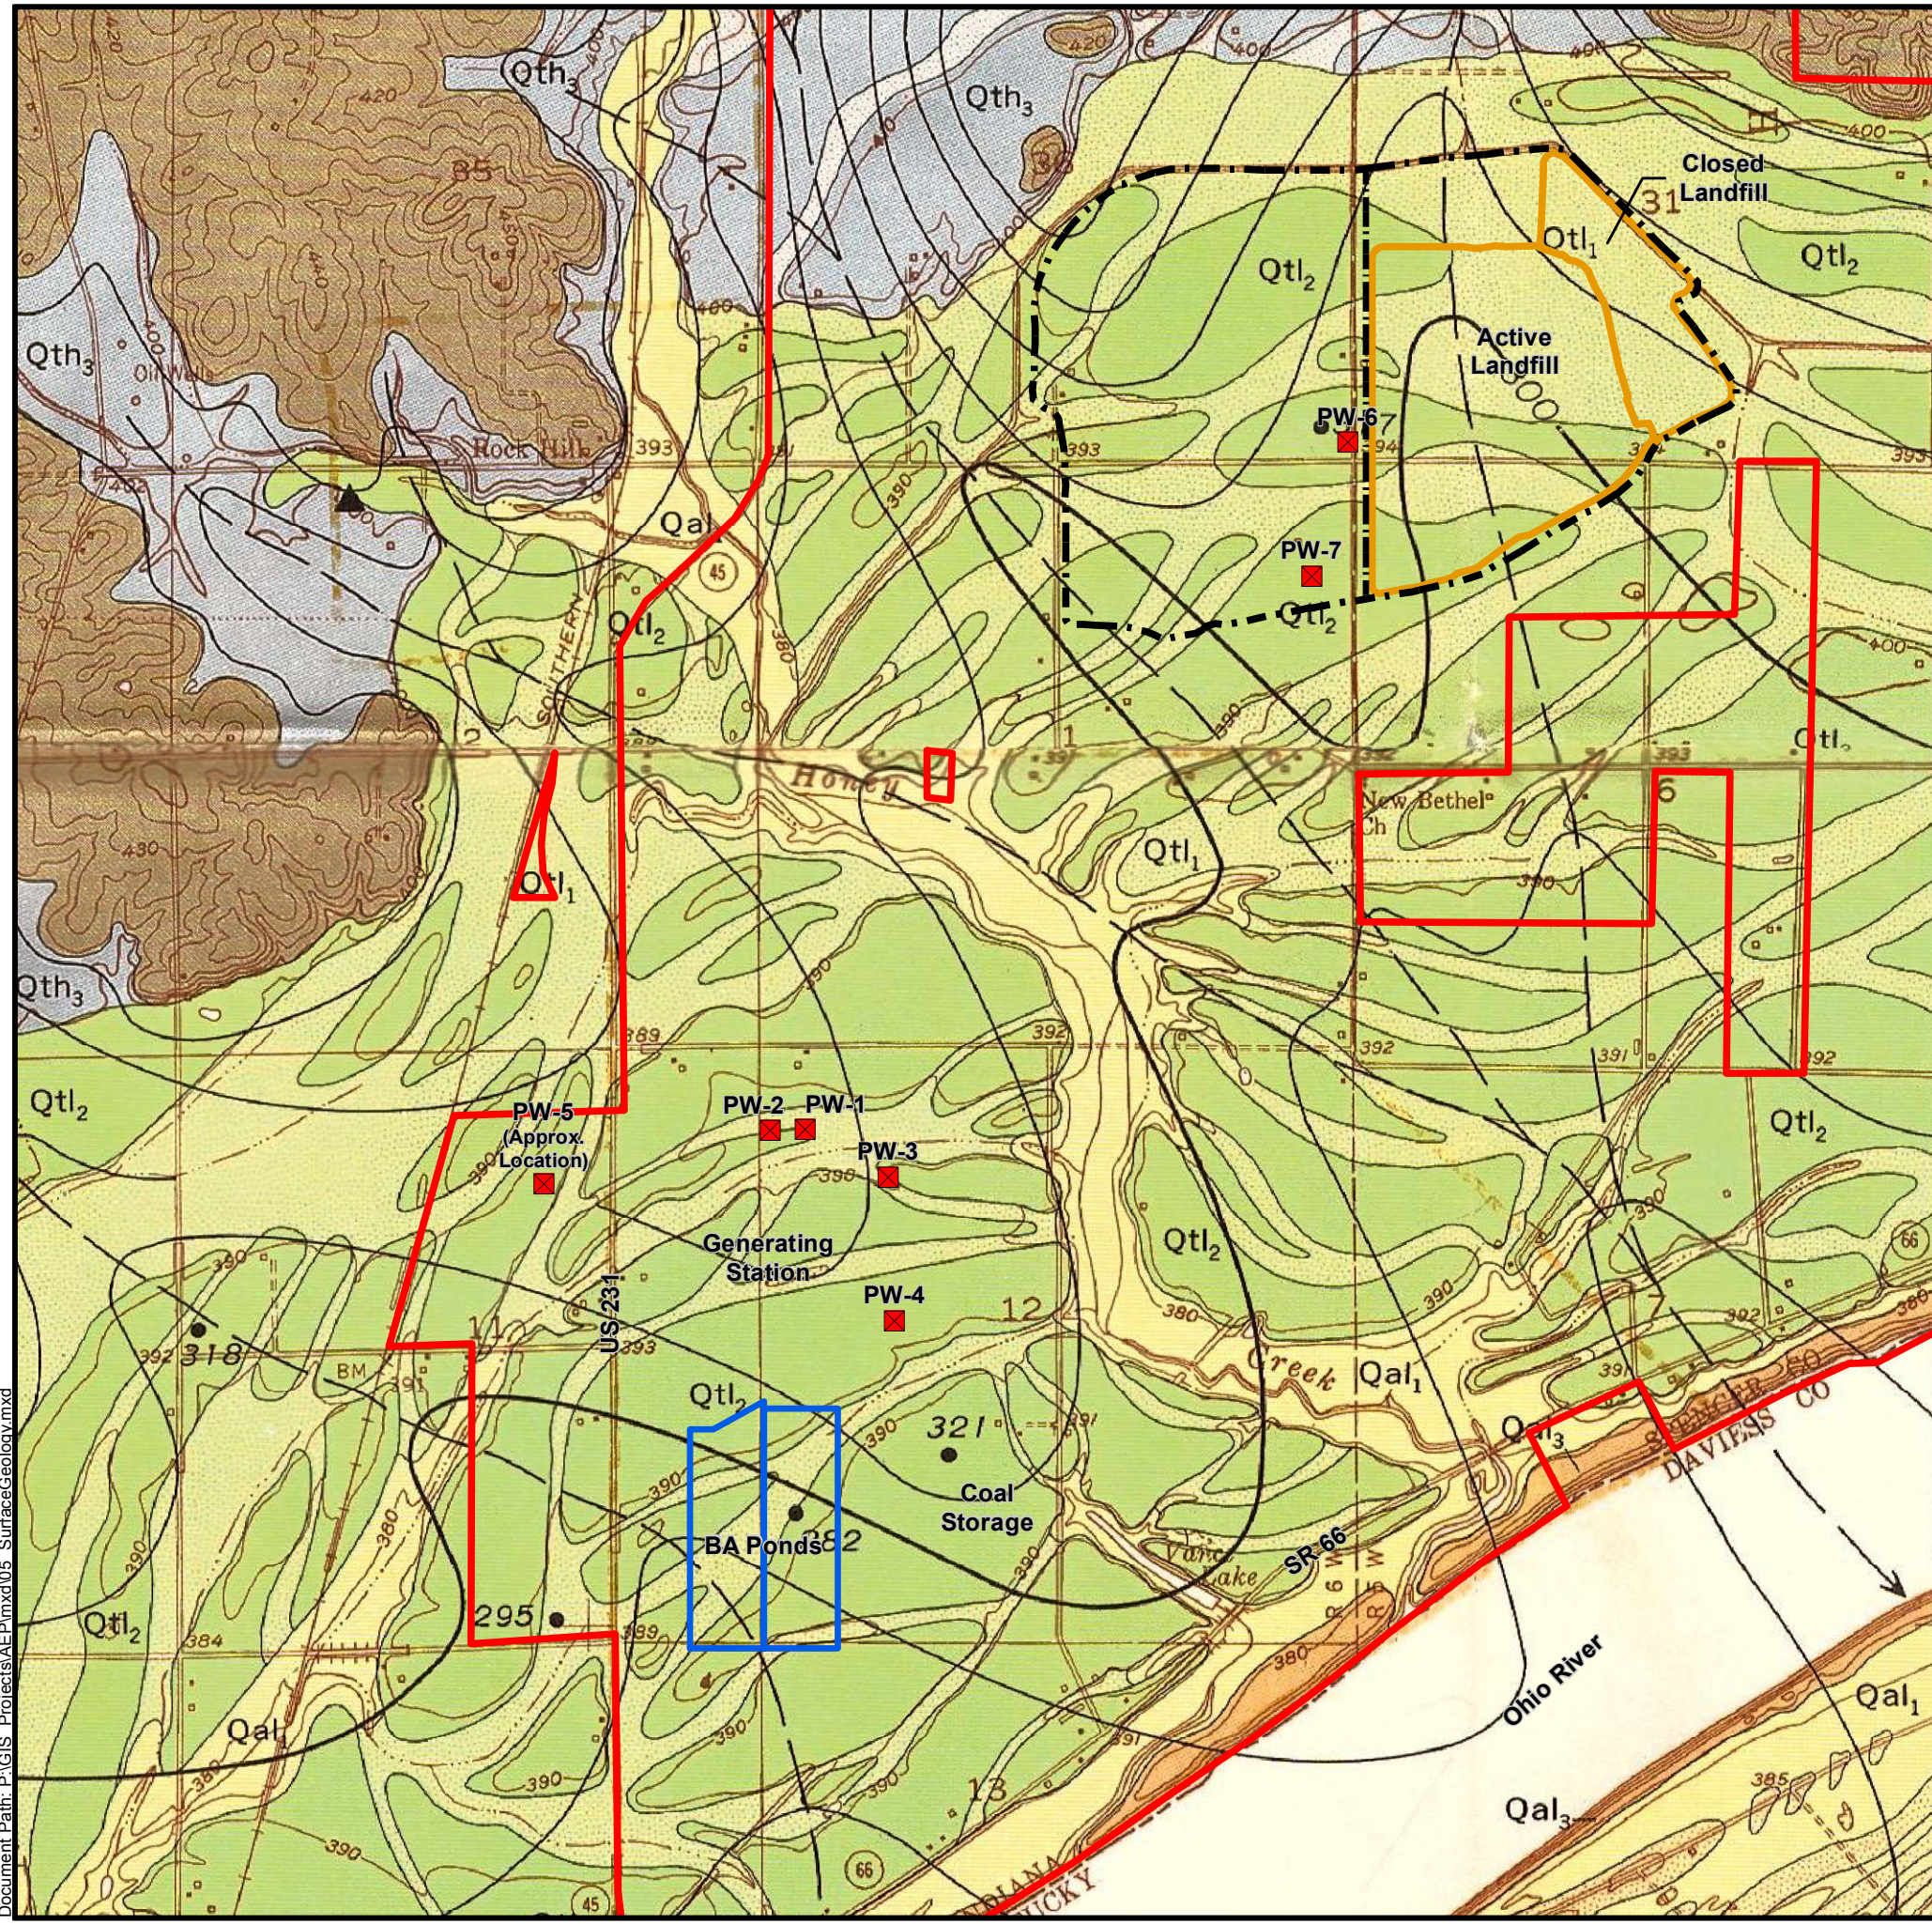

EXPLANATION

Qal ₁	Qal ₂	Qal ₃
Alluvium		
Sandy to clayey silt and scattered lenses and stringers of fine gravel; some humic clay. Overlies sand and gravel. Covered by flood waters on an average of every 1 to 2 years		
Qal ₁ , clayey silt in swales, sloughs, and channels on flood plain and along larger creeks; humic clay in boggy areas		
Qal ₂ , sandy silt on swells of river flood plain, especially on point bars		
Qal ₃ , sand and silt of natural levees		
Qtl ₁	Qtl ₂	
Valley-train deposits of low terrace and backwater clayey silt		
Sandy to clayey silts overlying fine gravel, sand, and silty clay. Frequently covered in whole or in part by flood waters		
Qtl ₁ , clayey silt in shallow swales; some humic clay in flood-scar channels		
Qtl ₂ , sandy silt of low swells; natural drainage better than in swales		
Qth ₁	Qth ₂	Qth ₃
Valley-train deposits of high terrace and related lacustrine clayey silt		
Sandy and clayey silts overlying fine to coarse sand and gravel. Not subject to flooding except where surface is reduced by erosion		
Qth ₁ , clayey to fine-sandy silt in shallow swales		
Qth ₂ , sandy well-drained silt of low swells		
Qth ₃ , clayey, fossiliferous, lacustrine clayey silt; humic in Willow Pond bed. Generally leached to depth near 3 feet; secondary calcareous nodules commonly abundant below depth of leaching		
Qd ₁		
Dune sand		
Loess-mentled ridges and low dunes of fine calcareous sand, in places leached in upper part; rarely fossiliferous		
Qh		
Beds at Hubert Court		
Fine silty sand overlain by clayey, humic, fossiliferous silts and silty clay		
Ql		
Loess undifferentiated		
Clayey silt up to 30 feet or more thick; mantles hill lands of bedrock of Pennsylvanian age and dunes; fossiliferous where unleached. Normally consists of Tazewell Loess overlying Farmdale Loess; some sections include deeply weathered Loveland Loess at base		
Qg		
Loess Gravel		
Cherty bronzed gravel with some vein quartz and jasper; in places cemented by iron oxides. Generally subrounded to well-rounded and bedded. White, orange, and red sand containing stringers and scattered gravel lenses		
Contact		
Subsurface contour lines on bedrock		
Datum is mean sea level. Contour interval 20 feet		

Legend

- Property Boundary
- 1984 Landfill Permit Boundary (Area 1)
- Landfill Area 1A (Active and Closed)
- Bottom Ash Pond
- Water Supply Well

Data Sources

Source: Geologic Map of the Owensboro Quadrangle, Indiana and Kentucky, USGS Professional Paper 488, 1965

0 800 1,600
SCALE IN FEET

SURFACE GEOLOGY MAP
AEP - ROCKPORT, IN
PROJECT NUMBER: 7382153161

SCALE	1" = 1,600'	FIG. 5
DATE	9/13/2017	
DRAWN BY	TMR	
APPROVED BY	ALD	

amec foster wheeler
2456 Fortune Drive, Suite 100
Lexington, Kentucky 40509
Phone: (859) 255-3308

TABLE

**Table 1
Monitoring Well Construction Details, Landfill Wells
AEP Rockport Plant, Rockport, Indiana**

Well ID	Date Installed	Northing SPCS NAD27 IN West MW Log (ft)	Easting SPCS NAD27 IN West MW Log (ft)	Original Ground Surface Elevation MW Log (ft MSL)	Original Reference Point Elevation MW Log (ft MSL)	Current Reference Point Elevation 5/31/2016 (ft MSL)	Length of Screen MW Log (ft)	Type of Screen MW Log (PVC)	Total Depth of Well MW Log (ft BGS)	Total Depth of Boring MW Log (ft BGS)	Depth to Top of Bedrock MW Log (ft BGS)	Top of Screen Elevation MW Log (ft MSL)	Bottom of Screen Elevation MW Log (ft MSL)	Bottom of Well Elevation MW Log (ft MSL)	Bottom of Boring Elevation MW Log (ft MSL)	Bedrock Elevation MW Log (ft MSL)	Comments
MW-1S	4/25/1984	162107.2	521813.6	394.65	397.25	397.33	9.0	2" x 0.010"	39.5	39.5	---	365.2	356.2	355.2	355.2	---	
MW-1I	4/25/1984	162107.0	521807.6	394.44	397.34	397.45	9.0	2" x 0.010"	63.1	63.1	---	341.3	332.3	331.3	331.3	---	
MW-1D	4/24/1984	162106.6	521802.0	394.68	397.32	397.25	9.0	2" x 0.010"	87.7	110.2	110	317.0	308.0	307.0	284.5	284.7	Lithologic boring log 9901 (drilled in April 1999)
MW-2S	5/16/1984	160790.3	518916.4	397.80	399.24	399.27	9.0	2" x 0.010"	40.0	40.0	---	368.8	359.8	357.8	357.8	---	
MW-2I	5/15/1984	160791.1	518924.0	397.76	399.26	399.42	9.0	2" x 0.010"	63.0	63.0	---	344.8	335.8	334.8	334.8	---	
MW-2D	5/15/1984	160793.0	518930.9	397.25	399.28	399.37	9.0	2" x 0.010"	88.0	107.8	107.8	319.3	310.3	309.3	289.5	289.5	Lithologic boring log 9902 (drilled in April 1999)
MW-3S	5/2/1984	162287.4	520118.1	393.53	396.81	---	9.0	2" x 0.010"	40.0	40.0	---	363.5	354.5	353.5	353.5	---	Closed and grouted
MW-3I	5/16/1984	162125.2	519843.6	395.15	397.05	---	9.0	2" x 0.010"	63.0	105.2	105.0	342.2	333.2	332.2	290.0	290.2	Closed and grouted, litho boring log 9903 (drilled in 1999)
MW-4S	5/9/1984	163459.8	519814.2	394.46	396.58	---	9.0	2" x 0.010"	40.0	40.0	---	364.5	355.5	354.5	354.5	---	Closed and grouted
MW-4I	5/9/1984	163460.0	519805.5	395.01	397.02	---	9.0	2" x 0.010"	63.0	84.8	84.1	342.0	333.0	332.0	310.2	310.9	Closed and grouted, litho boring log 9904 (drilled in 1999)
MW-5S	5/10/1984	164993.0	520610.0	394.28	396.00	396.08	9.0	2" x 0.010"	35.2	35.2	21.0	369.1	360.1	359.1	359.1	371	Lithologic boring log 9909 (drilled in April 1999)
MW-5I	5/22/1984	164987.9	520610.6	392 (est)	---	394.17	10.0	2" x 0.010"	40.0	58.6	21.0	362	352	352	334	371	GSE not shown on MW Log, shown as 392.1 on litho log
MW-6S	5/17/1984	163414.6	523969.1	392.85	394.89	394.72	9.0	2" x 0.010"	40.0	40.0	---	362.8	353.8	352.8	352.8	---	no lithologic log
MW-7S	5/1/1984	162123.6	522443.5	390.81	393.66	393.70	9.0	2" x 0.010"	40.0	40.0	---	360.8	351.8	352.8	350.8	---	
MW-7I	5/24/1984	162104.9	522439.6	392.02	393.62	393.49	9.0	2" x 0.010"	63.0	63.0	---	339.0	330.0	329.0	329.0	---	no lithologic log
MW-8S	5/8/1984	162926.4	517492.5	389.81	391.9	---	9.0	2" x 0.010"	39.8	39.8	---	360.0	351.0	350.0	350.0	---	Closed and grouted
MW-8SR	10/30/2013	162910.5	517492.0	392.15	394.66	394.86	9.6	2" x 0.010"	41.1	42.0	---	361.3	351.7	351.1	350.2	---	
MW-8I	11/14/1992	162921.3	517496.0	391.78	393.71	393.52	9.0	2" x NS	65.7	65.7	69.5	336.1	327.1	326.1	326.1	322.3	Lithologic boring log 9244
MW-9S	5/23/1984	165472.1	521801.1	401.04	403.08	404.35	9.0	2" x 0.010"	24.0	44.9	29.0	387.0	378.0	377.0	356.1	372.0	Lithologic boring log 9909 (drilled in April 1999)
MW-10S	5/23/1984	166560.6	520751.6	406.22	408.41	409.16	9.0	2" x 0.010"	23.6	40.0	24.0	392.6	383.6	384.2	366.2	382.2	Lithologic boring log 9910 (drilled in April 1999)
MW-11S	11/16/1992	164421.0	523964.2	397.60	399.97	400.07	9.0	2" x NS	39.6	47.0	49.3	368.0	359.0	358.0	350.6	348.3	Lithologic boring log 9230
MW-12S	11/15/1992	160224.0	523969.0	401.57	403.45	403.58	9.0	2" x NS	55.1	119.8	---	356.5	347.5	346.5	281.8	---	Lithologic boring log 9231
MW-13S	11/17/1992	160702.3	521529.1	397.92	399.91	399.79	9.0	2" x NS	44.5	111.6	111.5	363.4	354.4	353.4	286.3	286.4	Lithologic boring log 9232
MW-14S	12/8/1992	164779.4	518743.8	392.52	394.45	394.78	9.0	2" x NS	32.0	36.4	34.5	370.5	361.5	360.5	356.3	358.0	Lithologic boring log 9234
MW-15S	11/13/1992	163585.0	521886.9	390.53	392.53	392.46	9.0	2" x NS	40.1	40.1	---	360.4	351.4	350.4	350.4	---	
MW-15I	11/13/1992	163578.2	521892.7	390.46	392.70	392.70	9.0	2" x NS	65.8	67.2	66.5	334.7	325.7	324.7	324.7	323.3	Lithologic boring log 9234
MW-16S	12/11/1992	162944.9	521986.6	392.49	394.38	394.35	9.0	2" x NS	38.9	38.9	---	363.6	354.6	353.6	353.6	---	
MW-16I	12/11/1992	162943.9	521995.5	392.64	394.37	394.26	9.0	2" x NS	67.7	67.7	---	334.9	325.9	324.9	324.9	---	
MW-16D	12/9/1992	162946.3	521978.3	392.53	394.47	394.38	9.0	2" x NS	99.7	102.7	101.6	302.8	293.8	292.8	289.8	290.9	Lithologic boring log 9243
MW-17S	11/1/1992	164398.6	521162.5	393.13	395.46	395.34	9.0	2" x NS	40.5	40.5	---	362.5	353.6	352.6	352.6	---	
MW-17I	11/1/1992	164404.4	521157.2	393.28	395.29	395.40	9.6	2" x NS	67.4	69.4	67.4	336.5	326.9	325.9	323.7	325.7	Lithologic boring log 9245
MW-18	10/26/2004	161048.3	518397.6	397.88	400.38	400.65	9.0	2" x 0.020"	109.2	110.5	110.3	298.18	289.2	288.7	287.4	287.6	Lithologic boring log MW-18
MW-19	11/4/2004	161159.0	518561.3	398.74	401.24	401.44	9.0	2" x 0.020"	50.8	50.8	---	358.4	349.4	348.7	347.9	---	Lithologic boring log MW-19
MW-20	11/3/2004	160996.7	518492.4	398.02	400.52	400.78	9.0	2" x 0.020"	51.0	51.0	---	357.2	348.2	347.5	347.0	---	Lithologic boring log MW-20
MW-21S	1/13/2009	161298.6	520310.8	398.57	400.76	400.77	10.5	2" x 0.020"	39.9	40.0	---	369.8	359.3	358.7	358.6	---	
MW-21I	1/13/2009	161299.5	520291.1	398.52	400.74	400.72	9.5	2" x 0.020"	63.2	63.2	---	345.4	335.9	335.3	335.3	---	
MW-21D	1/13/2009	161298.3	520300.3	398.62	400.78	400.67	9.5	2" x 0.020"	108.3	112.2	111.9	300.42	290.92	290.3	286.4	286.7	Lithologic boring log B-0821

Table 1
Monitoring Well Construction Details, Landfill Wells
AEP Rockport Plant, Rockport, Indiana

Notes:

	Abandoned (closed and grouted) before 2015
	To be used for downgradient monitoring at the landfill.
	To be used for upgradient monitoring at the landfill.

ft = feet

in = inches

BGS = below ground surface

MSL = above Mean Sea Level, equivalent to the National Geodetic Vertical Datum of 1929 (NGVD29)

NS = screen slot size not specified

SPCS NAD27 = State Plane Coordinate System, North American Datum of 1927

At several well locations, borings were drilled for lithologic definition, and one or more additional borings were drilled for well construction.

Total boring depth/elevation and bedrock depth/elevation for the deepest well in any location are based on the lithologic boring log (Litho Log) for that location.

Original ground surface and reference point elevations are the elevations reported on the AEP monitoring well construction log at the time of well installation (MW Log). Well elevations (top and bottom of screen, bottom of well) are as reported on the MW Log.

In some cases, the wellhead has been modified since installation, usually to install a dedicated pump, and the reference elevation has changed. Current reference point elevation is based on a survey performed by AEP on 5/31/2016.

APPENDICES

APPENDIX A
CURRENT LANDFILL PERMIT (2015)



INDIANA DEPARTMENT OF ENVIRONMENTAL MANAGEMENT

We Protect Hoosiers and Our Environment.

100 N. Senate Avenue • Indianapolis, IN 46204

(800) 451-6027 • (317) 232-8603 • www.idem.IN.gov

Michael R. Pence
Governor

February 10, 2015

Thomas W. Easterly
Commissioner

American Electric Power
Attn: Dana Sheets, P.E.
1 Riverside Plaza
Columbus, Ohio 43215

Dear Mr. Sheets:

Re: Solid Waste Land Disposal Facility
Permit Renewal
Rockport Plant RWS I
FP 74-02
Spencer County

American Electric Power's permit renewal for the Rockport Plant restricted waste site (RWS) type I landfill is approved. You, the permittee, must comply with Indiana's rules for solid waste land disposal facilities (329 IAC 10) and the terms of this permit. Your attention to the requirements for managing, containing, and disposing of waste and leachate protects public health and the environment in your community. Please feel free to contact us or your compliance inspector if you have any questions.

This permit will expire on **February 11, 2020**. To operate past this date, you must submit a renewal application on or before **October 14, 2019**.

The facility is a restricted waste site type I (RWS I) with a total of 554 acres. 408 of the acres approved for filling are in Area 1; 146 acres approved for filling are in Area 2. The landfill is located at 2791 N. U.S. Highway 231 near Rockport.

Public records for your facility are available in IDEM's Virtual File Cabinet at www.in.gov/idem. Documents related to this approval include the application dated May 2, 2014 (VFC #70151087).

You can review the Indiana Code (IC) and the Indiana Administrative Code (IAC) references in this document at iga.IN.gov. IC references are under the "Laws" link; IAC references are under the "Publications" link.

This permit does not: convey any property rights of any sort or any exclusive privileges; authorize any injury to any person or private property or invasion of other private rights or any infringement of federal, state, or local laws or regulations; or preempt any duty to comply with other state or local requirements (329 IAC 10-13-4(a)).



Please note, as the owner or operator of this facility, and owner of the land upon which it is located, you are liable for any environmental harm caused by the facility (329 IAC 10-13-4(b)).

If you do not comply with the requirements of this permit, IDEM may modify or revoke this permit (329 IAC 10-13-6) or initiate an enforcement action.

If you wish to appeal this decision you must file a request for administrative review with the Office of Environmental Adjudication within 18 days after the postmark of this letter. The enclosed Notice of Decision and Guide to Appeals Process notifies you of additional important details regarding the appeal process and your rights and responsibilities for filing an adequate and timely appeal.

If you have any questions, please contact Cara Kitchen, the permit manager assigned to your facility. She can be reached by dialing (800) 451-6027 and asking for extension 3-0449, by calling her directly at 317-233-0449, or by e-mail at ckitchen@idem.IN.gov.

Sincerely,



Jeffrey L. Sewell, Chief
Permits Branch
Office of Land Quality

Enclosures: Permit Requirements
Notice of Decision
Guide to Appeals Process
Letter to the The Spencer County Journal-Democrat
Letter to the Spencer County Public Library

cc with enclosures: Gibson County Health Department
Gibson County Commissioners
Gibson County Solid Waste Management District
Director, IDEM Southwest Regional Office
The Honorable Harold Goffinet, Mayor of Rockport
The Honorable Connie Hargis, President, Rockport Town Council

PERMIT REQUIREMENTS

- A. General Permit Requirements
- B. Construction Requirements
- C. Pre-operational Requirements
- D. Operational Requirements
- E. Ground Water Monitoring Requirements
- F. Closure Requirements
- G. Post-Closure Requirements
- H. Financial Responsibility for Closure and Post-Closure

A. GENERAL PERMIT REQUIREMENTS

- A1. The permittee must comply with 329 IAC 10 except where alternative specifications or requirements are noted in approved plans or in this permit.
- A2. The permittee must construct, operate, and maintain the facility as described in the approved plans and specifications. The permittee must request approval before modifying the facility or facility operating procedures. The permit modification application requirements are in 329 IAC 10-11. Application forms are available from the permit manager listed below.

Certain insignificant modifications defined in 329 IAC 10-2-97.1 are eligible for the streamlined notification or approval procedures described in 329 IAC 10-3-3.

- A3. The permittee must call **(888) 233-7745** (IDEM's emergency response line) as soon as possible after learning of any event that may cause an imminent and substantial endangerment to human health or the environment, such as a reportable spill (327 IAC 2-6.1) or a fire or explosion that requires the response of the local fire department.

The permittee must follow up with a written report to the IDEM contact given in Requirement A4 within 5 business days after the event. The report must describe the event, and actions taken or planned to correct the event and prevent its recurrence.

- A4. Unless otherwise noted, submittals must be sent to:

**Cara Kitchen, Permit Manager
Indiana Department of Environmental Management
Solid Waste Permits
IGCN 1101
100 North Senate Avenue
Indianapolis, IN 46204-2251**

Please provide 3 copies printed double-sided. We greatly appreciate an electronic copy, in Acrobat PDF format on CD or DVD, or email, in place of one of the printed copies.

Submittals must be signed as specified in 329 IAC 10-11-3.

- A5. The permittee must submit quarterly tonnage reports (329 IAC 10-14-1) to the following address:

**Regulatory Reporting Section
Indiana Department of Environmental Management
IGCN 1101
100 North Senate Avenue
Indianapolis, IN 46204-2251**

B. CONSTRUCTION REQUIREMENTS

- B1. The permittee must notify IDEM in writing at least 15 days before beginning construction of a new area.
- B2. The permittee must install boundary markers to identify the limits of construction of each new area.
- B3. The permittee must verify and document in a Construction Certification Report (CCR) submitted as specified in Requirement C1 that all leachate collection pipes and sumps are free of obstructions before placing waste in a newly constructed area.
- B4. The permittee must construct the base grades for the type I liner as shown on DWG. No.12-30404-A (sheet 5 of 37), titled "Type I Liner sub base Grades," dated March 22, 2012 (VFC #66674065).
- B5. Upon selecting the specific materials for the composite liner system, the permittee must test the materials to verify that the interface friction values meet or exceed the values in the approved design. If the tests show that the interface friction values do not achieve the minimum factor of safety assumed in the approved plans, the permittee must select and test alternate materials and rerun the slope stability analysis. The results of the interface friction tests and any new slope stability analyses must be included in the CCR.
- B6. The permittee must test and install all liner and final cover components as specified in the approved Construction Quality Assurance and Construction Quality Control (CQA/CQC) Plan, Attachment 8, dated March 21, 2012 (VFC #66690329, pages 48-75), and revised in June 5, 2013 (VFC#68406443, pages 3-28), and revised on May 22, 2014 (VFC #70087597).
- B7. The permittee must submit a permit modification application and receive IDEM's approval before beginning modifications to the western half of Area 1 to accommodate for AK Steel power line transmission corridor and upgrade the landfill design to Type I standards.
- B8. The permittee is approved to convert approximately 110 of the 408 acres in landfill Area 1 from a restricted waste site (RWS) type II landfill to an RWS type I landfill with the following requirements:
- a. The permittee must implement the conversion as specified in the minor modification application dated March 27, 2012 (VFC #6660329), including the Engineering Report by Terracon Consultants, Inc., dated March 22, 2012 (VFC #66690329, pages 77-325), and supplemental information dated June 29, 2012 (VFC #66357542) and dated August 14, 2012 (VFC #66675686). The following VFC document numbers are plan sheets dated March 22, 2012, related to the minor modification application dated March 27, 2012:

66674284	66674171	66674187	66674069
66674283	66674184	66674215	66674269
66674112	66674213	66674040	66674271
66674169	66674064	66674038	66674072
66674170	66674237	66674060	66674236
66674067	66674201	66674202	66674198
66674065	66674173	66674172	66674285
66674248	66674125	66674272	66674270
66674113	66674186	66674158	
66674124	66674214	66674156	

- b. The permittee must install a composite liner system (combination of soil and geomembrane) and a leachate collection system as shown on DWG. NO. 12-30436-A (sheet 7 of 37), dated March 22, 2012 (VFC #66674069).
- c. The permittee must construct the composite liner system as listed below, starting from the bottom up:
- 5 feet of in-situ soil and/or compacted soil with a hydraulic conductivity of 1×10^{-6} cm/sec;
 - Type II ash (thickness varies depending on the desired grade for the construction of the composite liner);
 - 2 feet of compacted soil liner with a hydraulic conductivity of 1×10^{-7} cm/sec;
 - 30 mil PVC geomembrane;
 - 10 oz. /sq., nonwoven geotextile as a cushion layer;
 - 1 foot of bottom ash with a hydraulic conductivity of 1×10^{-2} cm/sec as a drainage layer; and
 - 1 foot of bottom ash with a hydraulic conductivity of 1×10^{-3} cm/sec as a protective layer.

C. PRE-OPERATIONAL REQUIREMENTS

- C1. The permittee must submit a CCR at least 21 days before placing waste in any newly constructed area. An Indiana registered professional engineer must certify that the construction is in compliance with approved plans and specifications. The report must indicate the boundaries of the certified area and include the results of all tests conducted during construction.

Unless notified otherwise by IDEM, the permittee may begin to accept waste in a newly constructed area 21 days after IDEM receives the documents listed above.

D. OPERATIONAL REQUIREMENTS

- D1. The permittee must comply with 329 IAC 10-28 (Operational Requirements).
- D2. The following wastes generated by American Electric Power-Rockport Plant are approved for disposal in the Restricted Waste Site Type I landfill:
- a. Coal combustion wastes that are exempt from the restricted waste classification process according to 329 IAC 10-9-4(d), including:
 - (1) fly ash
 - (2) bottom ash
 - (3) Flue gas desulfurization (FGD) byproducts
 - b. Wastes that have a valid Type I through Type IV classification under 329 IAC 10-9-4.

The permittee must not dispose of any other wastes in this landfill.

This facility manages coal combustion wastes that are exempt from regulation as hazardous waste under the Bevill Amendment to RCRA (see 329 IAC 3.1-1-7 and 40 CFR 261.4(b)(4)). Bevill exempt wastes are excluded from the hazardous waste characterization process. The wastes listed in Requirement D2.a above are also exempt from the restricted waste classification process according to 329 IAC 10-9-4(d). Bevill wastes not listed in D2.a must have a valid Type I through Type IV waste classification under 329 IAC 10-9-4.

- D3. The permittee must maintain permanent, visible facility and solid waste boundary markers for the life of the facility.
- D4. The permittee must limit solid waste disposal to the areas delineated by the permitted landfill limits shown on DWG. NO. 12-30405-A (sheet 6 of 37), entitled "Type I Liner Top of Clay Grades," dated March 22, 2012 (VFC #66674067).
- D5. The permittee must maintain the site benchmark throughout the entire life and post-closure care period of the facility.
- D6. The permittee must control public access to the facility and prevent unauthorized vehicular traffic and illegal dumping.
- D7. The permittee must inspect the site monthly for compliance with 329 IAC 10 and this permit. The inspections must evaluate the following: landfill cover, run-off control structures, erosion control structures, drainage ditches, monitoring wells and sumps, dust controls, and the leachate collection system. The permittee must keep the inspection records at the facility office for at least 3 years.

- D8. The permittee must manage surface water as shown on DWG. No. 12-30423-A, 12-30424-A and 12-30425-A (sheets 33-35 of 37), titled "Surface Water Ponds and Details," dated March 22, 2012 (VFC#66674270, 66674271 and 66674272) and as specified in the minor modification application referenced in Requirement B8.

The permittee must also meet the following requirements:

- a. Divert surface water from the active fill area to minimize surface water contact with the waste and interference with daily operations.
- b. Properly maintain drainage ditches and the sedimentation basin to prevent off-site deposition of sediment. Remove waste deposits from drainage ditches as necessary to properly convey storm water.
- c. Construct temporary run-off structures in areas which are unable to drain to the sedimentation basin.

- D9. The permittee is approved to use other provisions for cover as provided for in 329 IAC 10-28-11(b), based on the site design, dust controls, and variance request dated August 22, 2014 (VFC #70405282).

The permittee must comply with these additional requirements:

- a. Apply dust control agents or apply 6 inches of cover soil if facility employees observe fugitive dust or conditions that may lead to fugitive dust.
- b. Minimize the working face of the landfill as follows:
 - i. Install final cover as specified in Requirement F3 on all areas of the landfill filled to the approved elevations.
 - ii. Cover with 6" of clay type soil as an intermediate cover on all other areas that have not received waste for one year.

- D10. The permittee must manage waste that generates fugitive dust or fugitive particulate matter in a way that does not violate the rules for fugitive dust (326 IAC 6-4) or fugitive particulate matter (326 IAC 6-5), including 326 IAC 6-5-4(g) for solid waste handling control measures (329 IAC 10-8.2-2).

- D11. The permittee must grade intermediate cover to promote surface water drainage and prevent ponding of water, and implement erosion and sediment control measures within 15 days after placement. The erosion/sedimentation control measures may include the following: establishing vegetation, using alternative/synthetic covers or liners, and/or using other applicable erosion and sedimentation control measures.

- D12. If the permittee notices changes to the physical appearance of the cover soil or uses borrow sites other than those specified in the application, the permittee must, at a minimum, conduct gradation and Atterberg Limits tests on 3 representative samples of the new cover soil. The permittee must submit the results to IDEM within 15 days after such testing and before using the new soil as cover.
- D13. The permittee must meet the following requirements regarding leachate storage at the facility:
- a. Maintain an adequate leachate storage capacity in the leachate ponds during the landfill operation and the post-closure period to ensure proper operation of the leachate collection system and compliance with 329 IAC 10-28-16 (Leachate Disposal).
 - b. Maintain the leachate level in the sumps and manhole at or below the liner system to a maximum of 1 foot head.
 - c. Operate leachate storage in an environmentally safe manner.
- D14. The permittee must meet the following requirements regarding leachate sampling, analysis, and reporting:
- c. Conduct leachate sampling and analysis as required by the wastewater treatment plant or other leachate disposal facility, as applicable, and maintain the results in the facility's operating record
 - d. On or before March 1 of each year, the permittee must submit to IDEM a report for the leachate generated the previous year using the enclosed "Leachate Generation and Recirculation Report" or a similar report developed by the permittee.
- D15. The permittee is approved to temporarily store bottom ash as follows:
- a. Within subcells 4A and 4B of cell 4 as specified in the approval letter dated May 3, 2013 (VFC#68052917). The permittee must route surface water runoff from the temporary storage areas to the North Pond.
 - b. Within the approved solid waste boundary for RWS II as specified in the approval letter dated July 12, 2013 (VFC#68545528). The permittee must comply with the following:
 - (1) Store a maximum of 300,000 cubic yards of bottom ash in this area.
 - (2) Remove the bottom ash from this area before July 12, 2017
 - (3) Route surface water runoff from this area to the West Pond.
 - (4) Maintain the berms to prevent waste migration.
 - (5) Prevent waste migration via wind dispersion.

E. GROUND WATER MONITORING REQUIREMENTS

- E1. The permittee must comply with 329 IAC 10-29 (Ground Water Monitoring and Corrective Action).
- E2. The permittee must label each ground water monitoring well and each piezometer with a permanent and unique identification. When reporting well and piezometer information, the permittee must include the identification for each well or piezometer.
- E3. When abandoning a well or piezometer that is part of the facility's approved ground water monitoring system, the permittee must:
- a. Submit a written proposal for approval explaining the reasons for and detailing the method of abandonment.
 - b. Use methods that comply with Indiana Department of Natural Resources (IDNR) regulation 312 IAC 13-10-2.
 - c. Notify the IDEM Geology Section by phone, e-mail, or letter at least 10 days before the date the abandonment work will occur.
 - d. Provide written notification of abandonment to IDEM and IDNR within 30 days after plugging is complete. (IDNR (312 IAC 13-10-2(f)) requires written notice).
- E4. The permittee must secure and maintain the access ways to monitoring wells and piezometers to prevent unauthorized access, and assure they are passable year round.
- E5. The permittee must maintain all ground water monitoring wells and piezometers as follows:
- a. Complete necessary repairs, other than replacement (see Requirement E6), within 10 days after discovery.
 - b. Keep the monitoring wells securely capped and locked when not in use.
 - c. Repair all cracks in and around the casings.
 - d. Repair cracks in concrete pads.
 - e. Control vegetation height.
 - f. Redevelop the monitoring wells as needed.
- E6. The permittee must notify IDEM by phone, e-mail, or letter within 10 days after discovering that a ground water monitoring well or piezometer has been destroyed or is not functioning properly. The permittee must repair the well or piezometer if possible. If the well or piezometer cannot be repaired, then within 30 days after discovery, the permittee must submit a proposal for abandoning and replacing the well.
- E7. The permittee must submit ground water potentiometric-surface maps or flow maps with each semiannual ground water monitoring report. The maps must

contain the following:

- a. Location and identification of each ground water monitoring well and piezometer.
- b. Static water level relative to mean sea level for each well and piezometer. The permittee must measure all elevations on the same day and as close in time as possible before the purging and sampling event.
- c. Date and time of static water level measurement for each well and piezometer.
- d. Ground-surface elevation at each well and piezometer.
- e. Facility property boundaries.
- f. Identification of the aquifer represented, either by a name or elevation.
- g. Solid waste fill boundaries.
- h. Facility name and county.
- i. Map scale, north arrow, ground water flow direction arrows, and potentiometric-surface contour intervals.
- j. Indications of which monitoring wells are considered background, upgradient, downgradient, or intrawell.
- k. Locations and elevations of all site benchmarks.

- E8. If a ground water potentiometric-surface map or flow map indicates that the ground water flow direction is other than that anticipated in the design of the monitoring well system, the permittee must notify IDEM of the difference in the ground water monitoring report submitted for Requirement E12. The notification must include either of the following: information demonstrating that the monitoring well system still complies with 329 IAC 10-29-1(b); or a proposal to revise the monitoring system design for approval.

If design changes to the existing ground water monitoring system listed in Requirement E11 are necessary, the permittee must make the changes within 30 days after receiving approval of the revised design.

- E9. The permittee must follow the Sampling and Analysis Plan (SAP) and the Quality Assurance Project Plan (QAPjP), dated November 12, 1999 (VFC #52713207).

If IDEM requests a revision, the permittee must submit a revised SAP and QAPjP for approval. The permittee must submit the revision within 60 days after receiving the request. This submittal must include 1 original paper copy and 1 PDF formatted electronic file.

If the permittee makes design changes to the existing ground water monitoring system listed in Requirement E11, the permittee must submit a revised SAP and QAPjP for approval. The permittee must submit the revision within 30 days after completing all field activities associated with the changes. This submittal must include 1 original paper copy and 1 PDF formatted electronic file.

- E10. The permittee must follow the Statistical Evaluation Plan (StEP), dated December 3, 2009 (VFC # 54047681).

If IDEM requests a revision, the permittee must submit a revised StEP for approval. The permittee must submit the revision within 60 days after the request. This submittal must include 1 original paper copy and 1 PDF formatted electronic file. The permittee must not implement a revised StEP before receiving approval.

In the StEP, the permittee must present the data distribution assumptions. The statistical procedures must be appropriate for the data distribution and provide a balance between the probability of falsely identifying a significant difference and the probability of failing to identify a significant difference. To achieve the balance, the permittee should consider the background sample sizes, the number of individual statistical tests performed, and the specific verification resampling method.

If the permittee makes design changes to the existing ground water monitoring system listed in Requirement E11, the permittee must submit a revised StEP for approval. The permittee must submit the revision within 30 days after completing all field activities associated with the changes. This submittal must include 1 original paper copy and 1 PDF formatted electronic file. The permittee must not implement the revised StEP before receiving approval.

E11. The permittee must sample the facility's ground water monitoring well system during May and November of each year. The monitoring well system includes the following wells: MW-1S, MW-1I, MW-1D, MW-15S, MW-15I, MW-16I, MW-16D, MW-17S, MW-17I, MW-21S, MW-21I, and MW-21D. Each sample must be analyzed for the following Phase I parameters:

- a. Field pH
- b. Field specific conductance
- c. Barium (dissolved)
- d. Boron (dissolved)
- e. Chromium (dissolved)
- f. Selenium (dissolved)
- g. Sulfate

E12. No later than 60 days after each ground water monitoring event completed for Requirement E11, the permittee must submit the information in a ground water monitoring report to the IDEM Solid Waste Permits Section in 1 unbound paper copy and in 1 electronic version in PDF format. The report must include the following:

- a. One original, unbound, laboratory-certified report with analytical and field parameters results, field sheets, and chain-of-custody forms. The laboratory-certified report must include the following: detection limit for each chemical parameter, date samples collected, date the laboratory received the samples, date the laboratory analyzed the samples, date the laboratory prepared the report, method of analysis the laboratory used for each parameter, sample identification number for each sample, and

- results of all sample analyses.
- b. All information specified in Requirement E7 and a table summarizing the static water level for each well.
 - c. Comments regarding ground water quality, recent notifications of any compliance issues related to a problematic well or piezometer (see Requirement E6), special field observations and procedures, and deviations from the SAP.
 - d. One original unbound copy of the statistical evaluation report (see Requirement E17).

The permittee may mail the PDF copy and electronic data file specified in Requirement E13 on a CD-ROM or DVD. The permittee must clearly label the PDF copy and data file with the facility name and a brief description of the file. Alternatively, the permittee may e-mail the PDF copy and electronic data file to the IDEM Solid Waste Permit Manager listed in Requirement A4 and carbon copy olodata@idem.IN.gov. The e-mail must include the facility name and a brief description typed in the e-mail's subject heading.

- E13. The permittee must submit 1 electronic data file of the analytical and field parameters results formatted as an ASCII, tab-delimited text file. The electronic data file must contain the facility's name, permit number, and the name of the analytical laboratory. Additionally, the file must include the fields listed below for the analytical results and the following field parameters: pH, specific conductance, temperature, well depth, depth to water, and static water elevation.
- a. SamplingDate: Month, day, and year (mm/dd/yyyy). Value should be formatted as a date if possible.
 - b. SamplePointName: Names of monitoring wells, piezometers, leachate wells, surface water collection points, etc.
 - c. LaboratorySample ID: ID assigned to the sample by the laboratory.
 - d. SampleType: Regular, duplicate(s), trip blank(s), equipment blank(s), field blank(s), verification re-sample(s), and replicate(s).
 - e. SpeciesName: Chloride, sodium, ammonia, field pH, etc. The order of parameters is not critical. However, it is best to reflect the order that is on the laboratory-data sheets and keep all field data grouped together. Metals should indicate "dissolved" phase or "total" phase. Associated static water levels do not have their own header, but must be entered as "GW WaterLevel" under the header "SpeciesName." The actual elevations must be entered under the header "Concentration."
 - f. Concentration (results): The entry must be a number. Please do not enter text, such as "NA," "ND," or "<."
 - g. ConcentrationUnits: mg/l, ug/l, standard units for pH, degrees Celsius (°C) or degrees Fahrenheit (°F) for temperature, and umhos/cm for specific conductance.
 - h. Detected: Yes or no.
 - i. DetectionLimit.
 - j. AnalyticalMethods.
 - k. EstimatedValue: Indicate "Yes" if the reported concentration is an

estimated value. If a value recorded was not estimated, enter "No." If a concentration is estimated, use the "Comment" field to explain why the concentration was estimated.

- l. Comment: Analytical laboratory and/or field personnel comments regarding the reported results.
- m. SampleMedium: Ground water, leachate, surface water, etc.
- n. ProgramArea: Solid Waste.

Additional guidance on electronic data file submittals is available on IDEM's website at www.in.gov/idem/5384.htm or by e-mailing questions to olqdata@idem.IN.gov.

- E14. The permittee must retain laboratory quality assurance/quality control (QA/QC) documentation from valid analyses of ground water samples for at least 3 years.

Upon IDEM request, the permittee must submit the laboratory QA/QC for a specified ground water monitoring data package, in 1 paper copy and 1 electronic copy in PDF format, within 60 days after receiving the request. The "Solid & Hazardous Waste Programs, Analytical Data Deliverable Requirements: Supplemental Guidance" provides additional information about laboratory QA/QC. The guidance is available on IDEM's website at www.in.gov/idem/4673.htm.

- E15. The permittee must conduct ground water monitoring throughout the active life and the post-closure care period of the facility (329 IAC 10-29-3). IDEM may extend the post-closure care period if ground water monitoring results show that the facility has not stabilized (329 IAC 10-31-4).

- E16. The permittee must determine the background ground water quality for any background wells added to the facility's ground water monitoring system by sampling each new well for 4 consecutive quarters within 1 year after their installation. The permittee must establish background ground water quality for the following:

- a. The Phase I parameters in Requirement E11.
- b. The secondary standards in 329 IAC 10-29-7(c).
- c. The ground water protection standard in 329 IAC 10-29-10.

- E17. The permittee must apply the StEP in Requirement E10 to determine whether there is a statistically significant increase (or pH decrease) over the background for each Phase I or Phase II parameter, except for field temperature. The statistical determination must include the value obtained during each semiannual analysis with the established background (329 IAC 10-29-5).

- E18. If the permittee determines there is a statistically significant increase (or pH decrease) over background for 2 or more of the Phase I parameters at any of the downgradient monitoring wells, the permittee must comply with the following requirements:

- a. Notify IDEM in writing within 14 days after the finding. The notification must state which Phase I parameters showed statistically significant increases (or pH decrease) over background levels, and which downgradient monitoring well(s) showed the elevated concentrations.
- b. Collect and analyze the ground water from all monitoring wells for the parameters in Requirement E11 and the parameters determined from 329 IAC 10-29-7(d). The permittee must submit the results to IDEM within 60 days after determining the statistically significant increases.
- c. Establish a Phase II monitoring program based on the results obtained from Requirement E18.b and consult with the IDEM Geology Section within 30 days after completing Requirement E18.b.

The permittee must continue the scheduled Phase I monitoring as described in Requirement E11 and 329 IAC 10-29 throughout the establishment and implementation of a Phase II monitoring program.

E19. In lieu of Requirements E18.b and E18.c, the permittee may attempt to demonstrate that a source other than the solid waste facility caused the increase (or pH decrease) or that the increase (or pH decrease) resulted from error in sampling, analysis, or evaluation. For IDEM to approve the demonstration, the permittee must comply with the following requirements:

- a. Notify IDEM in writing of the intent to make a demonstration. The permittee must submit the notification within 7 days after determining a statistically significant increase (or pH decrease).
- b. Submit a report to IDEM within 90 days after determining a statistically significant increase (or pH decrease). The report must demonstrate that a source other than the solid waste facility caused the increase (or pH decrease), or that the increase (or pH decrease) resulted from error in sampling, analysis, or evaluation. The report must state what efforts the permittee will take to prevent these errors from recurring.
- c. Continue to monitor ground water at all monitoring wells according to the scheduled Phase I monitoring established under 329 IAC 10-29-6.

If a demonstration is not acceptable to IDEM, the permittee must continue with Requirements E18.b and E18.c.

E20. If necessary, the permittee must implement a corrective action program as required under 329 IAC 10-29-9. The corrective action program is complete when ground water protection standards have been met at all points of the plume beyond the monitoring boundary for a period of 3 consecutive years using the statistical procedures outlined in 329 IAC 10-29-5 and procedures approved through this permit.

E21. The permittee must analyze the following constituents in accordance with the sampling schedule specified in Requirement E11 for samples collected from the ground water monitoring wells of the monitoring well system.

- a. Alkalinity, bicarbonate (HCO_3)
- b. Alkalinity, total (CaCO_3)
- c. Aluminum (dissolved)
- d. Arsenic (dissolved)
- e. Cadmium (dissolved)
- f. Calcium (dissolved)
- g. Chloride
- h. Fluoride
- i. Iron (dissolved)
- j. Lead (dissolved)
- k. Magnesium (dissolved)
- l. Manganese (dissolved)
- m. Molybdenum
- n. Mercury (dissolved)
- o. Potassium (dissolved)
- p. Nitrate (NO_3)
- q. Sodium (dissolved)
- r. Silver (dissolved)
- s. Total Dissolved Solids

The permittee must include the sampling results in the ground water monitoring report (Requirement E12).

The permittee must complete a statistical evaluation or a geochemical evaluation on the constituents identified in this Requirement (E21) when the IDEM Geology Section deems an evaluation is necessary. Until the IDEM Geology Section requests an evaluation, the permittee must include a nonstatistical, qualitative review of the concentrations for these constituents in each statistical evaluation report.

- E22. The permittee must include static water levels from the following monitoring wells to develop potentiometric maps required for each ground water submittal (Requirement E7).

- MW-2(S, I, and D)
- MW-5(S and I)
- MW-6(S)
- MW-7(S and I)
- MW-8(S, R, and I)
- MW-9(S)
- MW-10(S)
- MW-11(S)
- MW-12(S)
- MW-13(S)
- MW-14(S)

- E23. The permittee must include time series plots (time vs. concentration) of the facility's ground water data when the IDEM Geology Section requests the plots to be included in the statistical evaluation report (Requirement E12.d).

F. CLOSURE REQUIREMENTS

- F1. The permittee must comply with 329 IAC 10-30 (Closure Requirements for Restricted Waste Site Type I Landfill) and follow the facility's approved closure plan dated December 19, 2007 (VFC #27473581, Appendix B, Attachment 17, p. 31-41 of 64), and revisions dated March 27, 2012 (VFC#66690329, p. 21-47 of 325).
- F2. The permittee must notify IDEM in writing at least 60 days before the intended date to begin closure of each area.
- F3. The permittee must construct the final cover as specified in the approved final grading plan as shown on DWG. NO. 12-30429-A (sheet 10 of 37), titled "Top of Final Cover Grades," dated March 22, 2012 (VFC #66674113), and the applicable requirements of 329 IAC 10-30-2 and 10-28-11. Grading and stabilization of final cover must comply with 329 IAC 10-28-14.

G. POST-CLOSURE REQUIREMENTS

- G1. The permittee must perform post-closure monitoring and maintenance as specified in the facility post-closure plan in the permit application dated December 19, 2007 (VFC #27473581, Appendix B, Attachment 17, p. 42-49 of 64), and revisions dated March 27, 2012 (VFC#66690329, p. 21-47 of 325), and the applicable requirements of 329 IAC 10-31.

H. FINANCIAL RESPONSIBILITY FOR CLOSURE AND POST-CLOSURE

- H1. The permittee must maintain a financial assurance mechanism for the costs of closure and post-closure using one of the financial assurance mechanisms and the estimating standards described in 329 IAC 10-39. The permittee must submit signed originals of the financial assurance mechanism and updates used to meet this requirement.
- H2. The permittee must submit a financial responsibility update by June 15 of each year. The annual update must address the following items as detailed in 329 IAC 10-39-2(c) and (d), and 329 IAC 10-39-3(c):
- a. The permittee must adjust the closure and post-closure cost estimates for inflation.
 - b. The permittee must revise the cost estimates to account for changes which increase the cost of closure or post-closure.


- c. The permittee may revise the cost estimates to account for changes which reduce the cost of closure or post-closure. The permittee must provide documentation supporting reduced cost-estimates, for example: letters and maps documenting areas certified as closed.
- d. The permittee must submit an existing contour map showing the approved solid waste land disposal facility that delineates the boundaries of all areas into which waste has been placed, and the boundaries of areas certified as closed. The map must be certified by a professional engineer or a registered land surveyor.
- e. The permittee must submit documentation showing that the financial assurance mechanism is current and adequate to cover the estimated costs of closure and post-closure. The permittee must submit signed originals of the financial assurance mechanism and updates used to meet this requirement.

APPENDIX B

**MAPS AND CROSS-SECTIONS
1983 LANDFILL SITE INVESTIGATION**



DR. NO. 12-30090

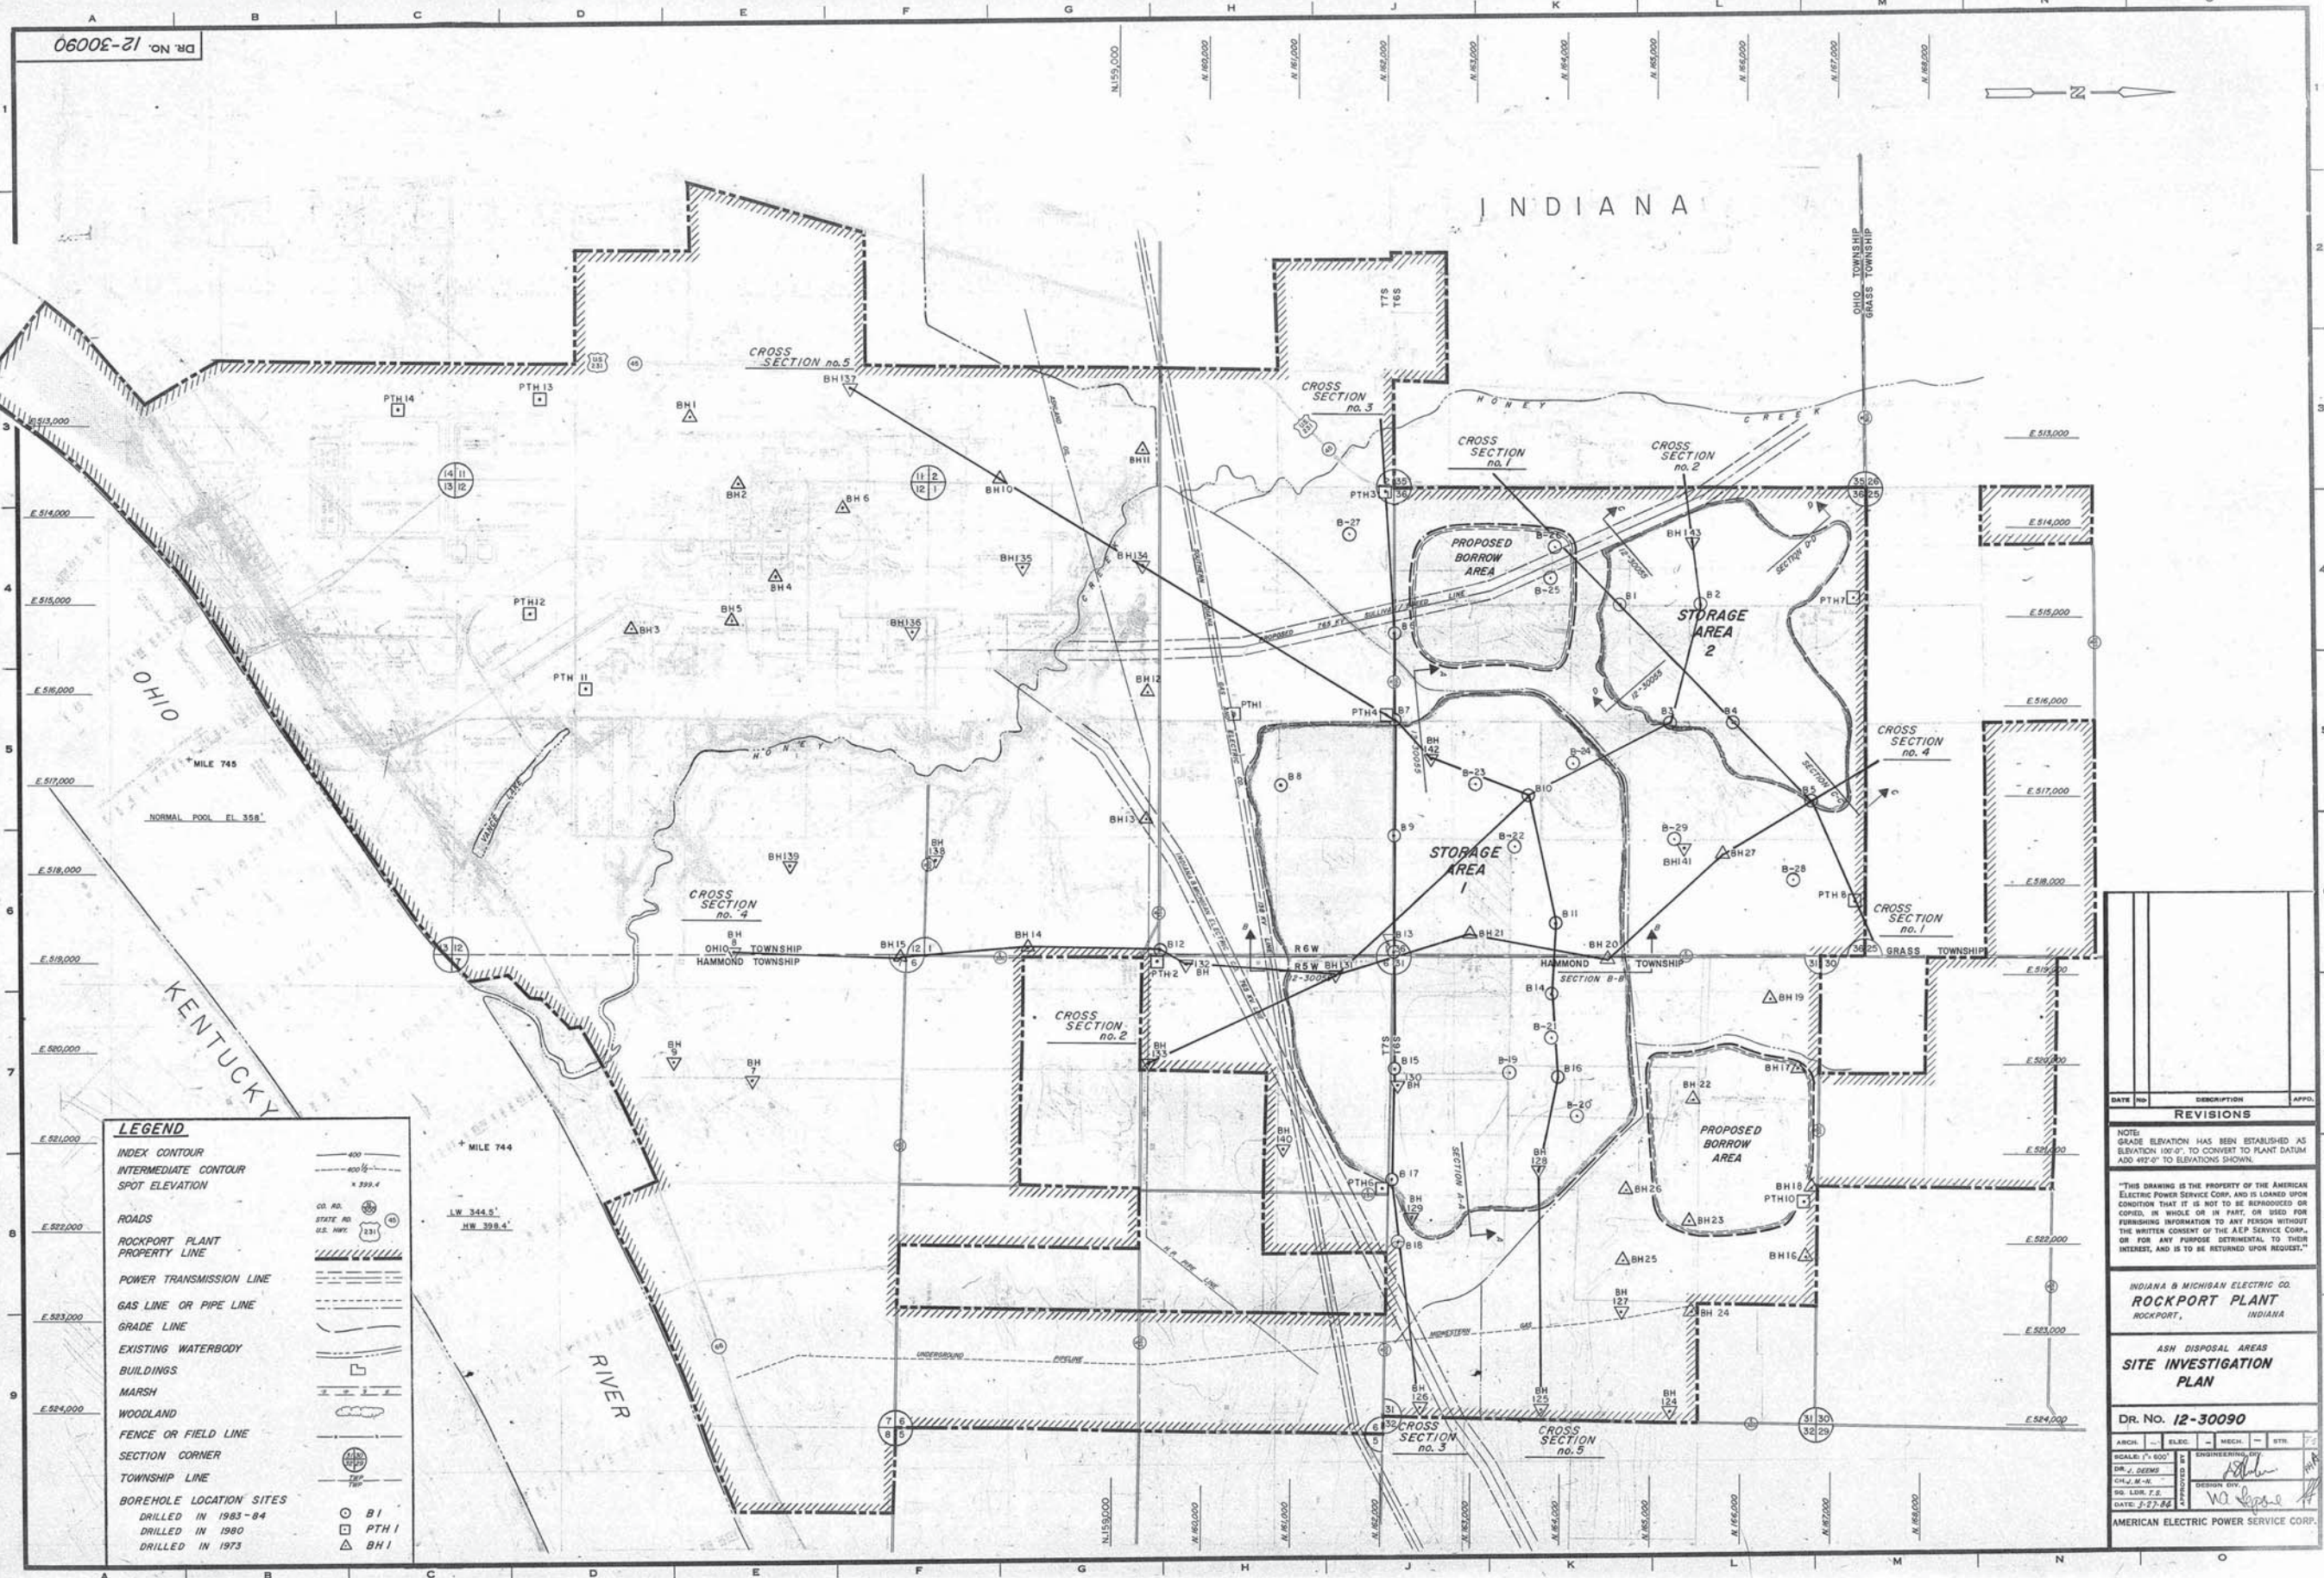

LEGEND

- INDEX CONTOUR
- INTERMEDIATE CONTOUR
- SPOT ELEVATION
- ROADS
- ROCKPORT PLANT PROPERTY LINE
- POWER TRANSMISSION LINE
- GAS LINE OR PIPE LINE
- GRADE LINE
- EXISTING WATERBODY
- BUILDINGS
- MARSH
- WOODLAND
- FENCE OR FIELD LINE
- SECTION CORNER
- TOWNSHIP LINE
- BOREHOLE LOCATION SITES
 - DRILLED IN 1983-84: B1
 - DRILLED IN 1980: PTH1
 - DRILLED IN 1973: BH1

DATE	NO.	DESCRIPTION	APPRO.
REVISIONS			

NOTE: GRADE ELEVATION HAS BEEN ESTABLISHED AS ELEVATION 100'-0" TO CONVERT TO PLANT DATUM ADD 452'-0" TO ELEVATIONS SHOWN.


"THIS DRAWING IS THE PROPERTY OF THE AMERICAN ELECTRIC POWER SERVICE CORP. AND IS LOANED UPON CONDITION THAT IT IS NOT TO BE REPRODUCED OR COPIED, IN WHOLE OR IN PART, OR USED FOR FURNISHING INFORMATION TO ANY PERSON WITHOUT THE WRITTEN CONSENT OF THE AEP SERVICE CORP., OR FOR ANY PURPOSE DETRIMENTAL TO THEIR INTEREST, AND IS TO BE RETURNED UPON REQUEST."

INDIANA & MICHIGAN ELECTRIC CO.
ROCKPORT PLANT
 ROCKPORT, INDIANA


ASH DISPOSAL AREAS
SITE INVESTIGATION PLAN

Dr. No. 12-30090

APPRO.	DATE	BY	CHKD.	DATE
DRAWN BY		ENGINEERING		
DR. J. DEEMS		DATE 3-27-86		
CHKD. M.E.		APPROVED BY		
SIGNED T.S.		DATE 3-27-86		
DATE 3-27-86		AMERICAN ELECTRIC POWER SERVICE CORP.		

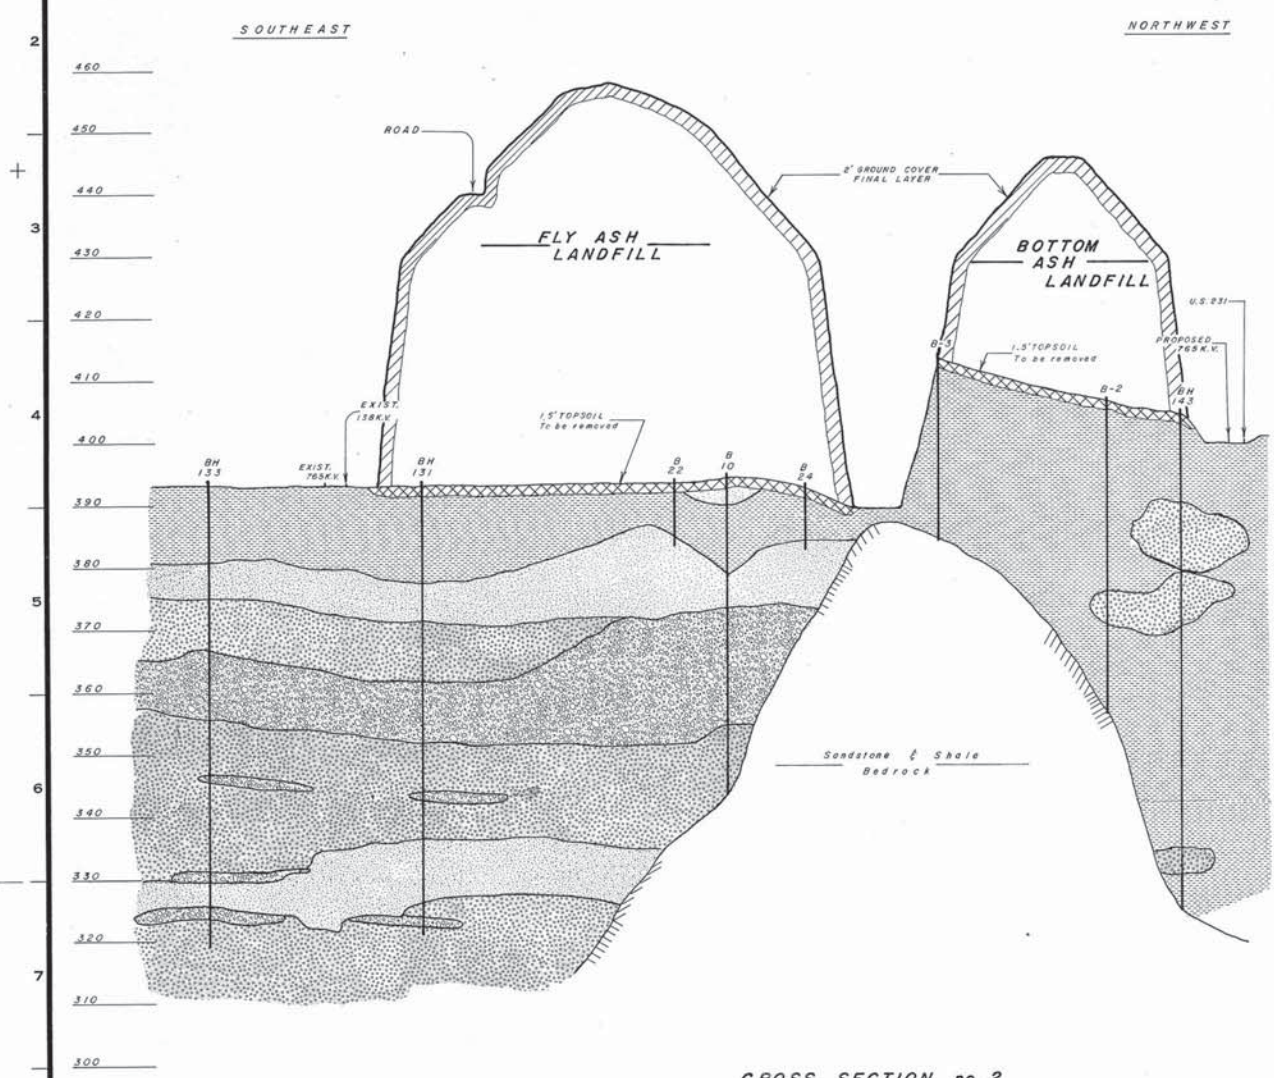

CROSS SECTION no. 2

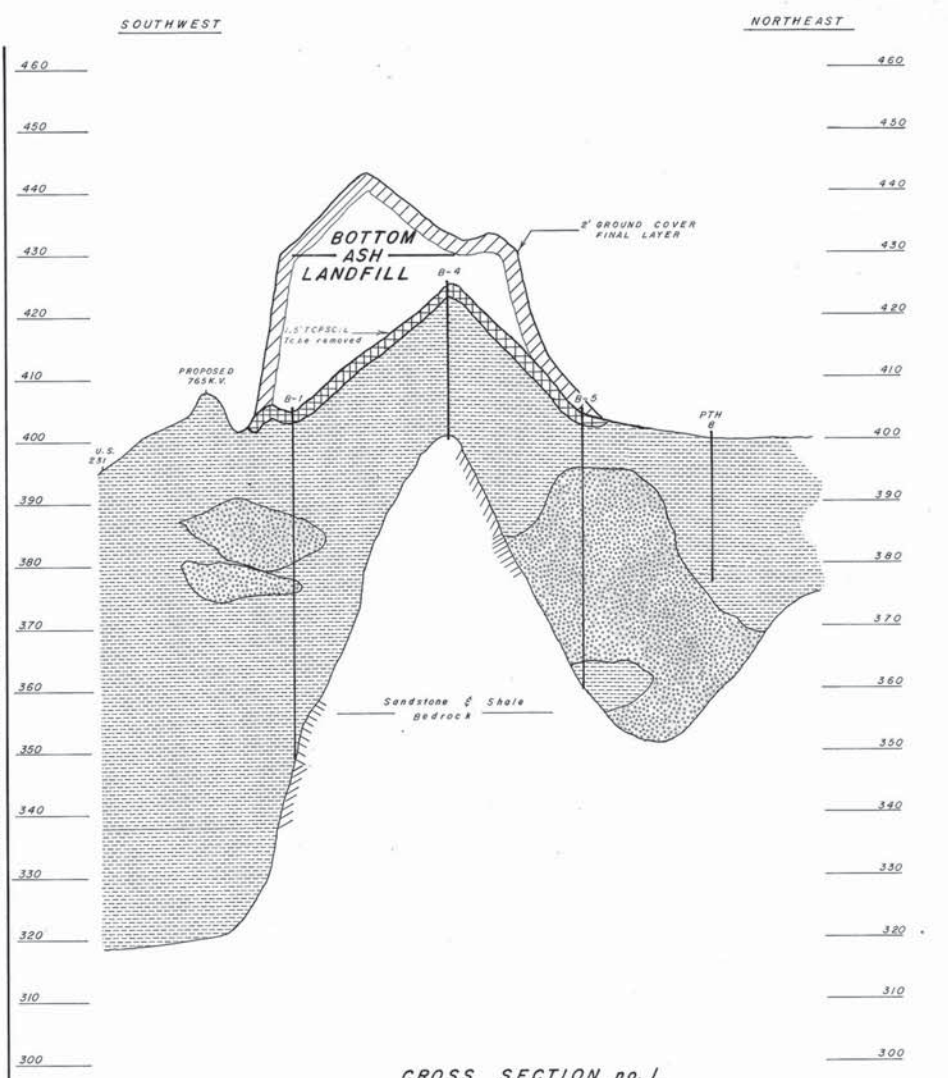


CROSS SECTION no. 1

LEGEND

- GROUND COVER
- TOP SOIL
- SILTY SANDY CLAY
- FINE SAND
- SAND
- SAND & GRAVEL

SCALE:
Horizontal 1" = 60'
Vertical 1" = 10'

DATE	NO.	DESCRIPTION	APPD.
REVISIONS			
<p>THIS DRAWING IS THE PROPERTY OF THE AMERICAN ELECTRIC POWER SERVICE CORP. AND IS LOANED UPON CONDITION THAT IT IS NOT TO BE REPRODUCED OR COPIED, IN WHOLE OR IN PART, OR USED FOR FURNISHING INFORMATION TO ANY PERSON WITHOUT THE WRITTEN CONSENT OF THE AEP SERVICE CORP., OR FOR ANY PURPOSE DETRIMENTAL TO THEIR INTEREST, AND IS TO BE RETURNED UPON REQUEST.</p>			
<p>INDIANA & MICHIGAN ELECTRIC CO. ROCKPORT PLANT ROCKPORT, INDIANA</p>			
<p>ASH DISPOSAL AREAS GEOLOGIC X-SECTIONS NR 1 & NR 2</p>			
DR. NO. 12-30091			
ARCH.	ELEC.	MECH.	EST.
SCALE	DR.	ENGR.	APPD.
CH.	BY	DATE	
AMERICAN ELECTRIC POWER SERVICE CORP.			

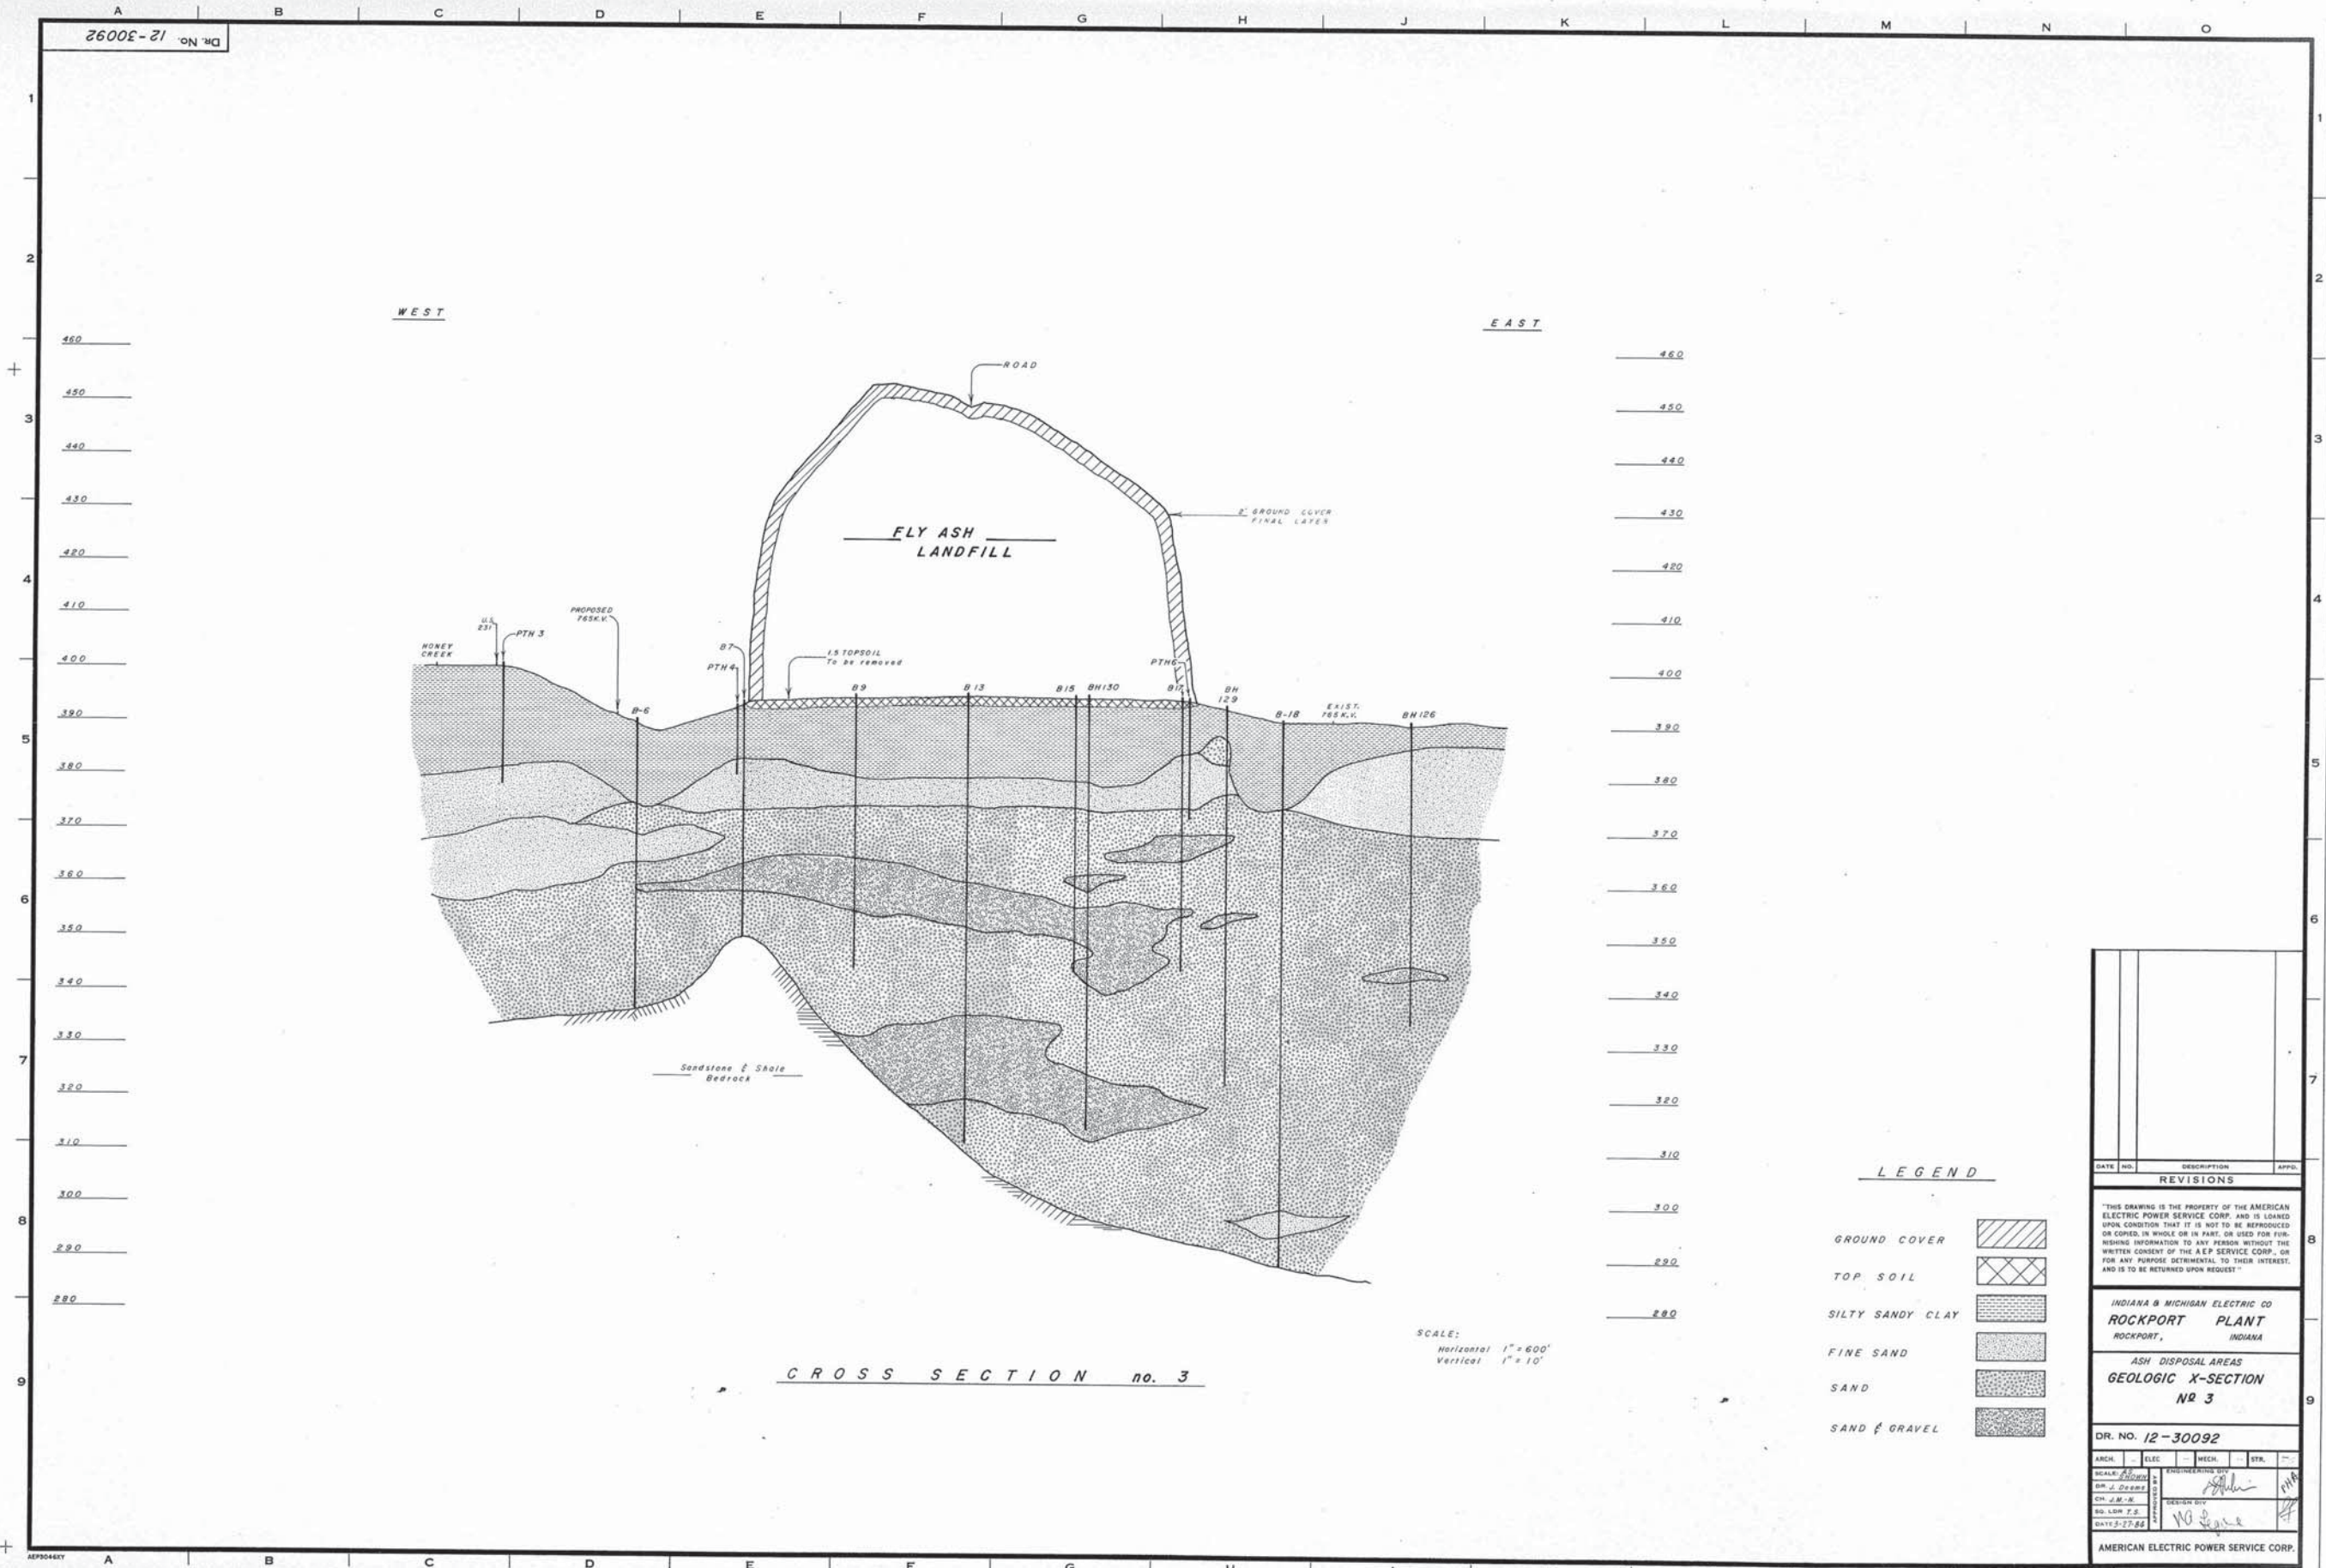


CROSS SECTION no. 3

SCALE:
Horizontal 1" = 600'
Vertical 1" = 10'

LEGEND

GROUND COVER	
TOP SOIL	
SILTY SANDY CLAY	
FINE SAND	
SAND	
SAND & GRAVEL	

DATE	NO.	DESCRIPTION	APPR.
REVISIONS			
<p><small>"THIS DRAWING IS THE PROPERTY OF THE AMERICAN ELECTRIC POWER SERVICE CORP. AND IS LOANED UPON CONDITION THAT IT IS NOT TO BE REPRODUCED OR COPIED, IN WHOLE OR IN PART, OR USED FOR FURNISHING INFORMATION TO ANY PERSON WITHOUT THE WRITTEN CONSENT OF THE A.E.P. SERVICE CORP., OR FOR ANY PURPOSE DETRIMENTAL TO THEIR INTEREST, AND IS TO BE RETURNED UPON REQUEST."</small></p>			
INDIANA & MICHIGAN ELECTRIC CO ROCKPORT PLANT ROCKPORT, INDIANA			
ASH DISPOSAL AREAS GEOLOGIC X-SECTION NR 3			
DR. NO. 12-30092			
ARCH.	ELEC.	MECH.	STR.
SCALE: 1" = 600'	DESIGNED BY: <i>J. Deane</i>	ENGINEERED BY: <i>J. Deane</i>	CHKD BY: <i>J. Deane</i>
DR. J. Deane	DATE: 5-27-66	NO. 12-30092	
AMERICAN ELECTRIC POWER SERVICE CORP.			

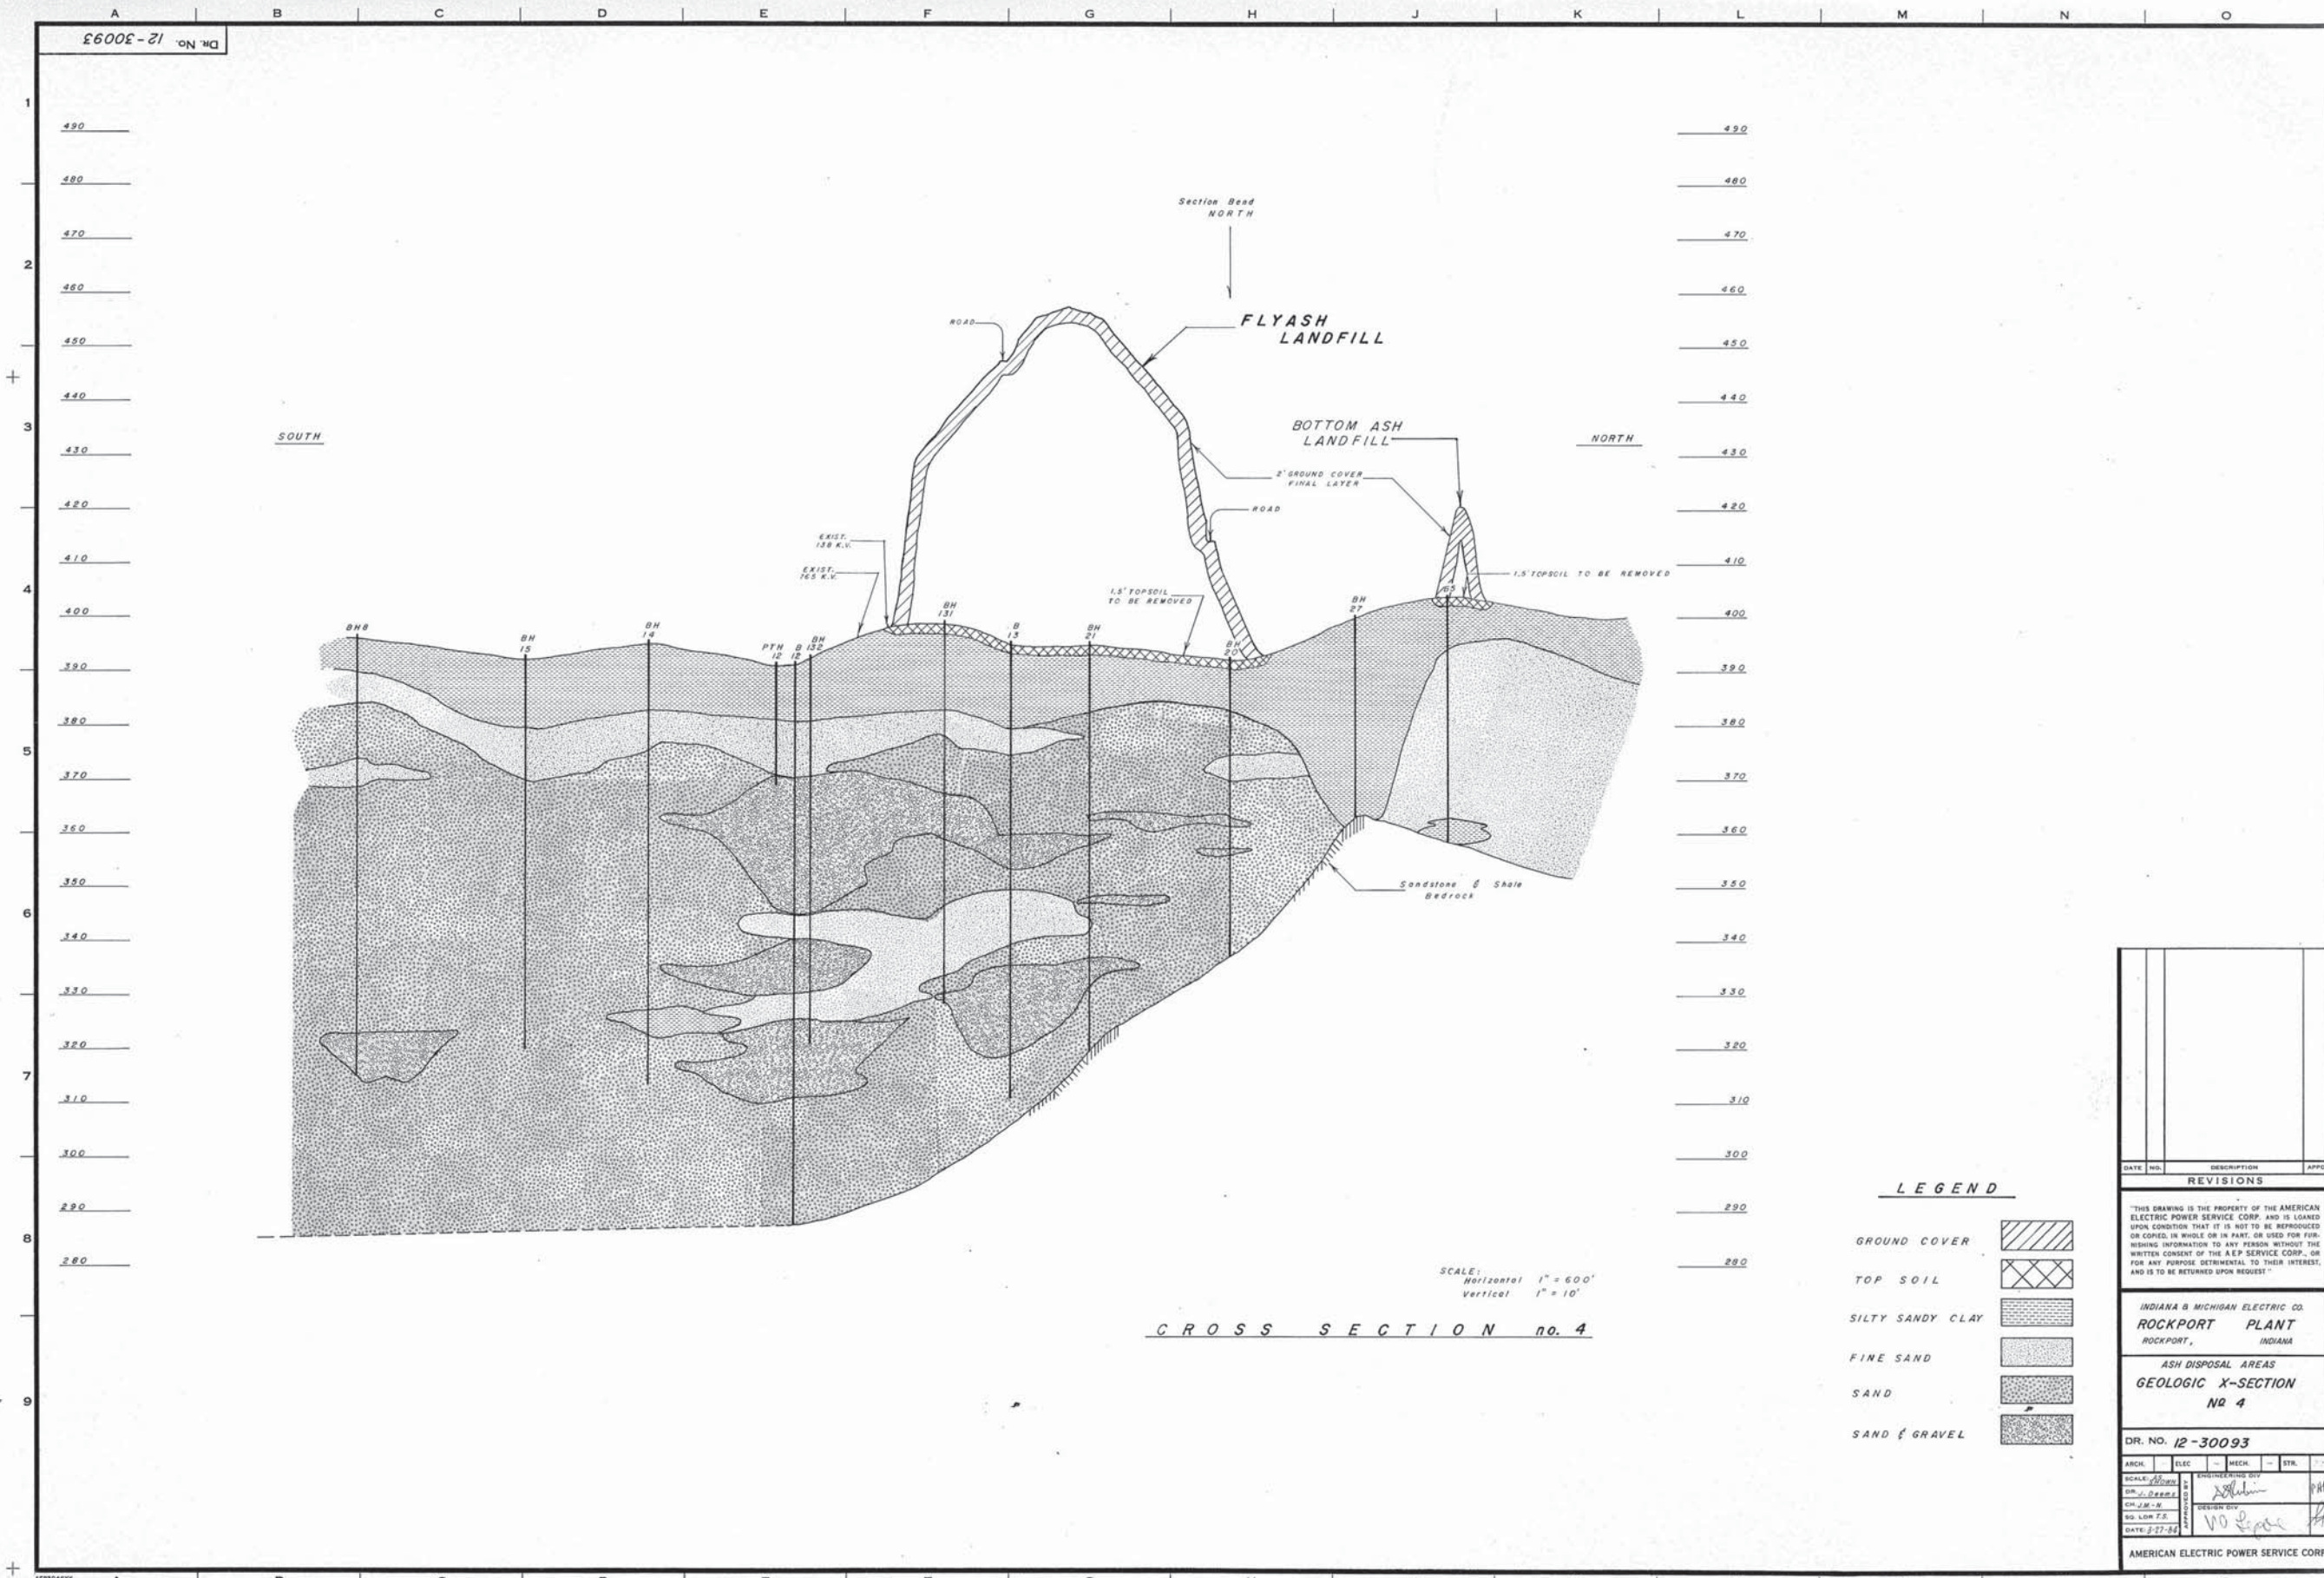

LEGEND


GROUND COVER	
TOP SOIL	
SILTY SANDY CLAY	
FINE SAND	
SAND	
SAND & GRAVEL	

SCALE:
Horizontal 1" = 60'
Vertical 1" = 10'

CROSS SECTION no. 4

DATE	NO.	DESCRIPTION	APPD.
REVISIONS			
<p>THIS DRAWING IS THE PROPERTY OF THE AMERICAN ELECTRIC POWER SERVICE CORP. AND IS LOANED UPON CONDITION THAT IT IS NOT TO BE REPRODUCED OR COPIED, IN WHOLE OR IN PART, OR USED FOR FURNISHING INFORMATION TO ANY PERSON WITHOUT THE WRITTEN CONSENT OF THE AEP SERVICE CORP., OR FOR ANY PURPOSE DETRIMENTAL TO THEIR INTEREST, AND IS TO BE RETURNED UPON REQUEST.</p>			
<p>INDIANA & MICHIGAN ELECTRIC CO. ROCKPORT PLANT ROCKPORT, INDIANA</p>			
<p>ASH DISPOSAL AREAS GEOLOGIC X-SECTION NO 4</p>			
DR. NO. 12-30093			
ARCH.	ELEC.	MECH.	STR.
DESIGNED BY	DRAWN BY		CHECKED BY
DATE	DATE		DATE
AMERICAN ELECTRIC POWER SERVICE CORP.			

DR. No. 12-30094

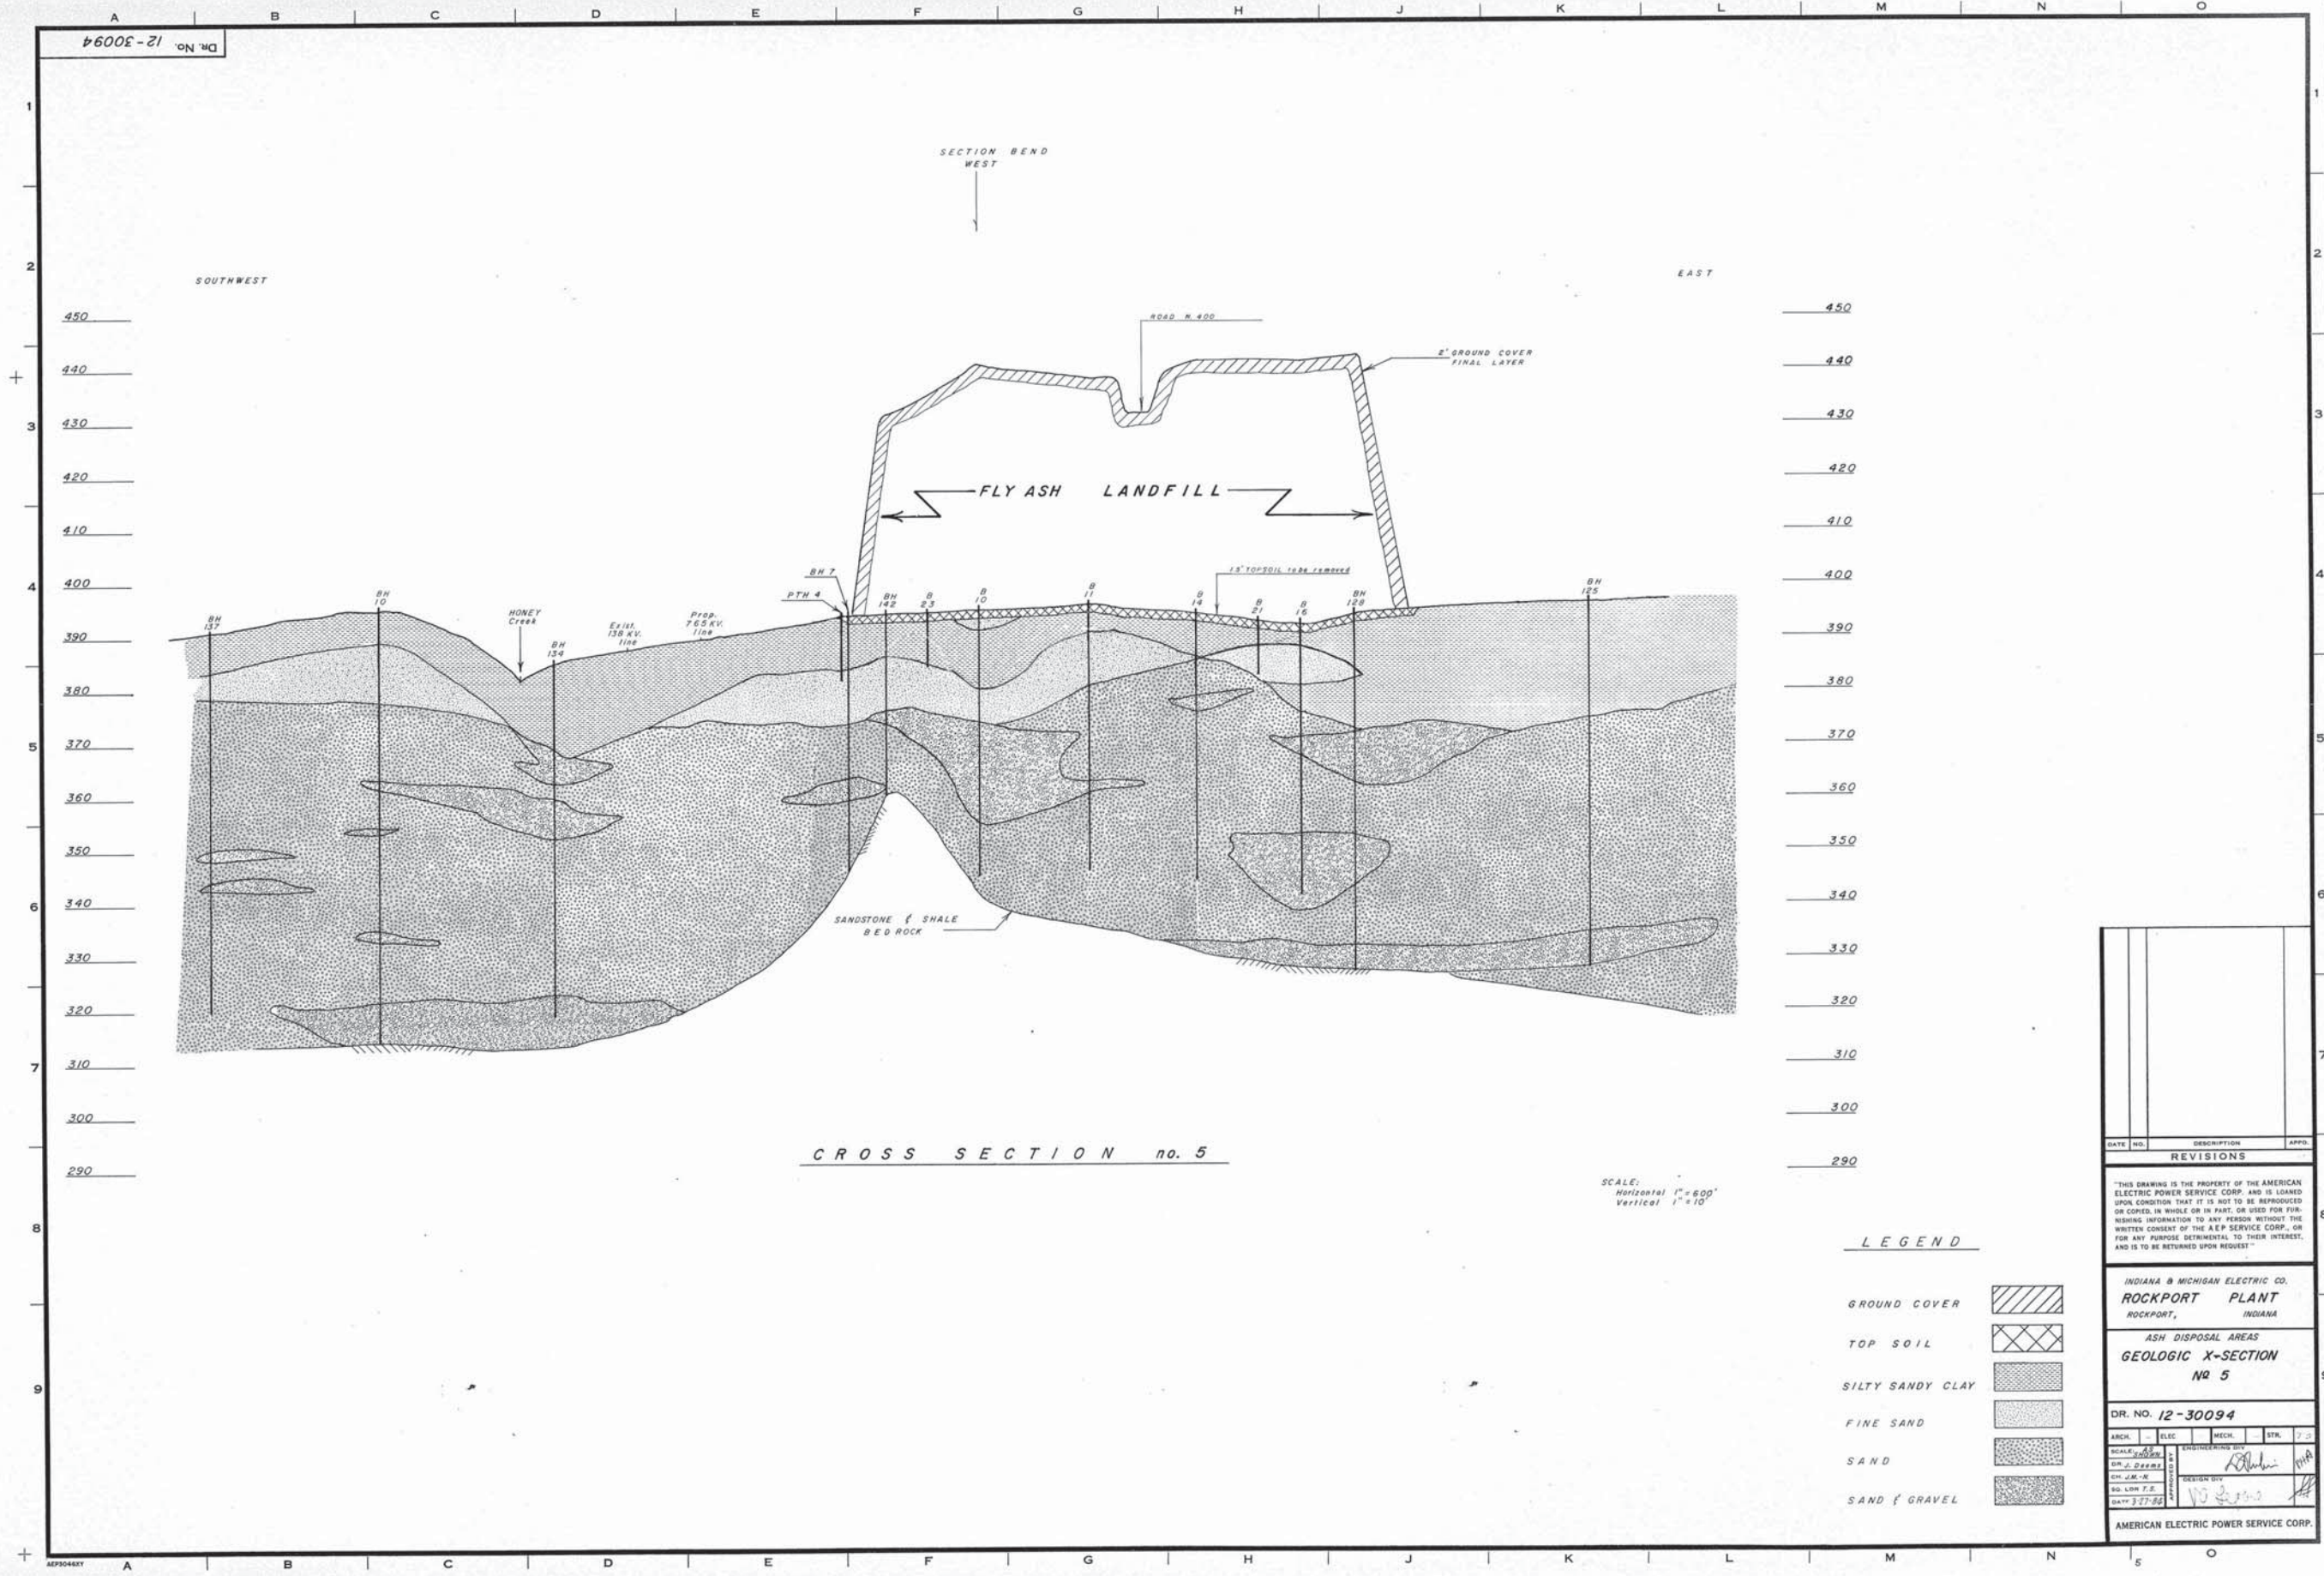

CROSS SECTION no. 5

SCALE: Horizontal 1" = 800' Vertical 1" = 10'

LEGEND

- GROUND COVER
- TOP SOIL
- SILTY SANDY CLAY
- FINE SAND
- SAND
- SAND & GRAVEL

DATE	DESCRIPTION	APPR.
REVISIONS		
THIS DRAWING IS THE PROPERTY OF THE AMERICAN ELECTRIC POWER SERVICE CORP. AND IS LOANED UPON CONDITION THAT IT IS NOT TO BE REPRODUCED OR COPIED, IN WHOLE OR IN PART, OR USED FOR FURNISHING INFORMATION TO ANY PERSON WITHOUT THE WRITTEN CONSENT OF THE AEP SERVICE CORP., OR FOR ANY PURPOSE DETRIMENTAL TO THEIR INTEREST, AND IS TO BE RETURNED UPON REQUEST.		
INDIANA & MICHIGAN ELECTRIC CO. ROCKPORT PLANT ROCKPORT, INDIANA		
ASH DISPOSAL AREAS GEOLOGIC X-SECTION NO 5		
DR. NO. 12-30094		
CHECKED BY	ELEC.	MECH.
DRAWN BY	STR.	STR.
APPROVED BY	REVISIONS	
EG. LHM T.E.	DATE 3-17-58	
AMERICAN ELECTRIC POWER SERVICE CORP.		



LEGEND

INDEX CONTOUR ——— 400

INTERMEDIATE CONTOUR ——— 400.5

SPOT ELEVATION ——— 399.4

BEDROCK CONTOUR (10' INTERVAL) ——— 400

ROADS

STATE RD. ———

COUNTY HWY. ———

ROCKPORT PLANT PROPERTY LINE ———

POWER TRANSMISSION LINE ———

GAS LINE OR PIPE LINE ———

GRADE LINE ———

EXISTING WATERBODY ———

BUILDINGS ———

MARSH ———

WOODLAND ———

FENCE OR FIELD LINE ———

SECTION CORNER ———

TOWNSHIP LINE ———

BOREHOLE LOCATION SITES

DRILLED IN 1983-84 ○ B1

DRILLED IN 1980 □ PTH1

DRILLED IN 1973 △ BH1

DATE	DESCRIPTION	APPRO.
REVISIONS		
NOTE: GRADE ELEVATION HAS BEEN ESTABLISHED AS ELEVATION 100' TO CONVERT TO PLANT DATUM. ADD 482'-0" TO ELEVATIONS SHOWN.		
"THIS DRAWING IS THE PROPERTY OF THE AMERICAN ELECTRIC POWER SERVICE CORP. AND IS LOANED UNDER CONDITION THAT IT IS NOT TO BE REPRODUCED OR COPIED, IN WHOLE OR IN PART, OR USED FOR FURNISHING INFORMATION TO ANY PERSON WITHOUT THE WRITTEN CONSENT OF THE AEP SERVICE CORP., OR FOR ANY PURPOSE UNRELATED TO THEIR INTEREST, AND IS TO BE RETURNED UPON REQUEST."		
INDIANA & MICHIGAN ELECTRIC CO. ROCKPORT PLANT ROCKPORT, INDIANA		
ASH DISPOSAL AREAS BEDROCK TOPOGRAPHY		
DR. NO. 12-30095		
ARCH. —	ELEC. —	MECH. —
SCALE: 1" = 500'		
DR. T. LA ROSE		
CH. J. M. R.		
SO. LOR. P.E.		
DATE: 1-27-82		
AMERICAN ELECTRIC POWER SERVICE CORP.		

DR. NO. 12-30098

INDIANA

BORING LEGEND

- ABANDONED WATER WELL
- ACTIVE OIL WELL (BRINE INJECTION WELL)
- PLUGGED OIL or GAS WELL
- BOREHOLE DRILLED IN 1983-'84
- BOREHOLE DRILLED IN 1986
- △ BOREHOLE DRILLED IN 1973

LEGEND

- INDEX CONTOUR
- INTERMEDIATE CONTOUR
- SPOT ELEVATION
- ROADS
- ROCKPORT PLANT PROPERTY LINE
- POWER TRANSMISSION LINE
- GAS LINE OR PIPE LINE
- GRADE LINE
- EXISTING WATERBODY
- BUILDINGS
- MARSH
- WOODLAND
- FENCE OR FIELD LINE
- SECTION CORNER
- TOWNSHIP LINE

REVISIONS

NOTE: GRADE ELEVATION HAS BEEN ESTABLISHED AS ELEVATION 100'-0" TO CONVERT TO PLANT DATUM ADD 482'-0" TO ELEVATIONS SHOWN.

"THIS DRAWING IS THE PROPERTY OF THE AMERICAN ELECTRIC POWER SERVICE CORP. AND IS LOANED UPON CONDITION THAT IT IS NOT TO BE REPRODUCED OR COPIED IN WHOLE OR IN PART, OR USED FOR FURNISHING INFORMATION TO ANY PERSON WITHOUT THE WRITTEN CONSENT OF THE A.E.P. SERVICE CORP. OR FOR ANY PURPOSE DETRIMENTAL TO THEIR INTEREST. AND IS TO BE RETURNED UPON REQUEST."


**INDIANA & MICHIGAN ELECTRIC SERVICE CORPORATION
ROCKPORT PLANT**

**ASH DISPOSAL AREA
LOCATION OF
OIL / GAS WELLS**

DR. NO. 12-30098

ARCH	ELIC	WEL	PT
SCALE: 1" = 600'	ENGINEER	DATE: 3-27-84	
DR. T. LA ROSE			
APPROVED			

AMERICAN ELECTRIC POWER SERVICE CORP.

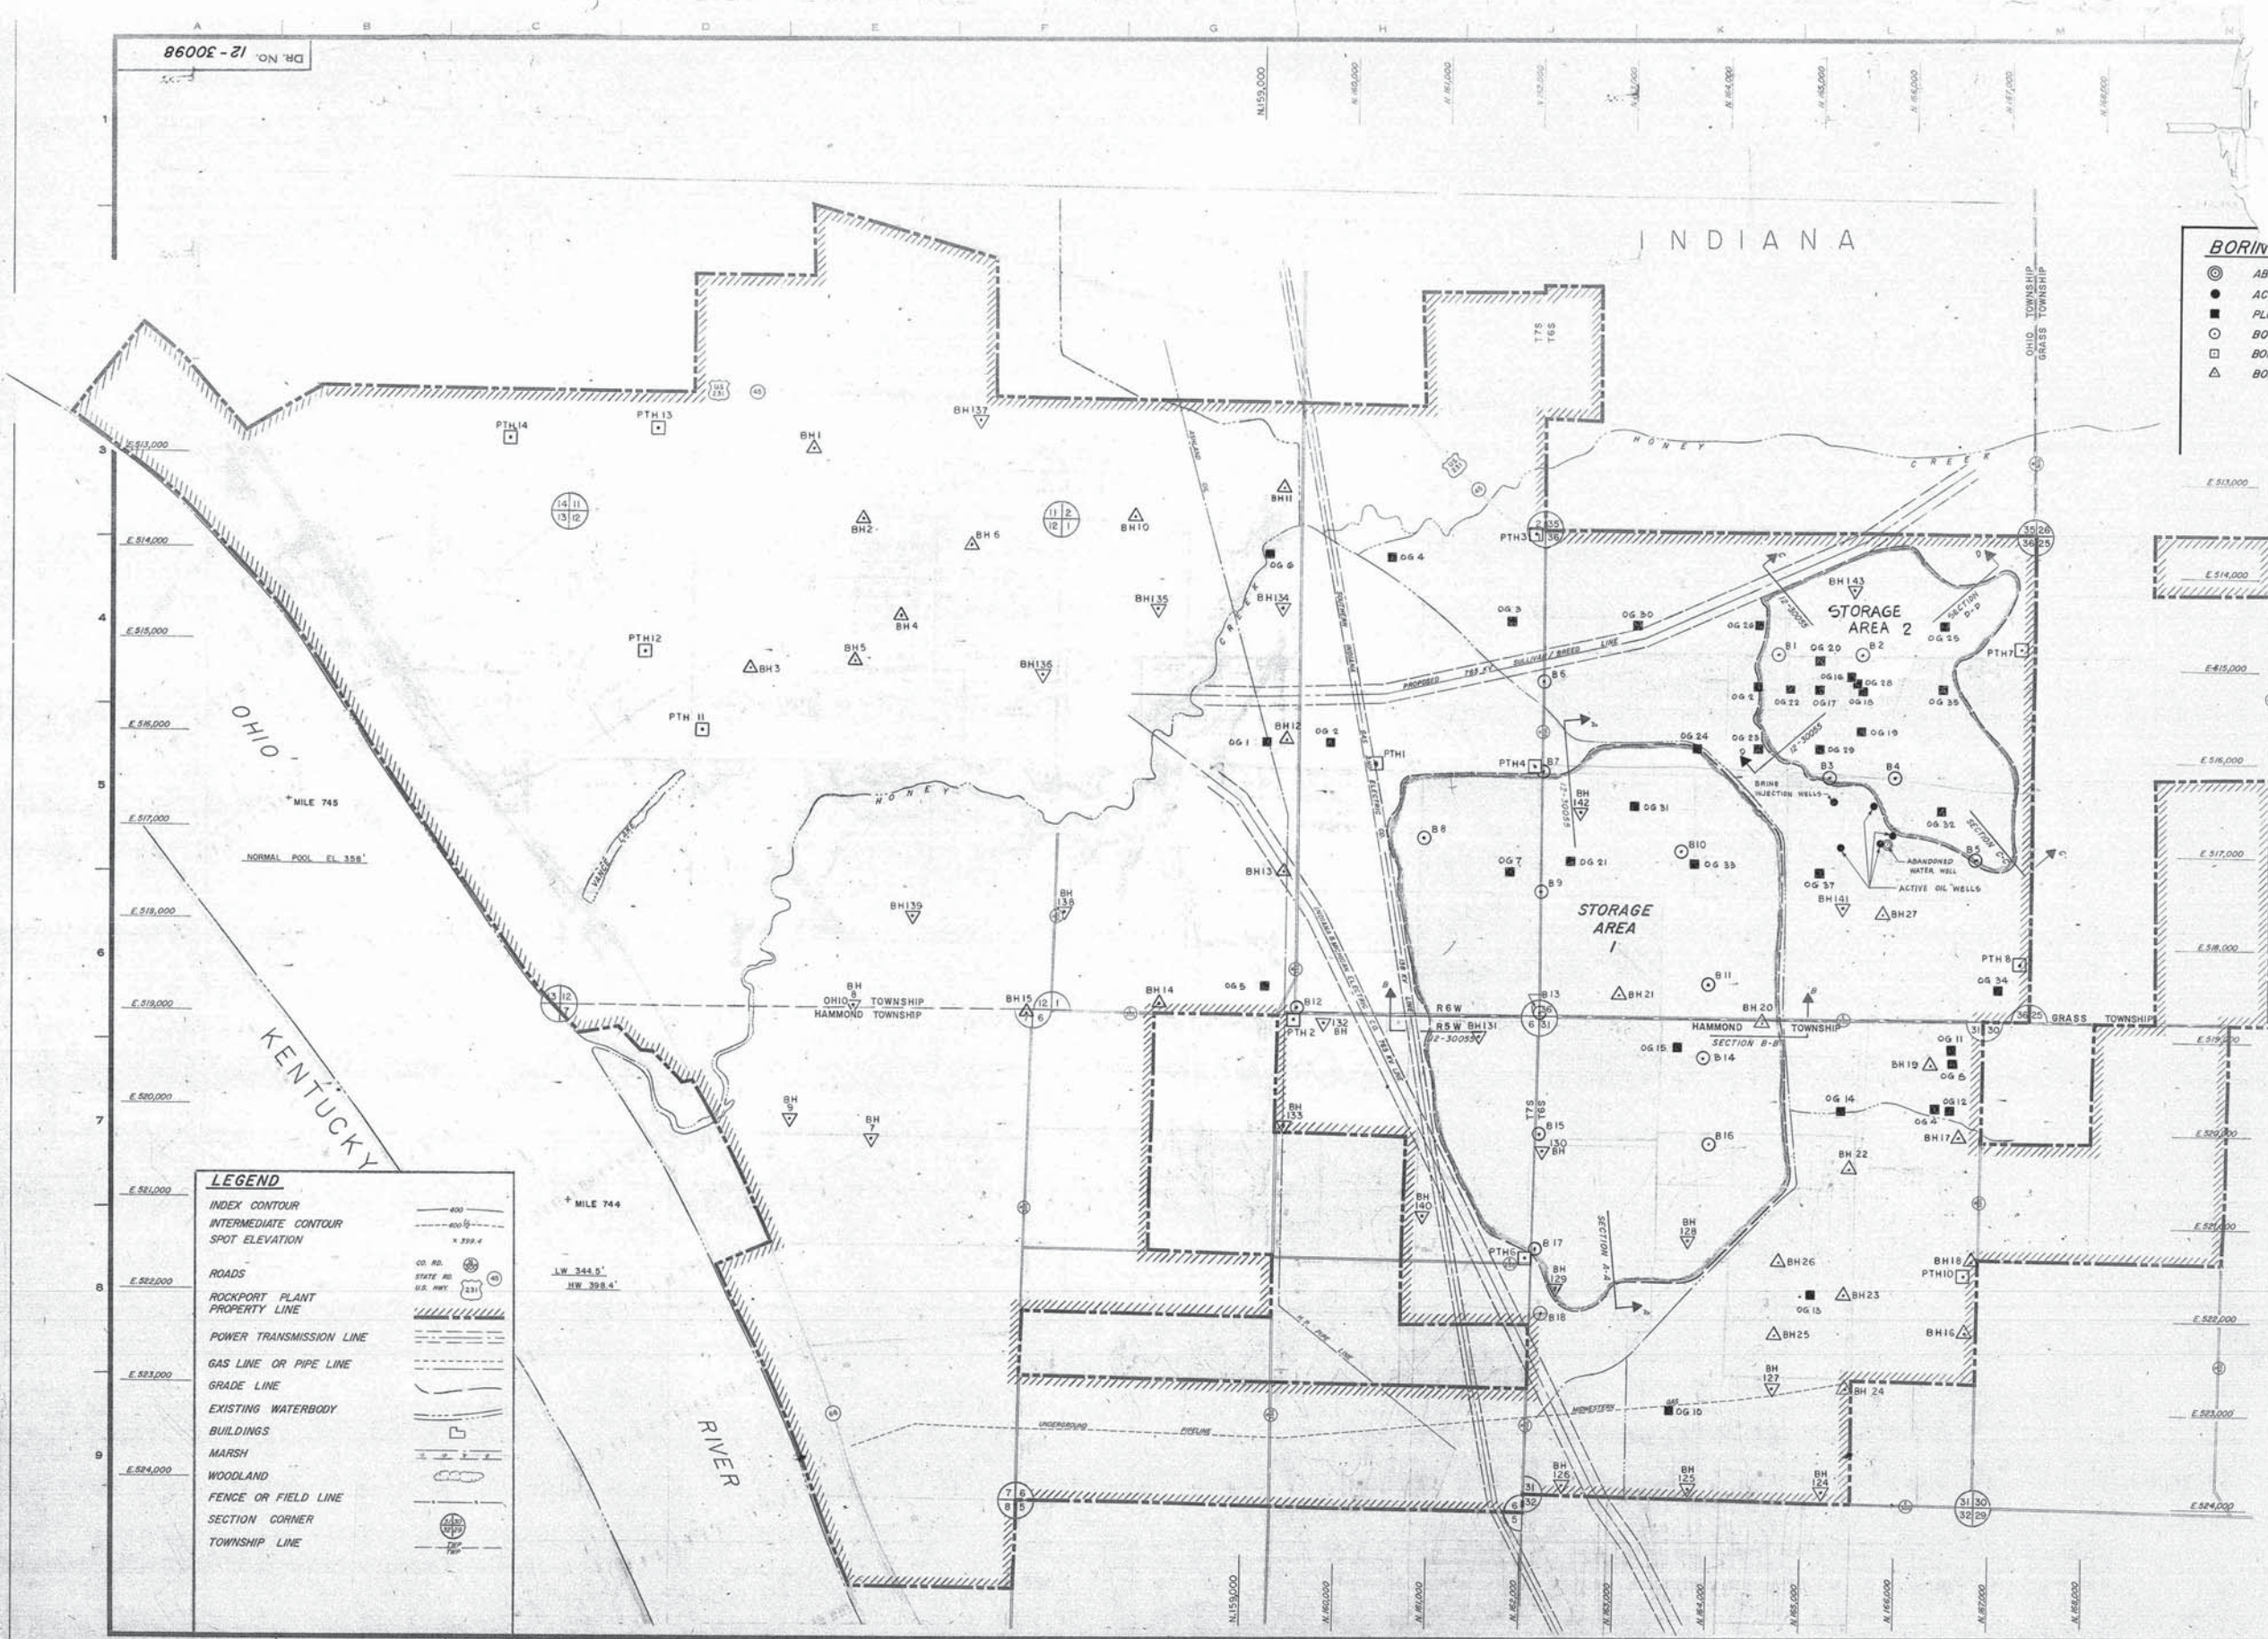

APPENDIX C

**WELL CONSTRUCTION AND LITHOLOGIC LOGS
LANDFILL MONITORING WELLS**


I & M
Rockport Plant
Ash Storage Area
Well No. 1S
4-25-84

MW-1S

5/31/2016
Reference Point
397.33
(top of 4" coupler,
lid removed)

5/31/2016
Top of Ground
396.81

2" PVC Pipe

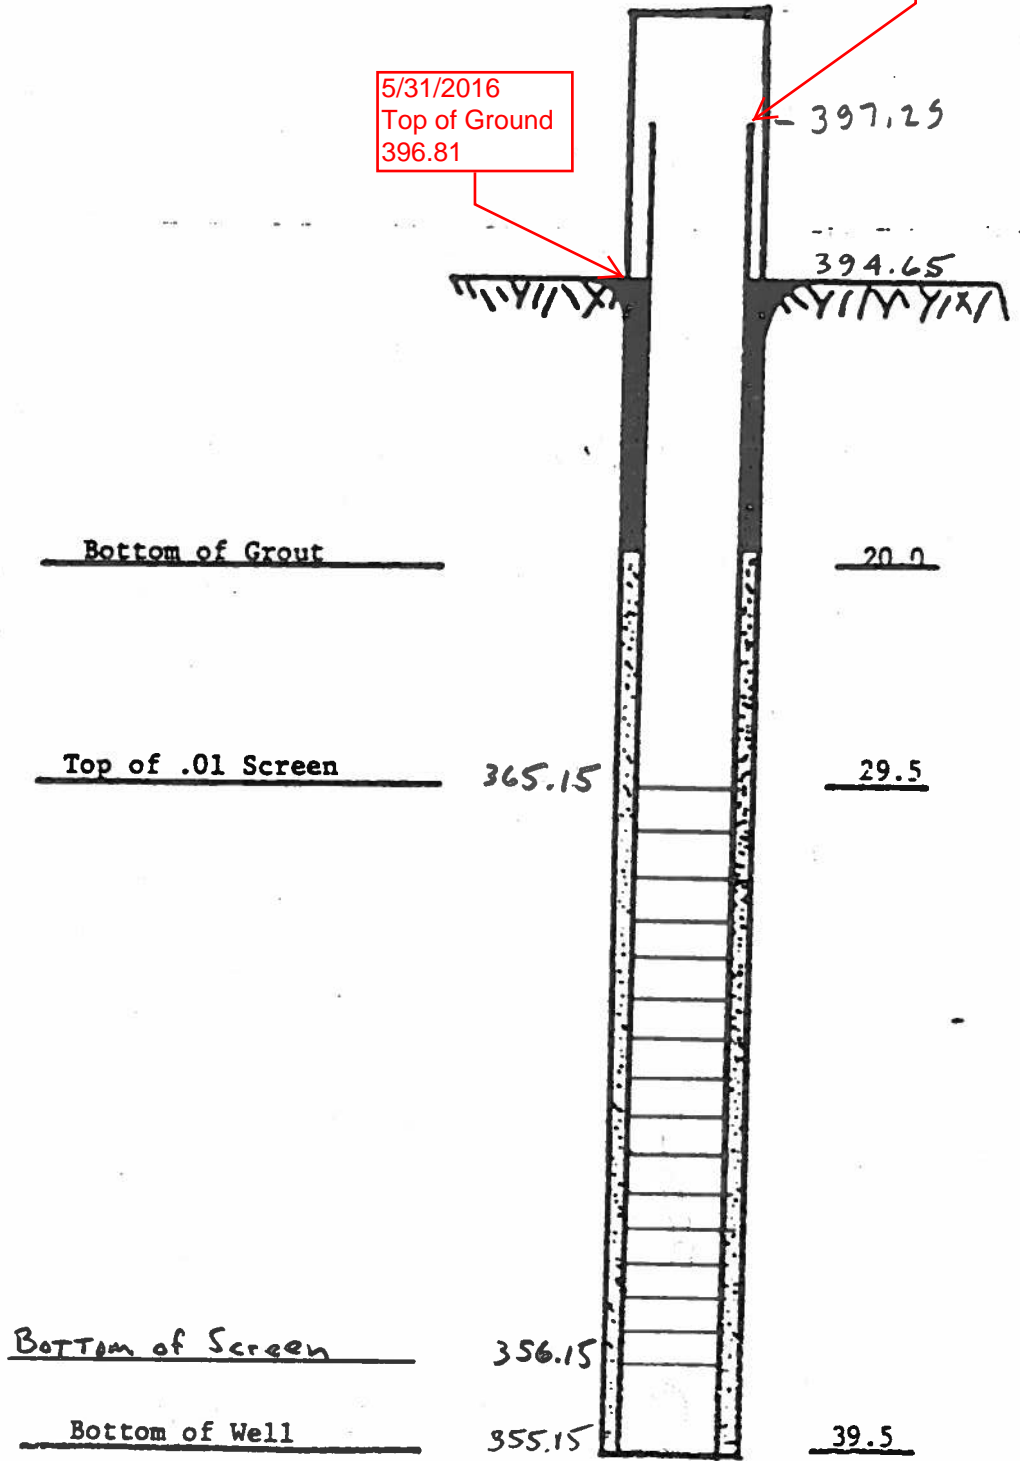


I & M.
Rockport Plant
Ash Storage Area
Well No. 1-M
4-25-84

MW-11

5/31/2016
Reference Point
397.45
(top of 4" coupler,
lid removed)

5/31/2016
Top of Ground
396.77

2" PVC Pipe

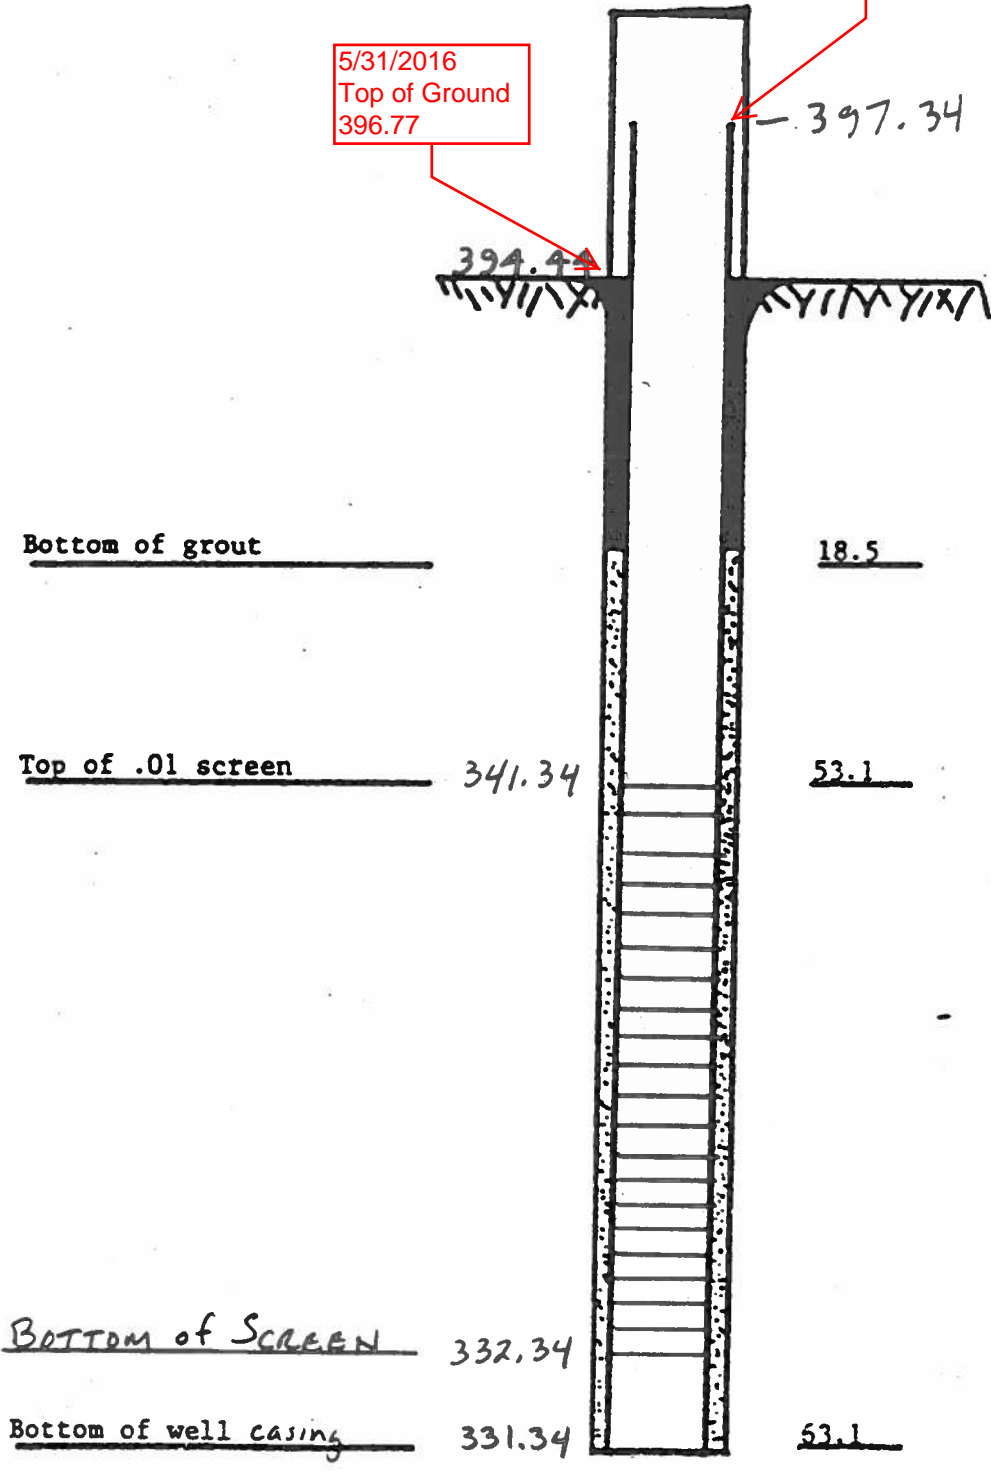


I & M
Rockport Plant
Ash Storage Area
Well No. 1-D
4-24-84

MW-1D

5/31/2016
Reference Point
397.25
(top of 2" PVC pipe)

5/31/2016
Top of Ground
396.40

2" PVC Pipe

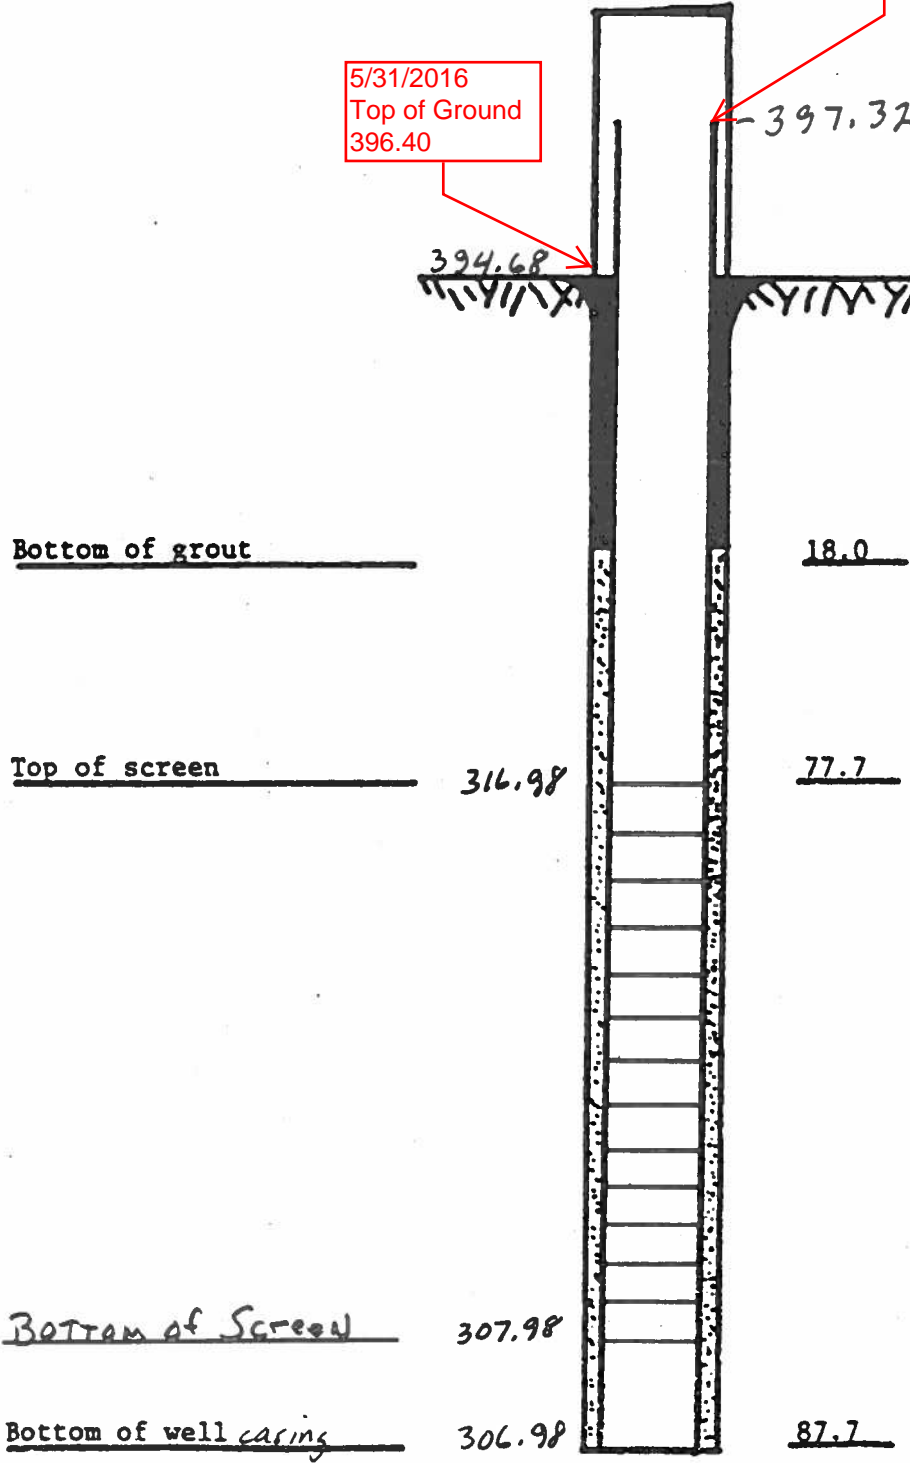

AMEL DAN ELECTRIC POWER SERVICE CO. CORPORATION
AEP CIVIL ENGINEERING LABORATORY
 LOG OF BORING



JOB NUMBER _____
 COMPANY **INDIANA MICHIGAN POWER COMPANY**
 PROJECT **ROCKPORT PLANT**
 COORDINATES **N 162,107.2 E 521,813.6**
 GROUND ELEVATION **395.2** SYSTEM _____

MW-1
 BORING NO. **9901** DATE **4/27/99** SHEET **1** OF **3**
 BORING START **1/18/99** BORING FINISH **1/28/99**
 PIEZOMETER TYPE _____ WELL TYPE **OW**
 HGT. RISER ABOVE GROUND _____ DIA _____
 DEPTH TO TOP OF WELL SCREEN _____ BOTTOM _____
 WELL DEVELOPMENT _____ BACKFILL **Grout**
 FIELD PARTY **MCR-DLB** RIG **BK-81**

WATER LEVEL	▽	▽	▽
TIME			
DATE			

SAMPLE NUMBER	SAMPLE	SAMPLE DEPTH IN FEET		STANDARD PENETRATION RESISTANCE BLOWS / 6"	TOTAL LENGTH RECOVERY	RQD %	DEPTH IN FEET	GRAPHIC LOG	USCS	SOIL / ROCK IDENTIFICATION	WELL	DRILLER'S NOTES
		FROM	TO									
1	SS	0.0	1.5	1-2-2	1.4				CL	BROWN SILTY CLAY		Water for drilling came from fire protection well at the plant.
2	SS	1.5	3.0	2-2-3	1.3				CL	With organic in top 0.8'; moist BROWN SILTY CLAY		
3	SS	3.0	4.5	3-4-6	1.5				CL	Moist BROWNISH GRAY SILTY CLAY		
4	SS	4.5	6.0	5-7-7	1.5		5			Dry		Used approx. 300 gallons of mud to drill boring - 3 bags.
5	SS	6.0	7.5	5-7-6	1.5				SP	REDDISH BROWN SAND		
6	SS	7.5	9.0	2-4-5	1.5				CL	Medium grain; dry.		Used approx. 125 gallons of grout with 5 bags. Grouted from 110.2' to grade.
7	SS	9.0	10.5	3-4-6	1.5		10		CL	BROWN SILTY CLAY Wet		
8	SS	10.5	12.0	4-6-7	1.5					BROWN SILTY CLAY		Used approx. 125 gallons of grout with 5 bags. Grouted from 110.2' to grade.
9	SS	12.0	13.5	3-6-8	1.5					Dry		
10	SS	13.5	15.0	3-3-4	1.5				SP	BROWN SAND Medium grain; dry.		
11	SS	15.0	16.5	4-4-4	1.5		15		SP	BROWN SAND Medium grain with pea size gravel; dry.		
12	SS	16.5	18.0	3-6-6	1.5							
13	SS	18.0	19.5	6-6-8	1.5							
14	SS	19.5	21.0	6-10-10	1.5		20					
15	SS	21.0	22.5	7-9-11	1.5							
16	SS	22.5	24.0	7-8-8	1.5				SP	BROWN SAND With BB to 1/2" gravel; dry.		
17	SS	24.0	25.5	7-8-12	1.5		25					
18	SS	26.9	28.4	5-5-10	1.5				SP	BROWN SAND With BB to 1/2" gravel; wet.		
19	SS	29.5	31.0	3-5-9	1.5		30					
20	SS	31.0	32.5	4-5-6	1.5							
21	SS	32.5	34.0	4-8-9	1.5							
22	SS	34.0	35.5	3-3-3	1.5		35		SP	SAND Medium grain with pea size gravel; wet.		
23	SS	35.5	37.0	6-8-11	1.5				SP	SAND Medium grain with pea to 1/2" gravel; wet.		
24	SS	37.0	38.5	5-12-12	1.5							
25	SS	38.5	40.0	8-6-6	1.5							

TYPE OF CASING USED	
X	NQ-2 ROCK CORE
	6" x 3.25 HSA
	9" x 6.25 HSA
	HW CASING ADVANCER 4"
	NW CASING 3"
	SW CASING 6"
	AIR HAMMER 8"

Continued Next Page

PIEZOMETER TYPE: PT = OPEN TUBE POROUS TIP, SS = OPEN TUBE SLOTTED SCREEN, G = GEONOR, P = PNEUMATIC

WELL TYPE: OW = OPEN TUBE SLOTTED SCREEN, GM = GEOMON

RECORDER **DLB**

AEP RKPT.GPJ AEP_FULL.GDT 4/27/99

AME AN ELECTRIC POWER SERVICE COF RATION
AEP CIVIL ENGINEERING LABORATORY
 LOG OF BORING



JOB NUMBER _____

COMPANY **INDIANA MICHIGAN POWER COMPANY**

BORING NO. **9901** DATE **4/27/99** SHEET **2** OF **3**

PROJECT **ROCKPORT PLANT**

BORING START **1/18/99** BORING FINISH **1/28/99**

SAMPLE NUMBER	SAMPLE	SAMPLE DEPTH IN FEET		STANDARD PENETRATION RESISTANCE BLOWS / 6"	TOTAL LENGTH RECOVERY	RQD %	DEPTH IN FEET	GRAPHIC LOG	USCS	SOIL / ROCK IDENTIFICATION	WELL	DRILLER'S NOTES
		FROM	TO									
26	SS	41.9	43.4	9-12-14	1.5		45					
27	SS	46.9	48.4	8-8-8	1.5		50					
28	SS	51.9	53.4	4-8-11	1.5		55					
29	SS	53.4	54.9	5-10-12	1.5		55					
30	SS	54.9	56.4	4-7-9	1.3		55		SP	LIGHT BROWN POORLY GRADED SAND With fine to 3/4" gravel; wet.		
31	SS	56.4	57.9	10-9-10	1.4		55		SP	SAND		
32	SS	57.9	59.4	7-14-12	1.5		55		SP	Medium grain with few pea size gravel; wet. SAND		
33	SS	59.4	60.9	6-10-13	1.5		60		SP	Medium grain with pea to 3/4" gravel; wet. POORLY GRADED SAND		
34	SS	60.9	62.4	9-13-12	1.5		60		SW	Wet. LIGHT BROWN WELL GRADED SAND		
35	SS	62.4	63.9	7-7-10	1.5		65			Medium grain; wet.		
36	SS	66.9	68.4	7-11-16	1.5		70					
37	SS	71.9	73.4	7-7-10	1.5		75		SP	LIGHT BROWN POORLY GRADED SAND Fine to medium grained; wet.		
38	SS	76.9	78.4	4-5-5	1.5		80		SP	POORLY GRADED SAND With pea size gravel; wet.		
39	SS	78.4	80.4	4-4-5-7	1.9		80					
40	SS	80.4	82.4	3-4-5-6	1.8		80					
41	SS	82.4	84.4	2-3-5-5	2.0		80		SW	LIGHT BROWN WELL GRADED SAND		
42	SS	84.4	86.4	1-3-4-6	2.0		85		SP	Medium grain; wet. LIGHT BROWN POORLY GRADED SAND		
43	SS	86.4	88.4	3-4-9-10	2.0		85		SP	Wet. POORLY GRADED SAND		
							90		SP	With fine gravel; wet. SAND		
										Medium grain with few 1/2" gravel; wet.		

RECEIVED
JUN 28 1999
 DEPARTMENT OF ENVIRONMENTAL MANAGEMENT
 SOLID & HAZARDOUS WASTE MANAGEMENT

Started SPT on 2.0' centers at 78.4'.

AEP RKPT.GPJ AEP_FULL_GDT 4/27/99

Continued Next Page

AME AN ELECTRIC POWER SERVICE COF RATION
AEP CIVIL ENGINEERING LABORATORY
 LOG OF BORING



JOB NUMBER _____

COMPANY **INDIANA MICHIGAN POWER COMPANY**

BORING NO. **9901** DATE **4/27/99** SHEET **3** OF **3**


PROJECT **ROCKPORT PLANT**

BORING START **1/18/99** BORING FINISH **1/28/99**

SAMPLE NUMBER	SAMPLE	SAMPLE DEPTH IN FEET		STANDARD PENETRATION RESISTANCE BLOWS / 6"	TOTAL LENGTH RECOVERY	RQD %	DEPTH IN FEET	GRAPHIC LOG	USCS	SOIL / ROCK IDENTIFICATION	WELL	DRILLER'S NOTES
		FROM	TO									
44	SS	91.9	93.9	9-10-14-13	2.0		95					
45	SS	96.9	98.9	5-9-14-20	2.0		100					
46	SS	101.9	103.4	11-12-15	1.5		105		SP	SAND Medium grained with few 1/2" gravel; wet.		
47	SS	106.9	108.4	3-14-20	1.4				CL	SANDY CLAY With 3/4" gravel.		
48	SS	109.5	110.1	30-50/1	0.5		110			COAL		

Spoon refusal at 110.1'
 Auger refusal at 110.2'

AEP RKPT.GPJ AEP_FULL.GDT 4/27/99

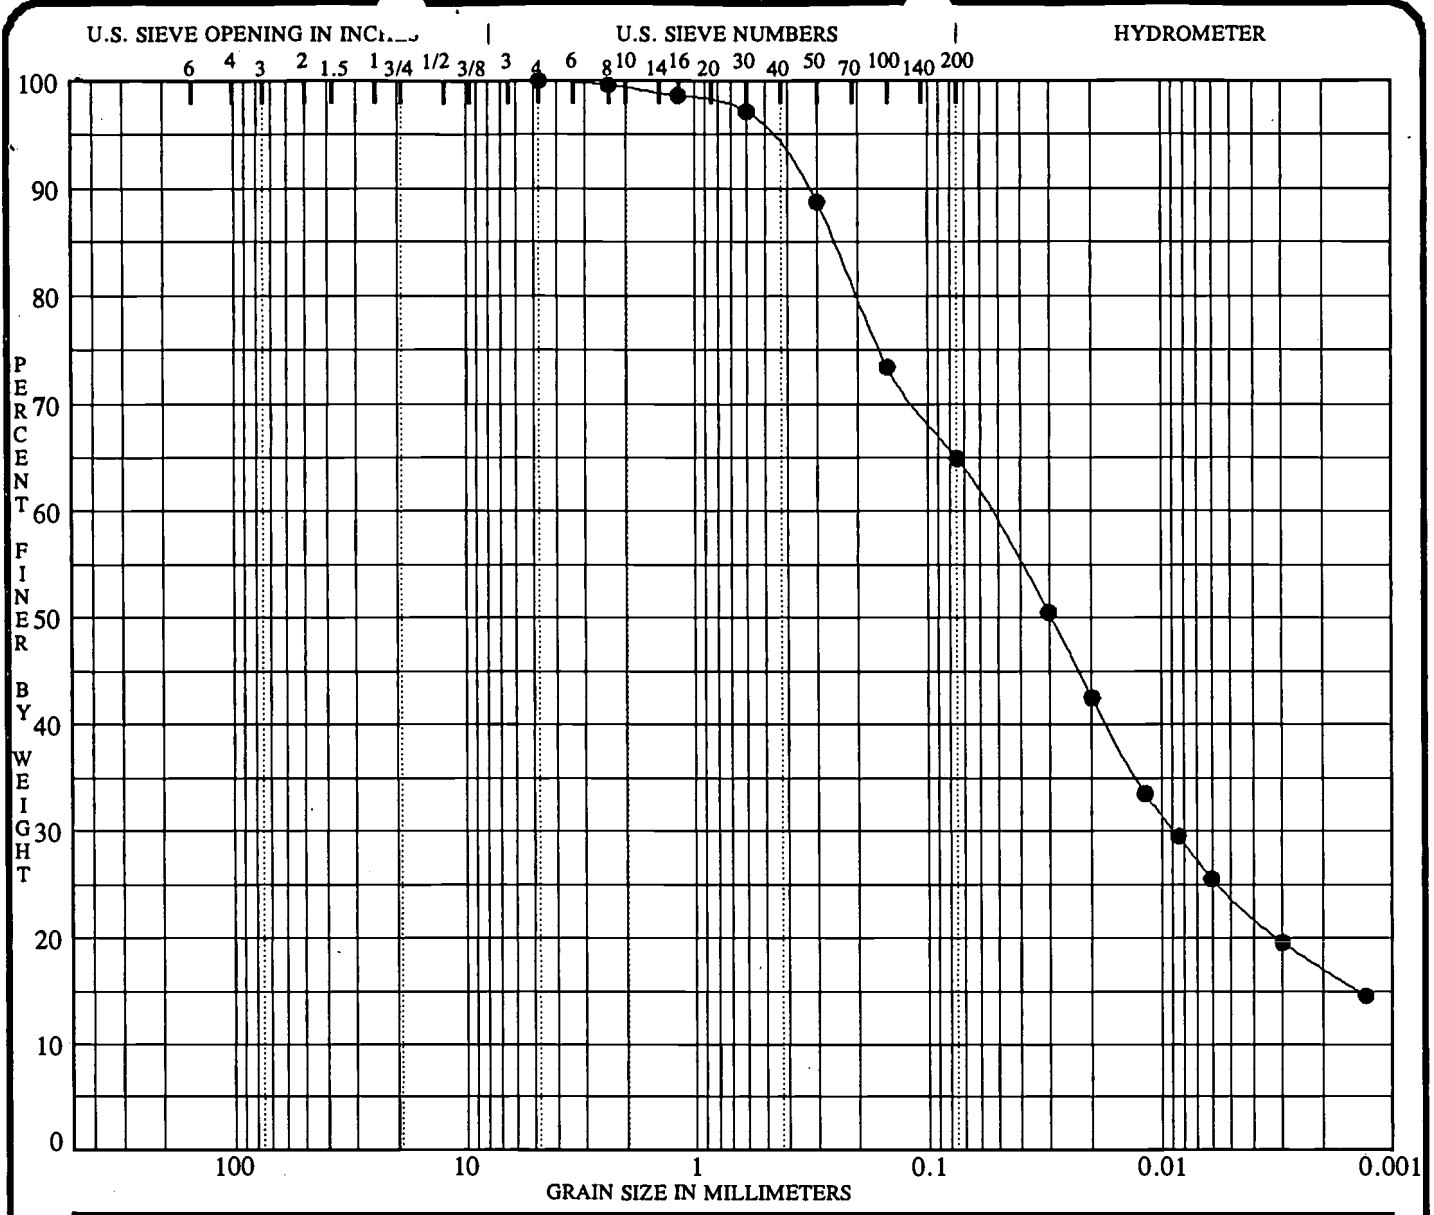

COBBLES	GRAVEL		SAND			SILT OR CLAY
	coarse	fine	coarse	medium	fine	


Specimen Identification	Classification	MC%	LL	PL	PI	Sp.Gr.
● 9901 1.5			26.0	15.9	10.1	
	SANDY LEAN CLAY CL					
	COMPOSITE 1.5'-6.0'					

Specimen Identification	D100	D60	D30	D10	%Gravel	%Sand	%Fines	% < .002
● 9901 1.5	4.750	0.055	0.009		0.0	35.1	64.9	17.2

PROJECT ROCKPORT PLANT - ROCKPORT, INDIANA JOB NO. WO#SC3750
DATE _____ DATE 06/01/99

GRADATION CURVES
American Electric Power Service Corp.
Groveport, Ohio



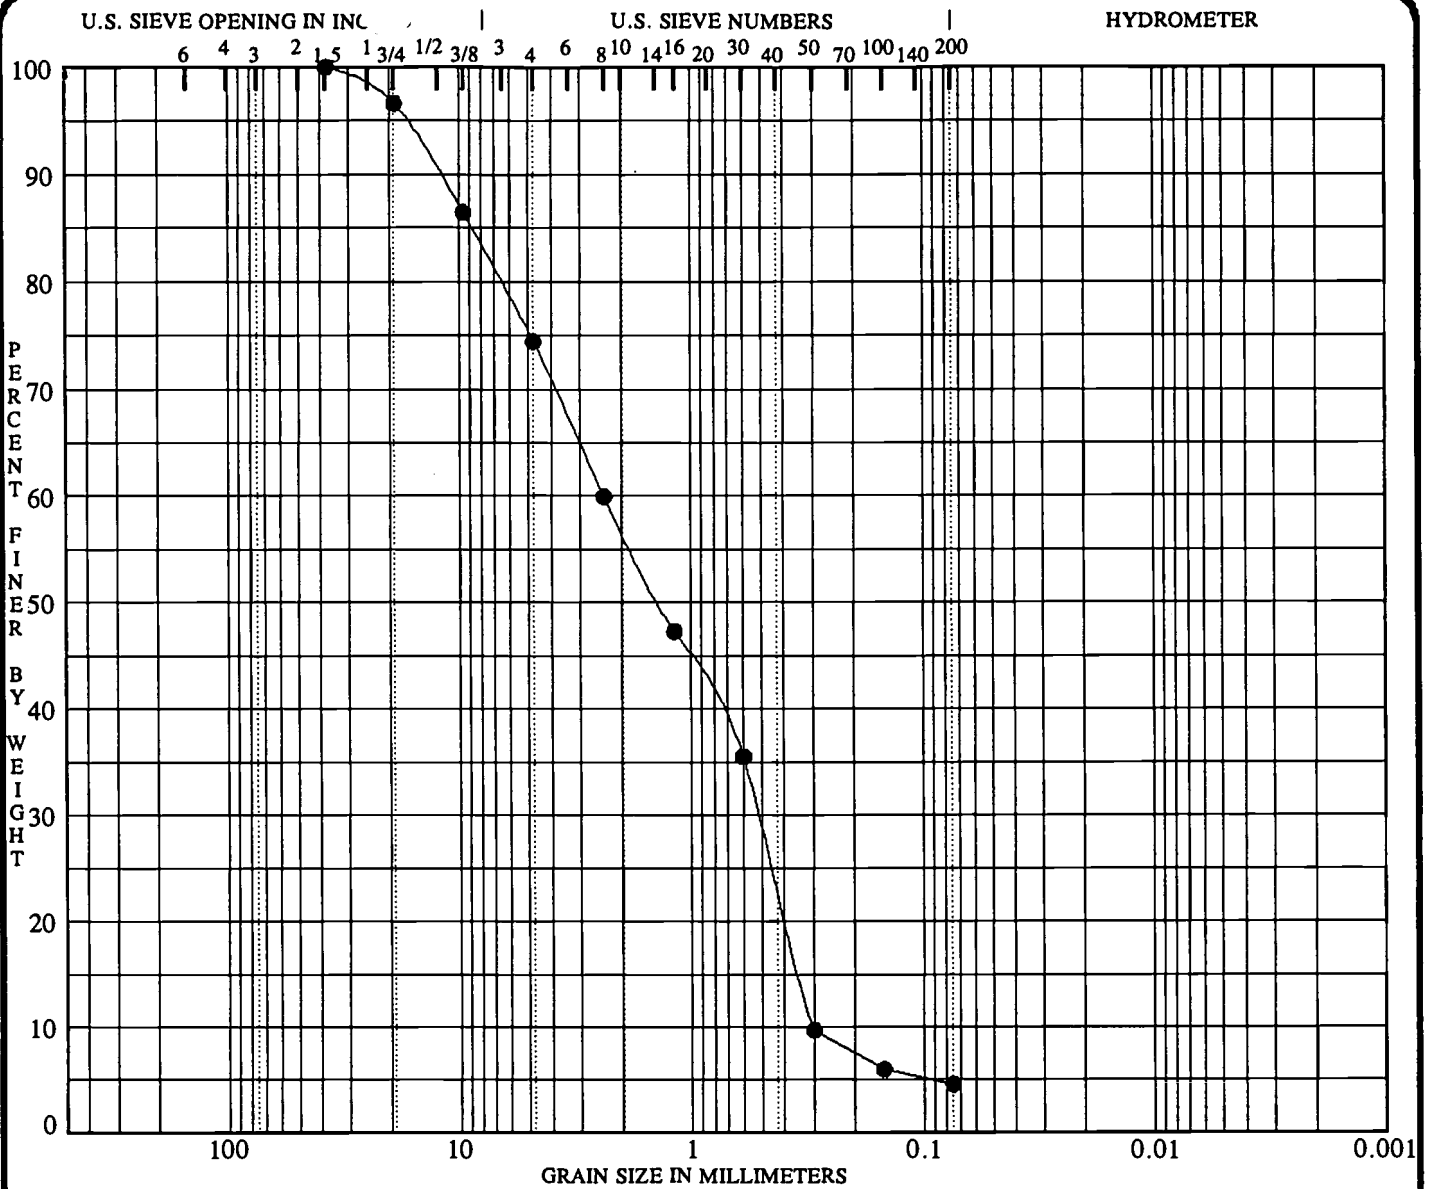

COBBLES	GRAVEL		SAND			SILT OR CLAY
	coarse	fine	coarse	medium	fine	


Specimen Identification	Classification	MC%	LL	PL	PI	Sp.Gr.
● 9901 29.5			NP	NP	NP	
POORLY GRADED SAND with SILT and GRAVEL SP-SM						
WELL #1-S COMPOSITE SAMPLE 29.5'-40.0'						

Specimen Identification	D100	D60	D30	D10	%Gravel	%Sand	%Fines	% < .002
● 9901 29.5	37.500	2.371	0.518	0.302	25.6	69.8	4.6	

PROJECT ROCKPORT PLANT - ROCKPORT, INDIANA JOB NO. WO#1352
 DATE 04/22/99

GRADATION CURVES
 American Electric Power Service Corp.
 Groveport, Ohio



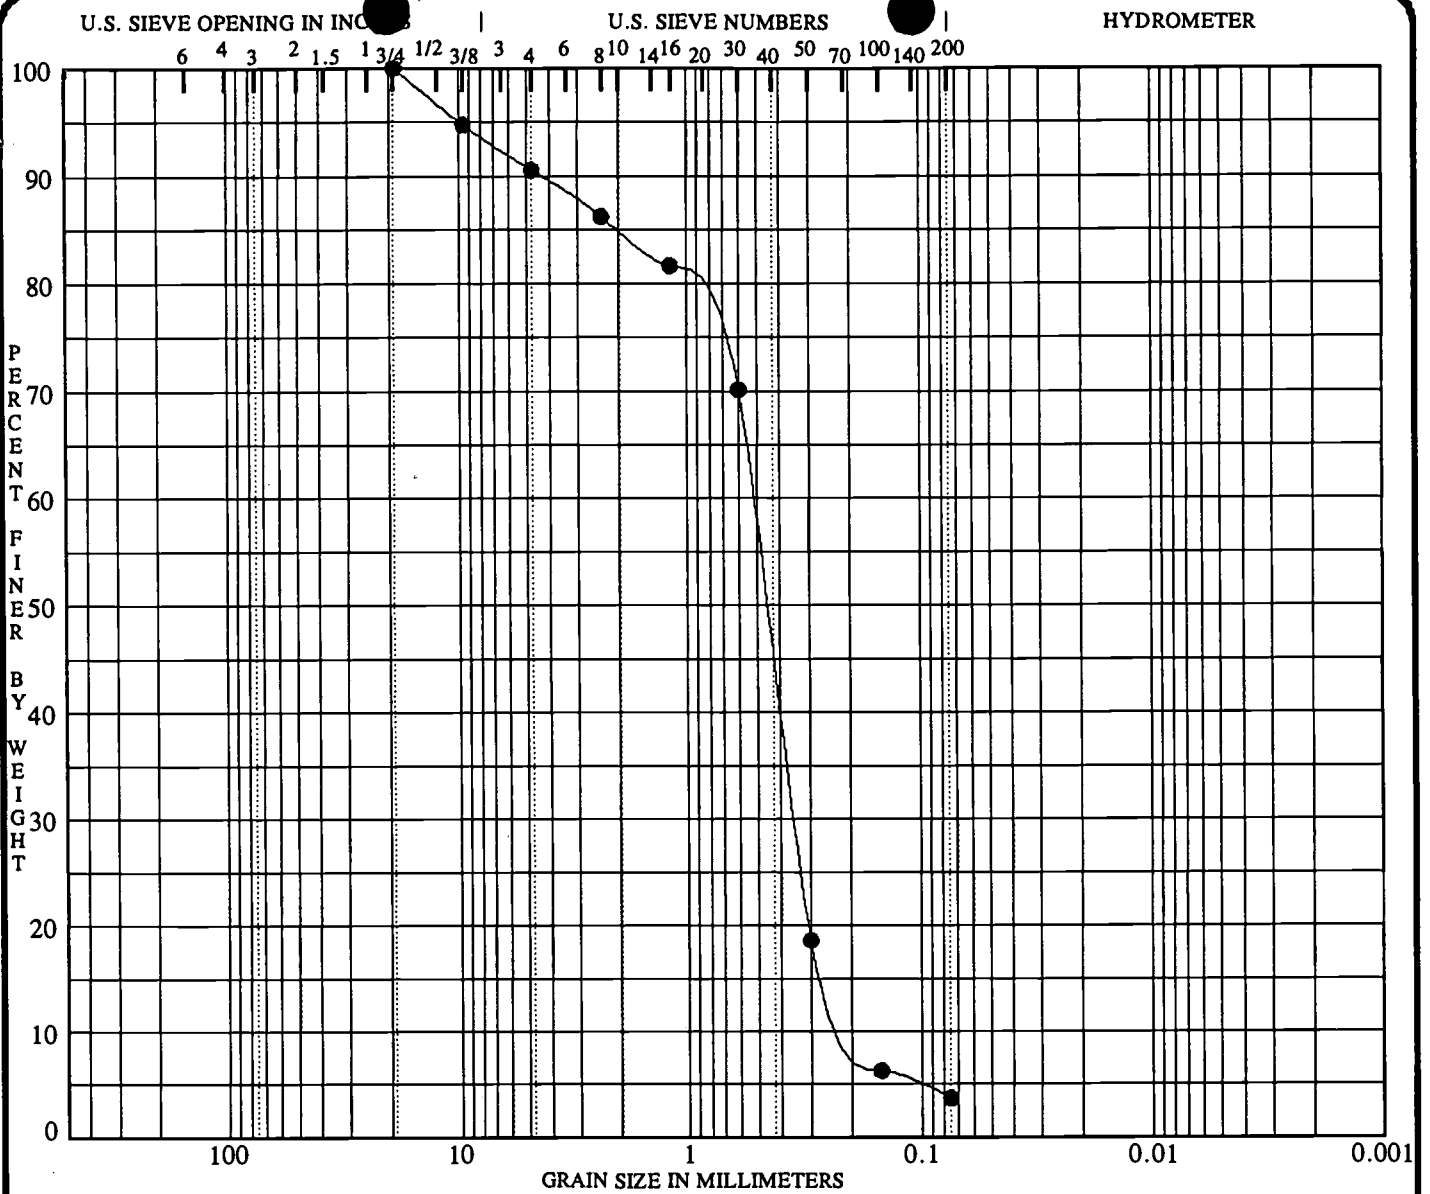

COBBLES	GRAVEL		SAND			SILT OR CLAY
	coarse	fine	coarse	medium	fine	


Specimen Identification	Classification	MC%	LL	PL	PI	Sp.Gr.
● 9901 51.9			NP	NP	NP	
	POORLY GRADED SAND SP					
	WELL #1-I COMPOSITE SAMPLE 51.9'-63.9'					

Specimen Identification	D100	D60	D30	D10	%Gravel	%Sand	%Fines	% < .002
● 9901 51.9	19.000	0.524	0.350	0.185	9.5	86.8	3.7	

PROJECT ROCKPORT PLANT - ROCKPORT, INDIANA JOB NO. WO#1352
 DATE 04/22/99

GRADATION CURVES
 American Electric Power Service Corp.
 Groveport, Ohio



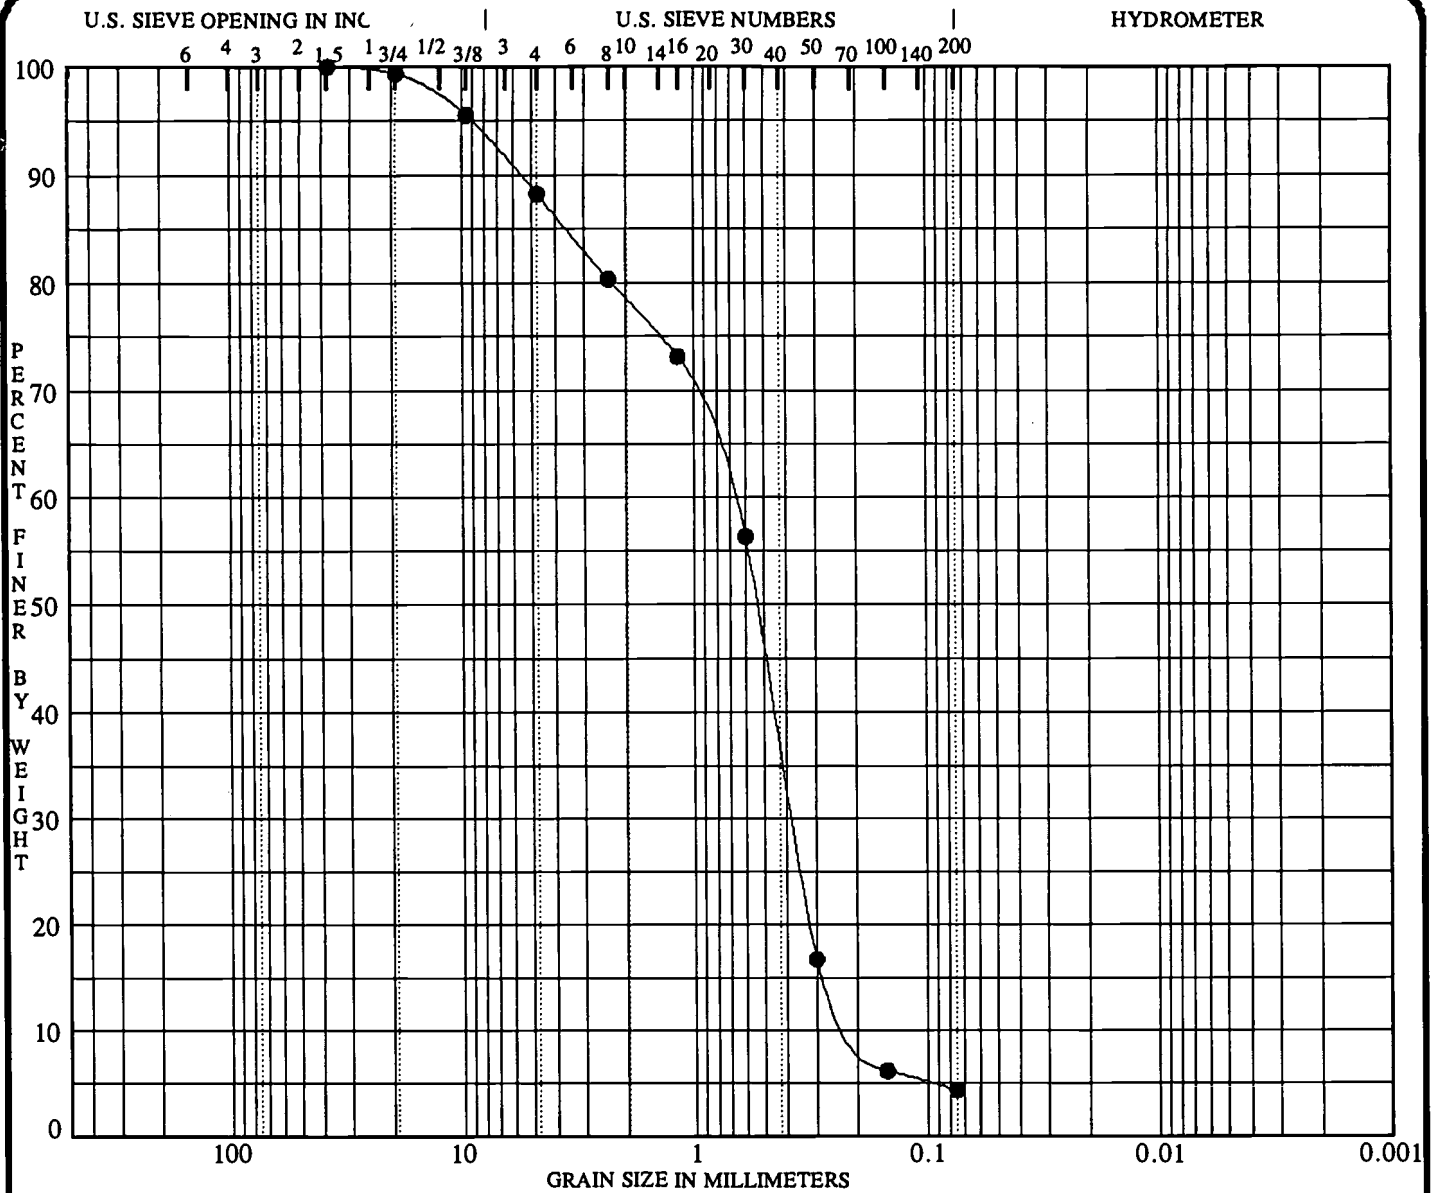

COBBLES	GRAVEL		SAND			SILT OR CLAY
	coarse	fine	coarse	medium	fine	

Specimen Identification	Classification	MC%	LL	PL	PI	Sp.Gr.
● 9901 76.9			NP	NP	NP	
	POORLY GRADED SAND SP					
	WELL #1-D COMPOSITE SAMPLE 76.9'-88.4'					

Specimen Identification	D100	D60	D30	D10	%Gravel	%Sand	%Fines	% < .002
● 9901 76.9	37.500	0.696	0.379	0.193	11.8	83.8	4.4	

PROJECT ROCKPORT PLANT - ROCKPORT, INDIANA JOB NO. WO#1352
 DATE 04/22/99

GRADATION CURVES
 American Electric Power Service Corp.
 Groveport, Ohio




I & M
Rockport Plant
Ash Storage Area
Well No. 2S
5-16-84

MW-2S

5/31/2016
Reference Point
399.27
(top of 4" coupler,
lid removed)

5/31/2016
Top of Ground
398.19

2" PVC Pipe

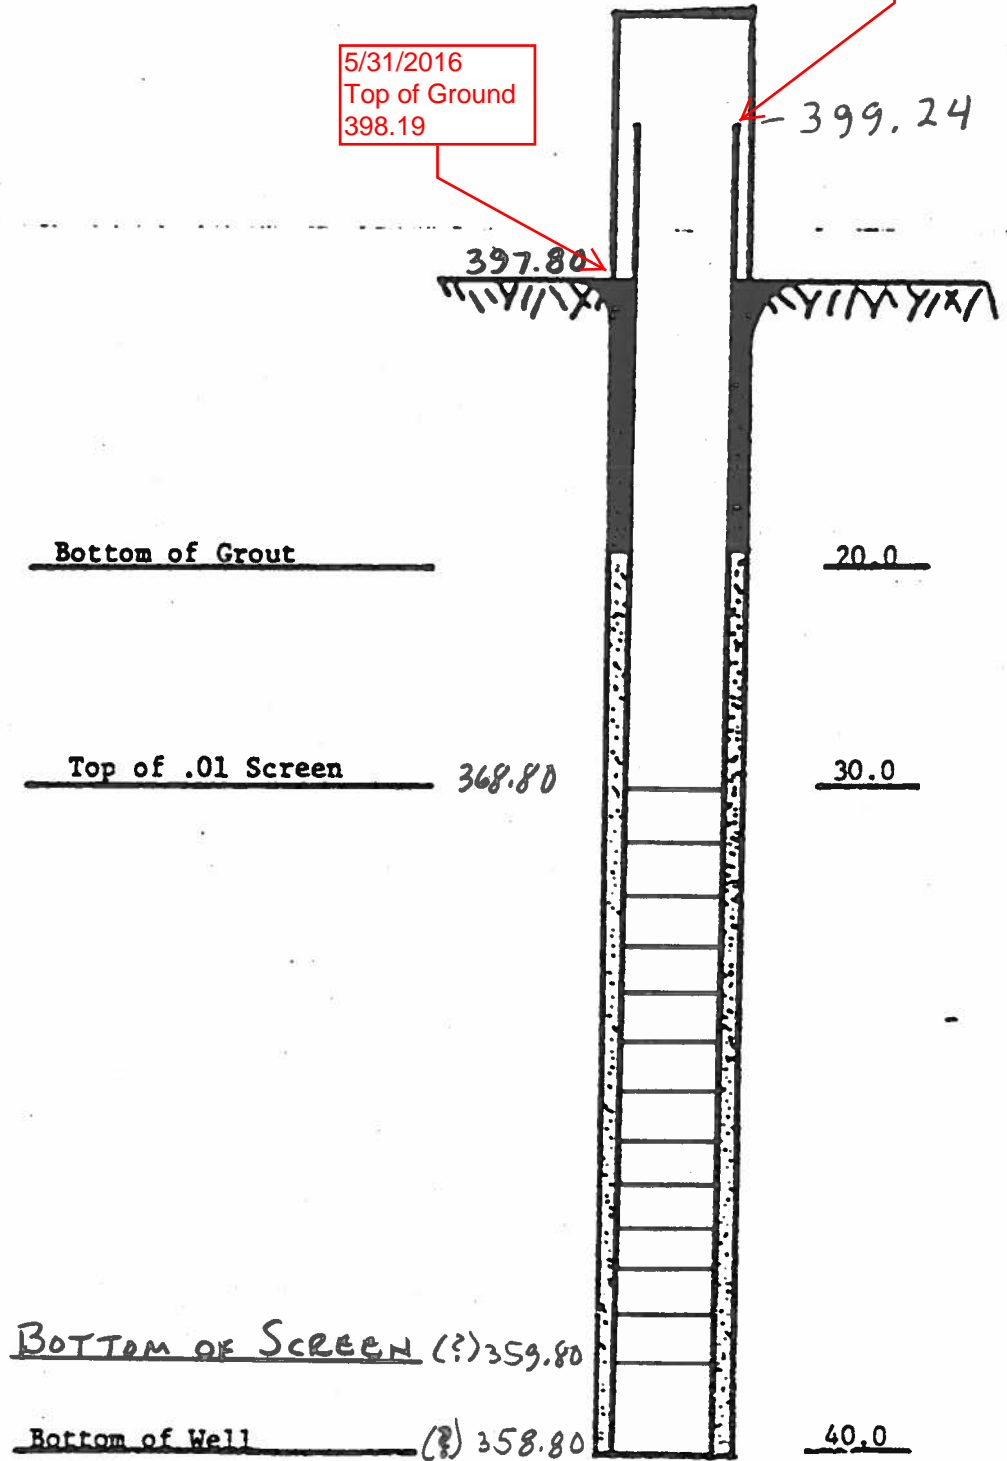


I & M
Rockport Plant
Ash Storage Area
Well No. 2I
5-15-84

MW-2I

5/31/2016
Reference Point
399.42
(top of 4" coupler,
lid removed)

5/31/2016
Top of Ground
398.39

2" PVC Pipe

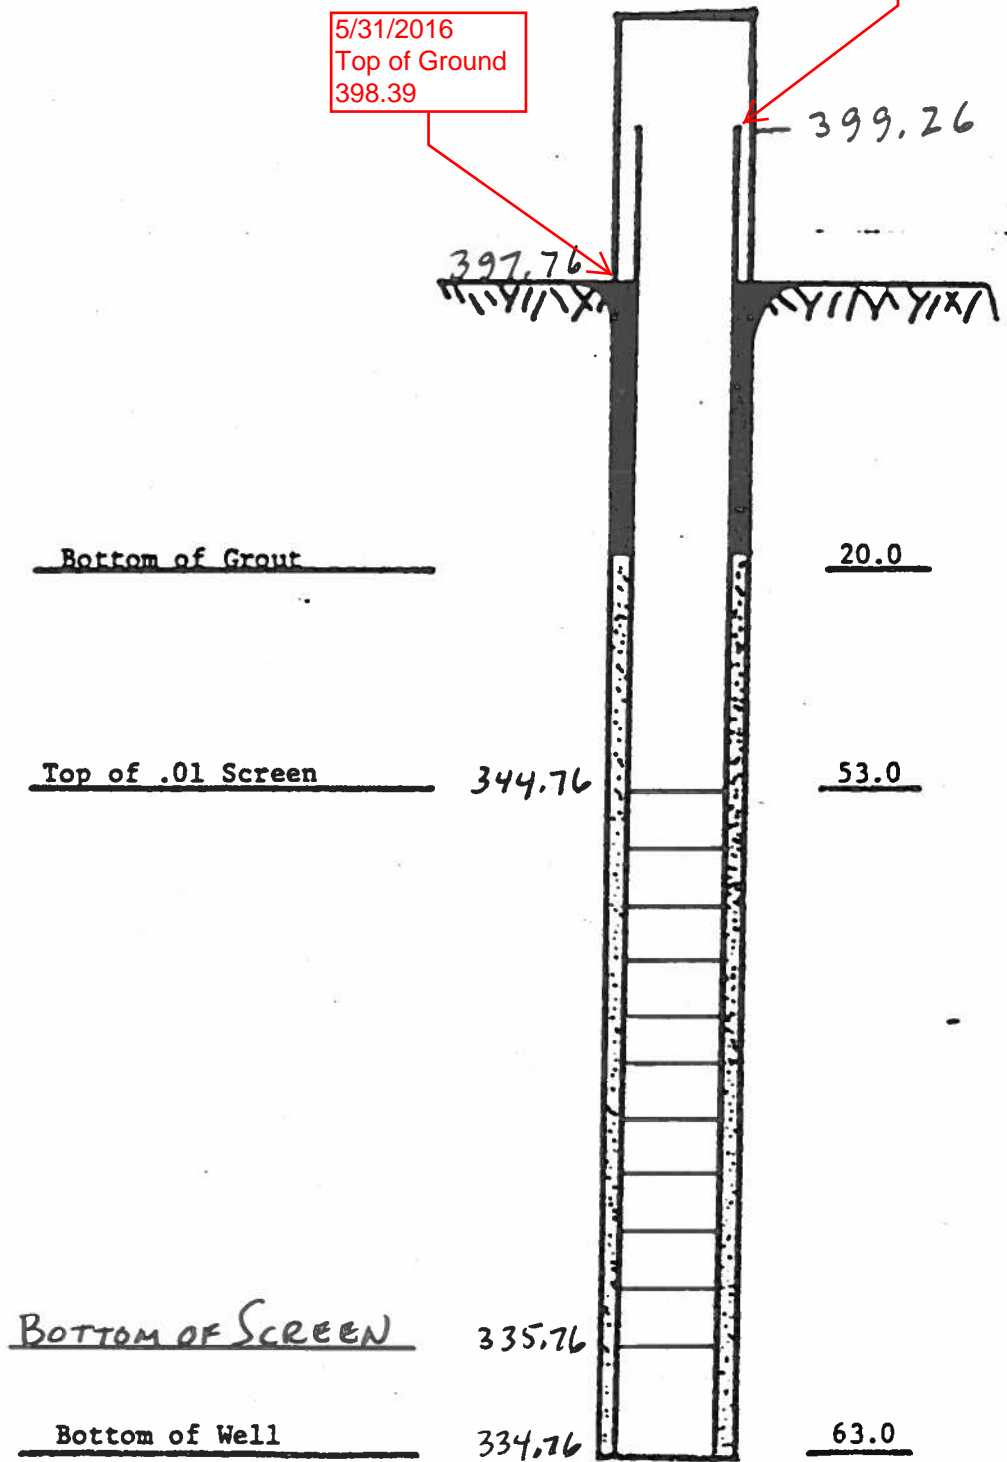


I & M
Rockport Plant
Ash Storage Area
Well No. 2D
5-15-84

MW-2D

5/31/2016
Reference Point
399.37
(top of 4" coupler,
lid removed)

5/31/2016
Top of Ground
398.30

2" PVC Pipe

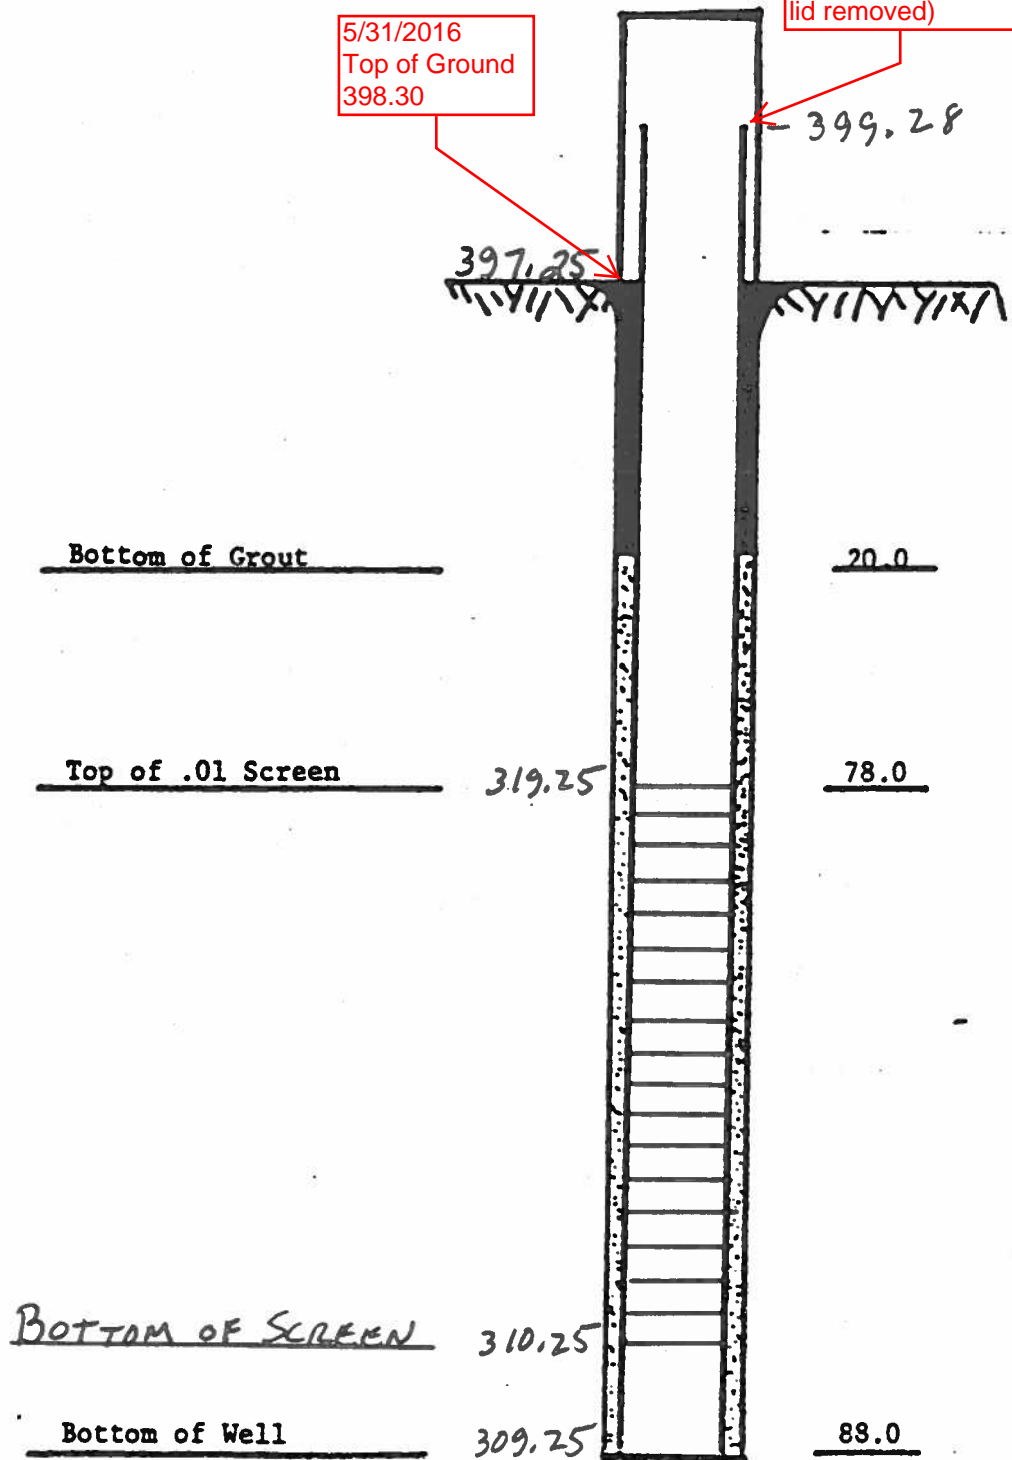

AME CAN ELECTRIC POWER SERVICE CO. CORPORATION
AEP CIVIL ENGINEERING LABORATORY
 LOG OF BORING



JOB NUMBER _____
 COMPANY **INDIANA MICHIGAN POWER COMPANY**
 PROJECT **ROCKPORT PLANT**
 COORDINATES **N 160,790.3 E 518,916.4**
 GROUND ELEVATION **397.3** SYSTEM _____

MW-2
 BORING NO. **9902** DATE **4/27/99** SHEET **1** OF **3**
 BORING START **1/14/99** BORING FINISH **1/15/99**
 PIEZOMETER TYPE _____ WELL TYPE **OW**
 HGT. RISER ABOVE GROUND _____ DIA _____
 DEPTH TO TOP OF WELL SCREEN _____ BOTTOM _____
 WELL DEVELOPMENT _____ BACKFILL **Grout**
 FIELD PARTY **MCR-DLB** RIG **BK-81**

WATER LEVEL	▽	▽	▽
TIME			
DATE			

SAMPLE NUMBER	SAMPLE	SAMPLE DEPTH IN FEET		STANDARD PENETRATION RESISTANCE BLOWS / 6"	TOTAL LENGTH RECOVERY	RQD %	DEPTH IN FEET	GRAPHIC LOG	USCS	SOIL / ROCK IDENTIFICATION	WELL	DRILLER'S NOTES
		FROM	TO									
1	SS	0.0	1.5	1-2-3	1.0				CL	LIGHT BROWN FINE GRAIN SANDY CLAY Dry		Water for drilling and grouting from fire protection well at Rockport Plant.
2	SS	1.5	3.0	1-2-2	1.0							
3	SS	3.0	4.5	3-4-5	1.5							
4	SS	4.5	6.0	4-6-6	1.6		5		SP	DARK BROWN MEDIUM GRAIN SAND Dry		Grouted from 107.8' to grade; used approx. 100 gallons (4 bags).
5	SS	6.0	7.5	3-6-4	1.5				CL	BROWN SANDY CLAY		
6	SS	7.5	9.0	2-3-3	1.5				SP	Moist		
7	SS	9.0	10.5	3-3-5	1.5		10		CL	BROWN MEDIUM GRAIN SAND Moist		
8	SS	10.5	12.0	3-5-6	1.5					BROWN SILTY CLAY Moist		
9	SS	12.0	13.5	3-5-7	1.5				SP	BROWN MEDIUM GRAIN SAND		
10	SS	13.5	15.0	6-12-13	1.3				CL	BROWN SILTY CLAY		
11	SS	15.0	16.5	7-10-10	1.5		15		SP	LIGHT BROWN MEDIUM GRAIN SAND Dry		Used approx. 150 gallons (3 bags) drill mud while drilling hole.
12	SS	16.5	18.0	5-5-5	1.5				CL	BROWN SILTY CLAY		
13	SS	18.0	19.5	4-5-7	1.5				SP	MEDIUM GRAIN BROWN SAND Dry		
14	SS	19.5	21.0	5-5-8	1.5		20					
15	SS	21.0	22.5	5-7-9	1.5							
16	SS	22.5	24.0	4-5-6	1.3							
17	SS	24.0	25.5	3-5-7	1.5							
18	SS	26.4	27.9	8-8-6	1.3		25		SP	BROWN MEDIUM GRAIN SAND With BB size gravel, dry.		
									SP	BROWN MEDIUM GRAIN SAND With pea size gravel, dry.		
19	SS	30.0	31.5	5-9-12	1.5		30					
20	SS	31.5	33.0	6-6-8	1.5				SP	BROWN SAND With pea to 1/2" gravel, wet.		
21	SS	33.0	34.5	4-5-5	1.3							
22	SS	34.5	36.0	4-5-5	1.5		35					
23	SS	36.0	37.5	5-4-7	1.5							
24	SS	37.5	39.0	3-4-6	1.5							

AEP RPT.GPJ AEP_FULL.GDT 4/27/99

TYPE OF CASING USED

X	NQ-2 ROCK CORE	
	6" x 3.25 HSA	
	9" x 6.25 HSA	
	HW CASING ADVANCER	4"
	NW CASING	3"
	SW CASING	6"
	AIR HAMMER	8"

Continued Next Page

PIEZOMETER TYPE: PT = OPEN TUBE POROUS TIP, SS = OPEN TUBE SLOTTED SCREEN, G = GEONOR, P = PNEUMATIC
 WELL TYPE: OW = OPEN TUBE SLOTTED SCREEN, GM = GEOMON

RECORDER **DLB**

AME CAN ELECTRIC POWER SERVICE CO. CORPORATION
AEP CIVIL ENGINEERING LABORATORY
 LOG OF BORING



JOB NUMBER _____

COMPANY **INDIANA MICHIGAN POWER COMPANY**

BORING NO. **9902** DATE **4/27/99** SHEET **2** OF **3**

PROJECT **ROCKPORT PLANT**

BORING START **1/14/99** BORING FINISH **1/15/99**

SAMPLE NUMBER	SAMPLE	SAMPLE DEPTH IN FEET		STANDARD PENETRATION RESISTANCE BLOWS / 6"	TOTAL LENGTH RECOVERY	RQD %	DEPTH IN FEET	GRAPHIC LOG	USCS	SOIL / ROCK IDENTIFICATION	WELL	DRILLER'S NOTES
		FROM	TO									
25	SS	39.0	40.5	8-8-8	1.5							
26	SS	41.4	42.9	4-7-17	1.5							
27	SS	46.4	47.9	3-8-7	1.5		45					
28	SS	51.4	52.9	10-10-13	1.5		50					
29	SS	53.0	54.5	5-5-7	1.5			SP		FINE SAND		
30	SS	54.5	66.0	4-6-7	1.5			SP		With BB size gravel, wet.		
31	SS	56.0	57.5	8-7-8	1.5			SP		BROWN MEDIUM GRAIN SAND		
32	SS	57.5	59.0	4-6-8	1.5					With pea to 1/2" gravel, wet.		
33	SS	59.0	60.5	4-6-8	1.5			SP		MEDIUM GRAIN SAND		
34	SS	60.5	62.0	4-6-8	1.5					With pea size gravel, wet.		
35	SS	62.0	63.5	4-7-8	1.5			SP		FINE GRAIN SAND		
36	SS	66.9	68.4	6-6-8	1.5					With BB size gravel, wet.		
37	SS	71.9	73.4	5-6-8	1.5			CL		MEDIUM GRAIN SAND		
38	SS	76.9	78.4	7-5-4	1.5					With pea to 1/2" gravel, wet.		
39	SS	78.4	79.9	3-3-3	1.5			SP		GRAY SILTY CLAY		
40	SS	79.9	81.4	3-5-6	1.5					Moist		
41	SS	81.4	82.9	4-6-6	1.5			SP		BROWN MEDIUM GRAIN SAND		
42	SS	82.9	84.4	5-4-6	1.5					With pea size gravel, wet.		
43	SS	84.9	85.9	4-4-5	1.5							
44	SS	85.9	87.4	2-4-6	1.5							
45	SS	87.4	88.9	4-5-6	1.5			SP		BROWN FINE GRAIN SAND		
										With BB size gravel, wet.		

AEP RKPT.GPJ AEP_FULL.GDT 4/27/99

Continued Next Page

AME IAN ELECTRIC POWER SERVICE CO. CORPORATION
AEP CIVIL ENGINEERING LABORATORY
 LOG OF BORING



JOB NUMBER _____


COMPANY INDIANA MICHIGAN POWER COMPANY

BORING NO. 9902 DATE 4/27/99 SHEET 3 OF 3

PROJECT ROCKPORT PLANT

BORING START 1/14/99 BORING FINISH 1/15/99

SAMPLE NUMBER	SAMPLE	SAMPLE DEPTH IN FEET		STANDARD PENETRATION RESISTANCE BLOWS / 6"	TOTAL LENGTH RECOVERY	RQD	DEPTH IN FEET	GRAPHIC LOG	USCS	SOIL / ROCK IDENTIFICATION	WELL	DRILLER'S NOTES
		FROM	TO			%						
46	SS	91.4	92.9	5-5-6	1.5		95					
47	SS	96.4	97.9	5-5-5	1.5		100	SP		MEDIUM GRAIN SAND With BB to pea size gravel, wet.		
48	SS	101.4	102.9	6-7-8	1.5		105	SP		BROWN MEDIUM GRAIN SAND With pea to 1/2" gravel, wet.		
49	SS	106.4	107.8	4-6-50/4	1.3			SP		BROWN MEDIUM GRAIN SAND With BB to pea size gravel, wet. SHALE		Spoon refusal at 107.8' Stopped boring at 107.8'

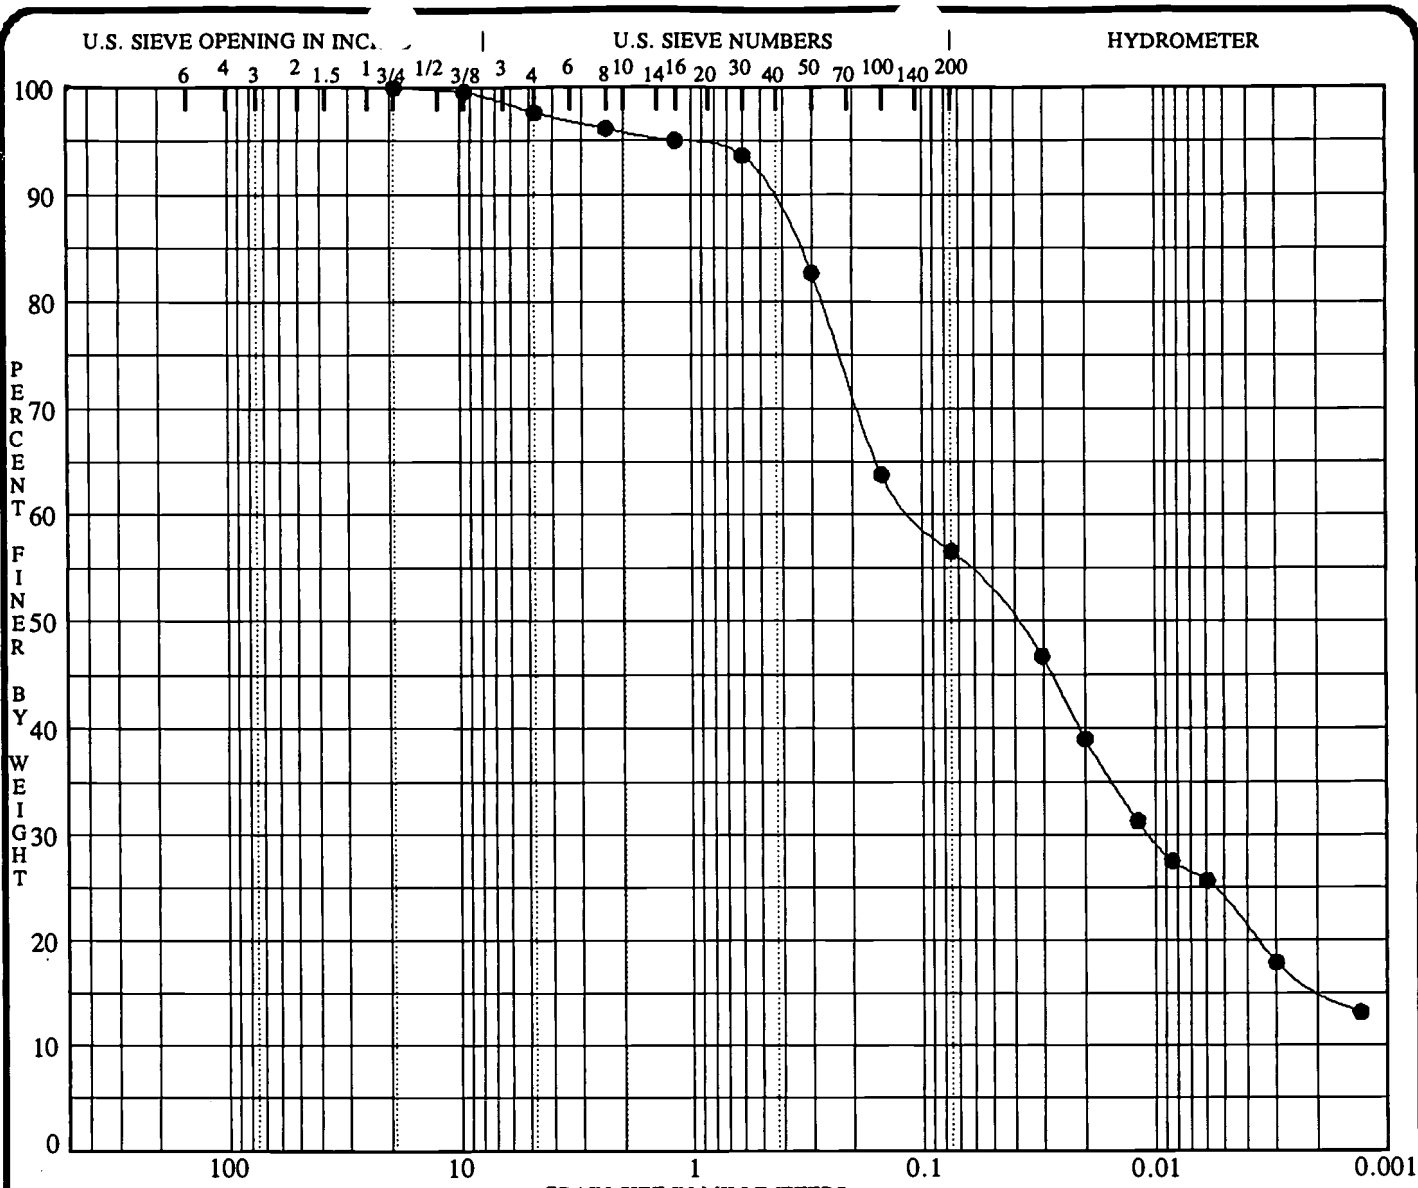

COBBLES	GRAVEL		SAND			SILT OR CLAY
	coarse	fine	coarse	medium	fine	


Specimen Identification	Classification	MC%	LL	PL	PI	Sp.Gr.
● 9902 1.5			24.3	15.8	8.5	
	SANDY LEAN CLAY CL					
	COMPOSITE 1.5'-4.5'					

Specimen Identification	D100	D60	D30	D10	%Gravel	%Sand	%Fines	% < .002
● 9902 1.5	19.000	0.105	0.011		2.4	41.1	56.5	15.6

PROJECT ROCKPORT PLANT - ROCKPORT, INDIANA JOB NO. WO#SC3750
 DATE 06/01/99

GRADATION CURVES
 American Electric Power Service Corp.
 Groveport, Ohio



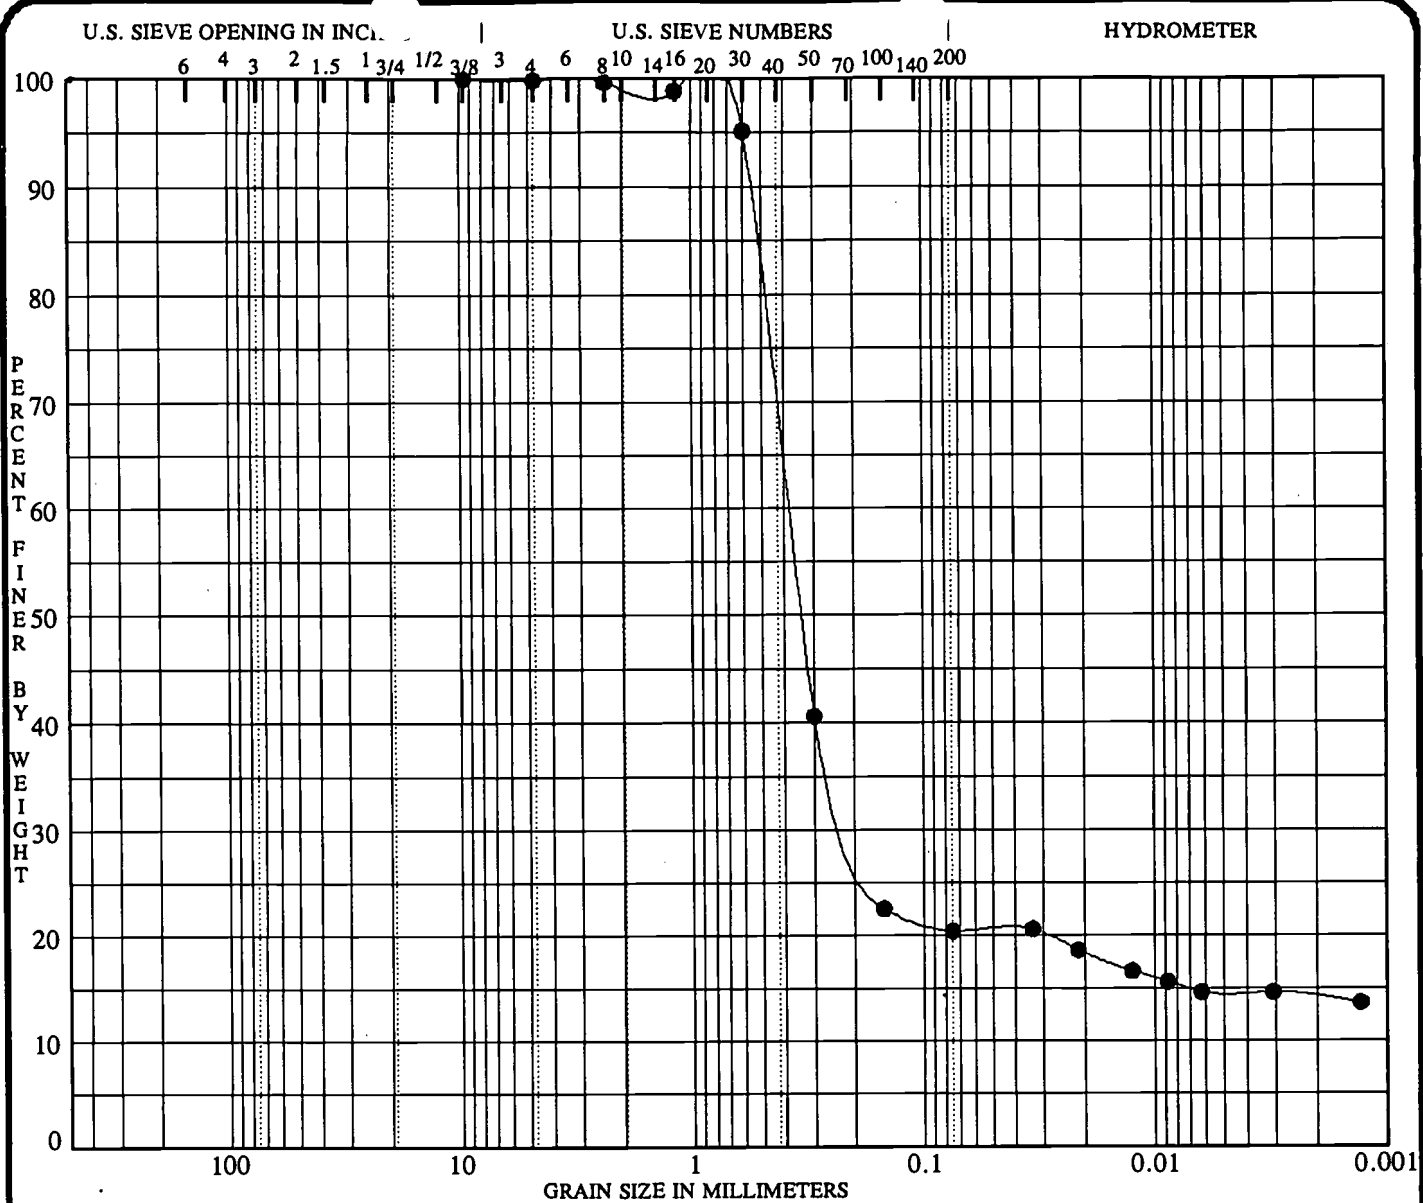

COBBLES	GRAVEL		SAND			SILT OR CLAY
	coarse	fine	coarse	medium	fine	


Specimen Identification	Classification	MC%	LL	PL	PI	Sp.Gr.
● 9902 4.5			NP	NP	NP	
	SILTY SAND SM					
	SAMPLE 4 - 4.5'-6.0'					

Specimen Identification	D100	D60	D30	D10	%Gravel	%Sand	%Fines	% < .002
● 9902 4.5	9.500	0.384	0.200		0.2	79.4	20.4	14.1

PROJECT ROCKPORT PLANT - ROCKPORT, INDIANA JOB NO. WO#SC3750
 DATE 06/01/99

GRADATION CURVES
 American Electric Power Service Corp.
 Groveport, Ohio



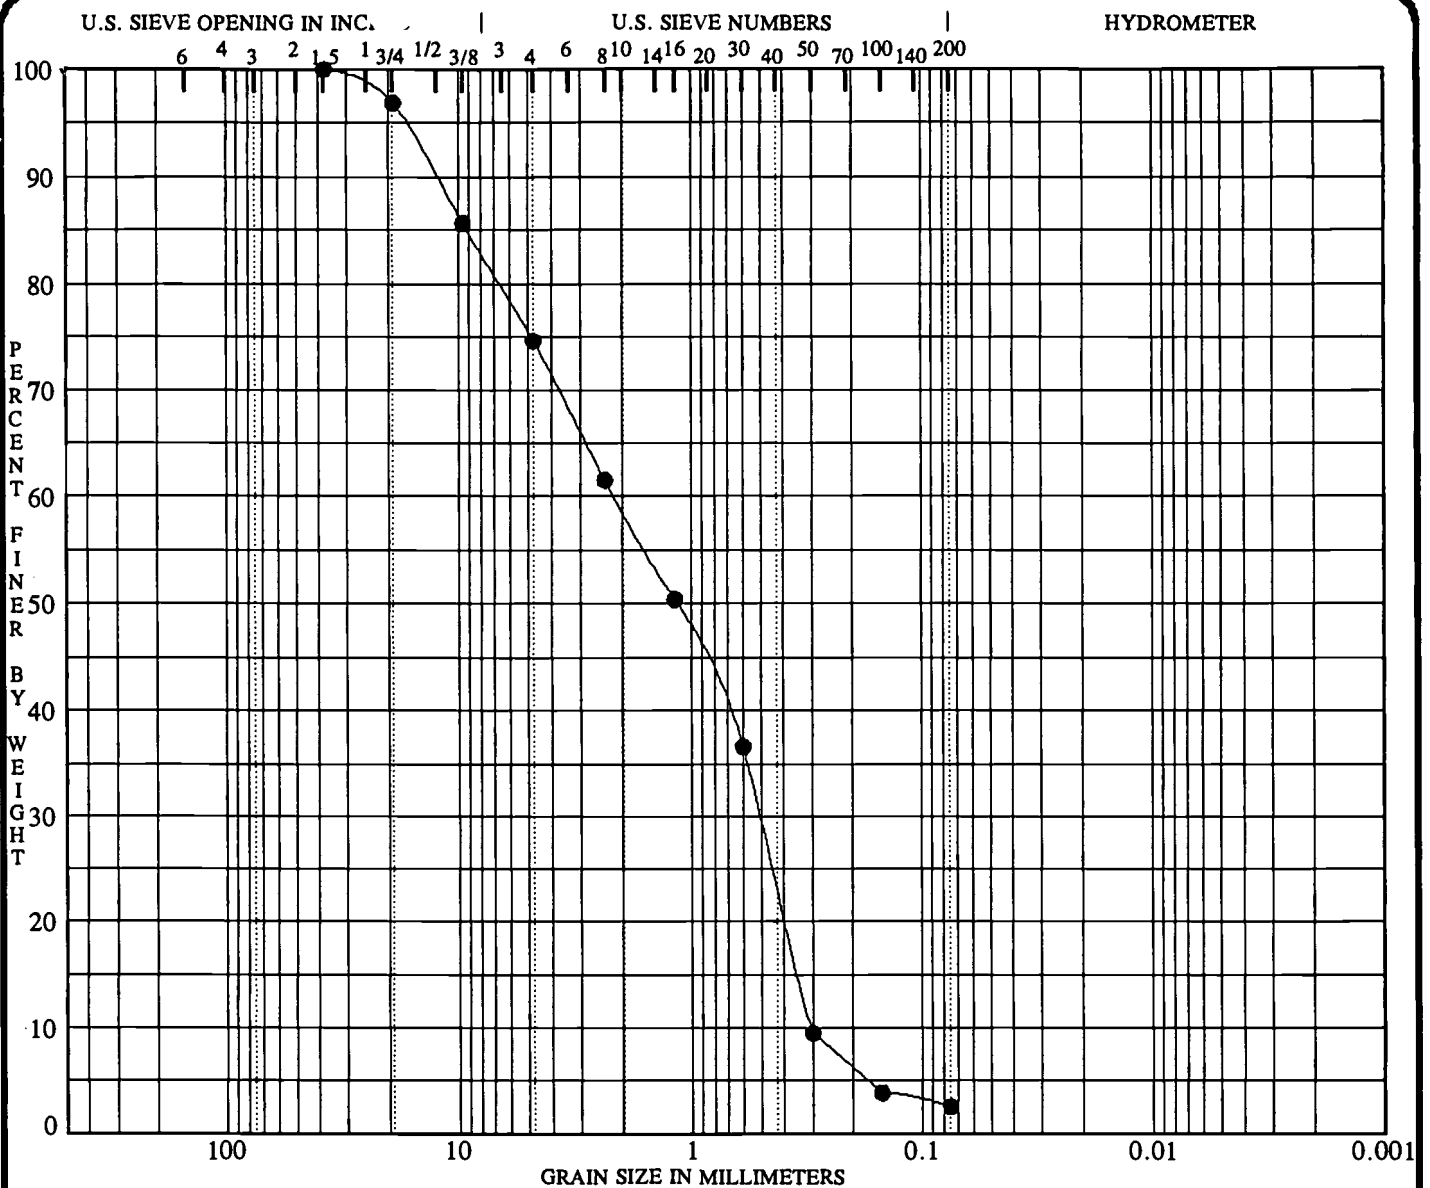

COBBLES	GRAVEL		SAND			SILT OR CLAY
	coarse	fine	coarse	medium	fine	


Specimen Identification	Classification	MC%	LL	PL	PI	Sp.Gr.
● 9902 30.0			NP	NP	NP	
	POORLY GRADED SAND with GRAVEL SP					
	WELL #2-S COMPOSITE SAMPLE 30.0'-40.5'					

Specimen Identification	D100	D60	D30	D10	%Gravel	%Sand	%Fines	% < .002
● 9902 30.0	37.500	2.149	0.507	0.304	25.4	72.0	2.6	

PROJECT ROCKPORT PLANT - ROCKPORT, INDIANA JOB NO. WO#1352
 DATE 04/22/99

GRADATION CURVES
 American Electric Power Service Corp.
 Groveport, Ohio



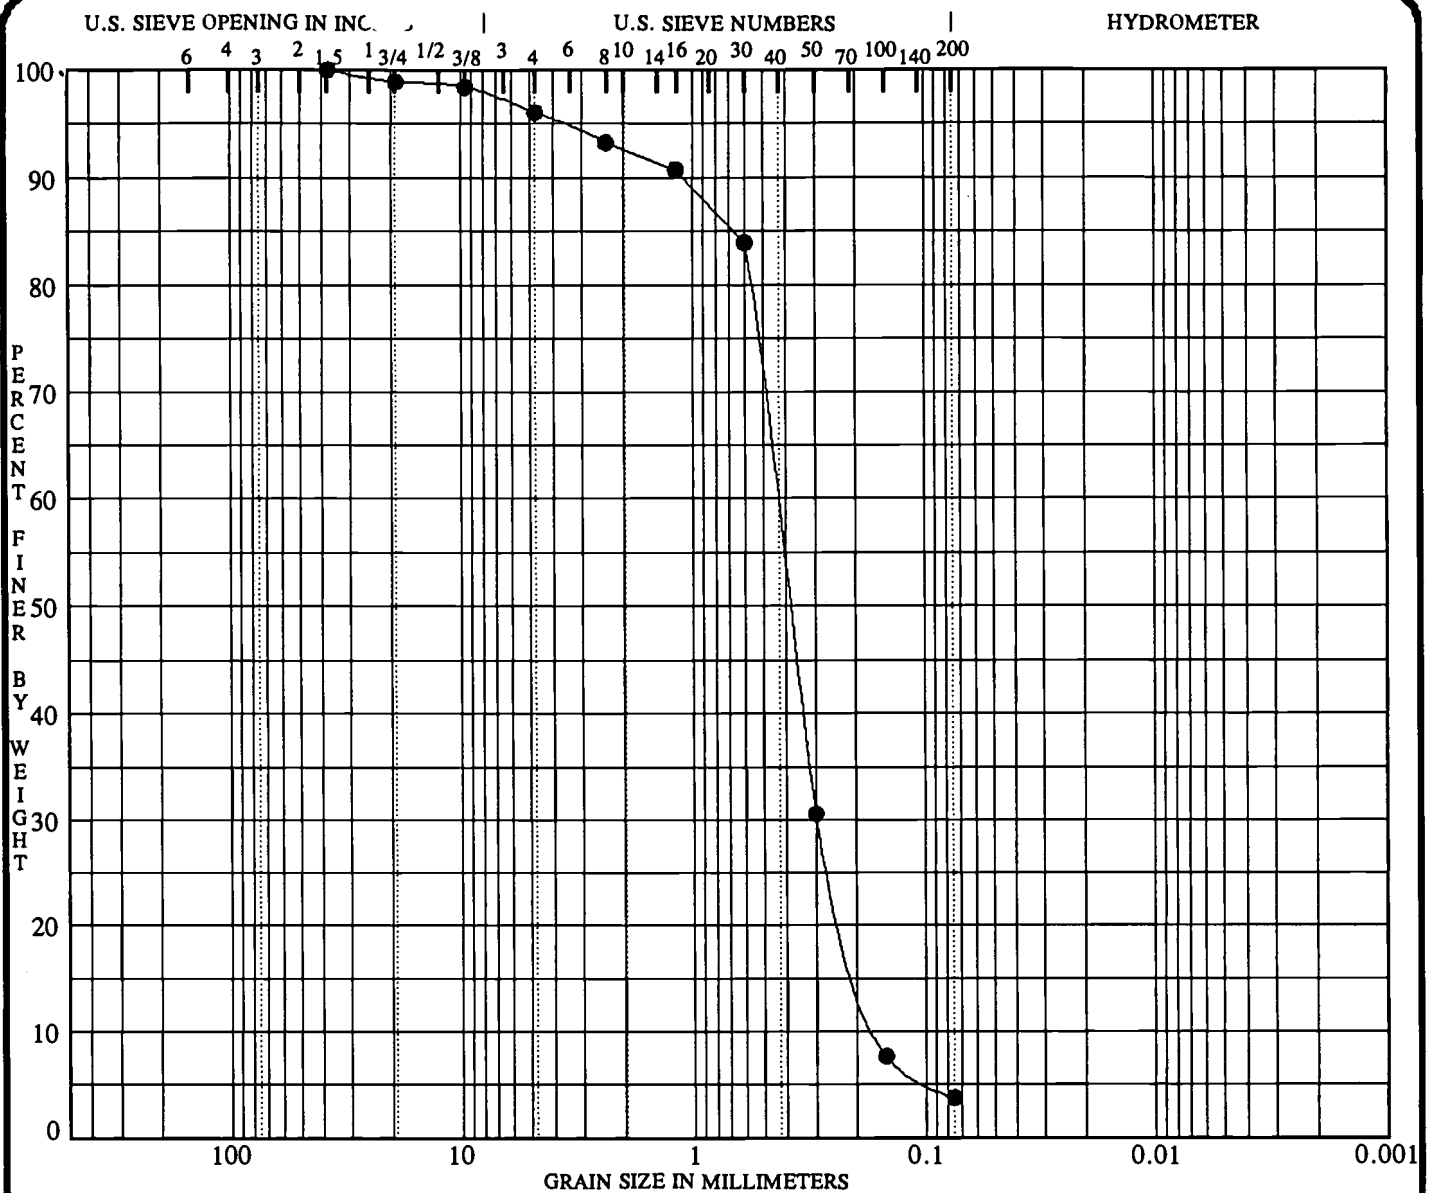

COBBLES	GRAVEL		SAND			SILT OR CLAY
	coarse	fine	coarse	medium	fine	


Specimen Identification	Classification	MC%	LL	PL	PI	Sp.Gr.
● 9902 53.0			NP	NP	NP	
POORLY GRADED SAND SP						
WELL #2-I COMPOSITE SAMPLE 53.0'-63.5'						

Specimen Identification	D100	D60	D30	D10	%Gravel	%Sand	%Fines	% < .002
● 9902 53.0	37.500	0.440	0.295	0.161	4.0	92.2	3.8	

PROJECT ROCKPORT PLANT - ROCKPORT, INDIANA JOB NO. WO#1352
 DATE 04/22/99

GRADATION CURVES
 American Electric Power Service Corp.
 Groveport, Ohio



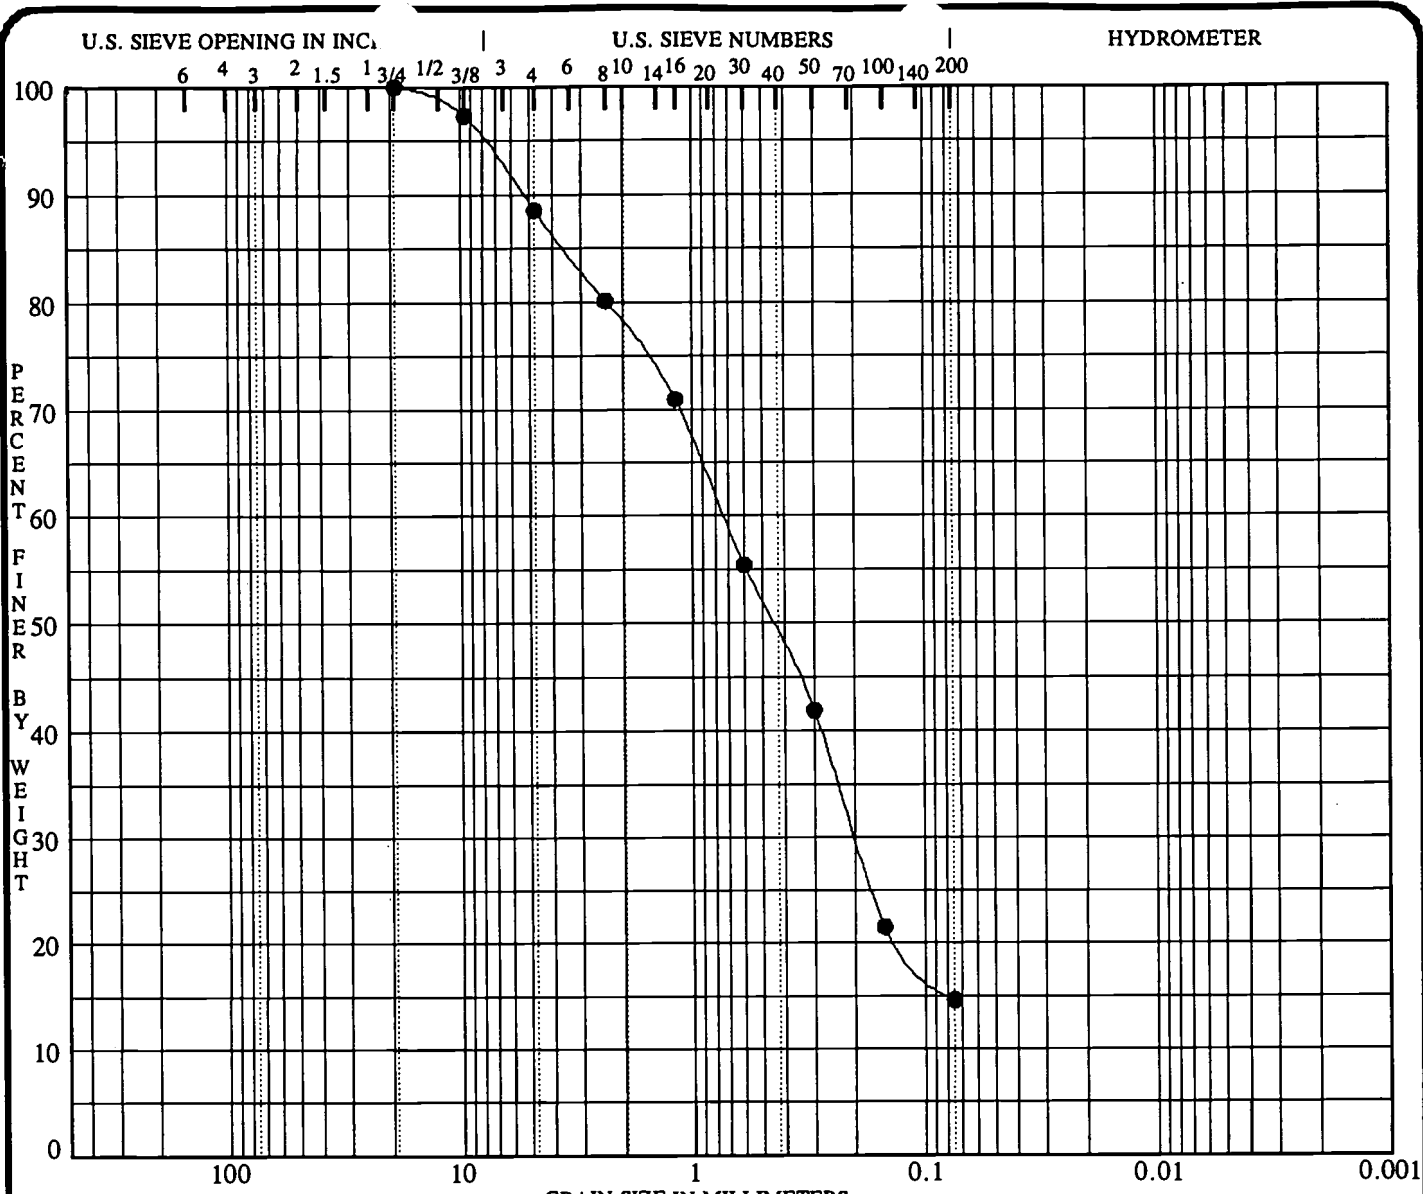

COBBLES	GRAVEL		SAND			SILT OR CLAY
	coarse	fine	coarse	medium	fine	

Specimen Identification	Classification	MC%	LL	PL	PI	Sp.Gr.
● 9902 76.9			NP	NP	NP	
SILTY SAND SM						
WELL #2-D COMPOSITE SAMPLE 76.9'-88.9'						

Specimen Identification	D100	D60	D30	D10	%Gravel	%Sand	%Fines	% < .002
● 9902 76.9	19.000	0.733	0.200		11.5	73.9	14.6	

PROJECT ROCKPORT PLANT - ROCKPORT, INDIANA JOB NO. WO#1352
 DATE 04/22/99


GRADATION CURVES
 American Electric Power Service Corp.
 Groveport, Ohio



I & M.
Rockport Plant
Ash Storage Area
Well No. 3-S
5-2-84

MW-3S
(Abandoned)


2" PVC Pipe

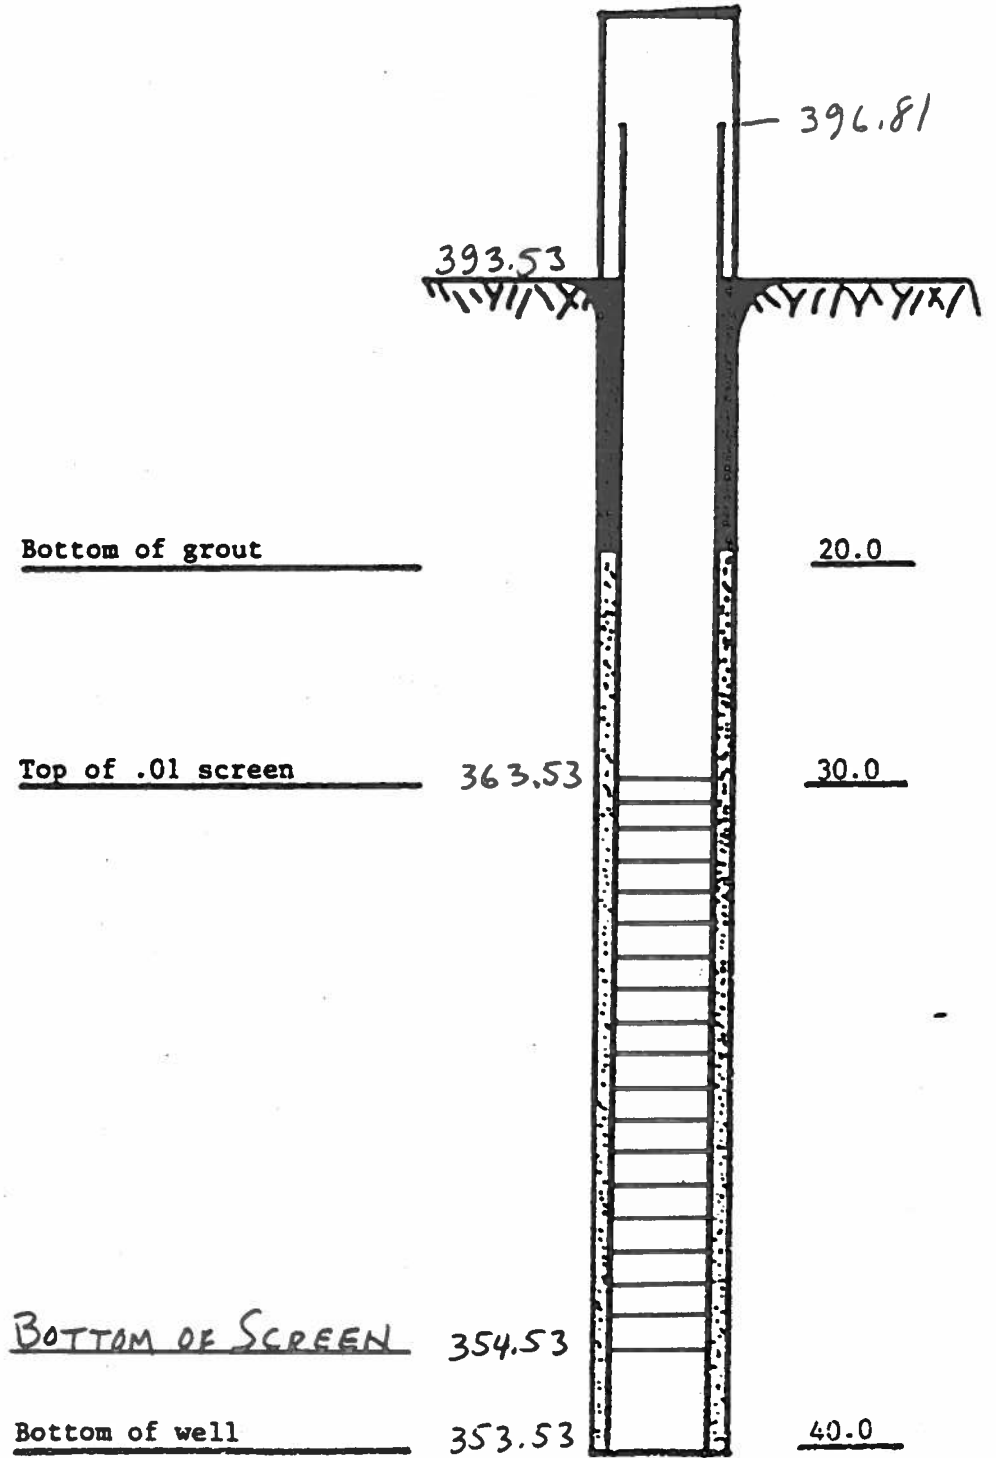

I & M
Rockport Plant
Ash Storage Area
Well No. 3-I
5-16-84

MW-3I
(Abandoned)

2" PVC Pipe

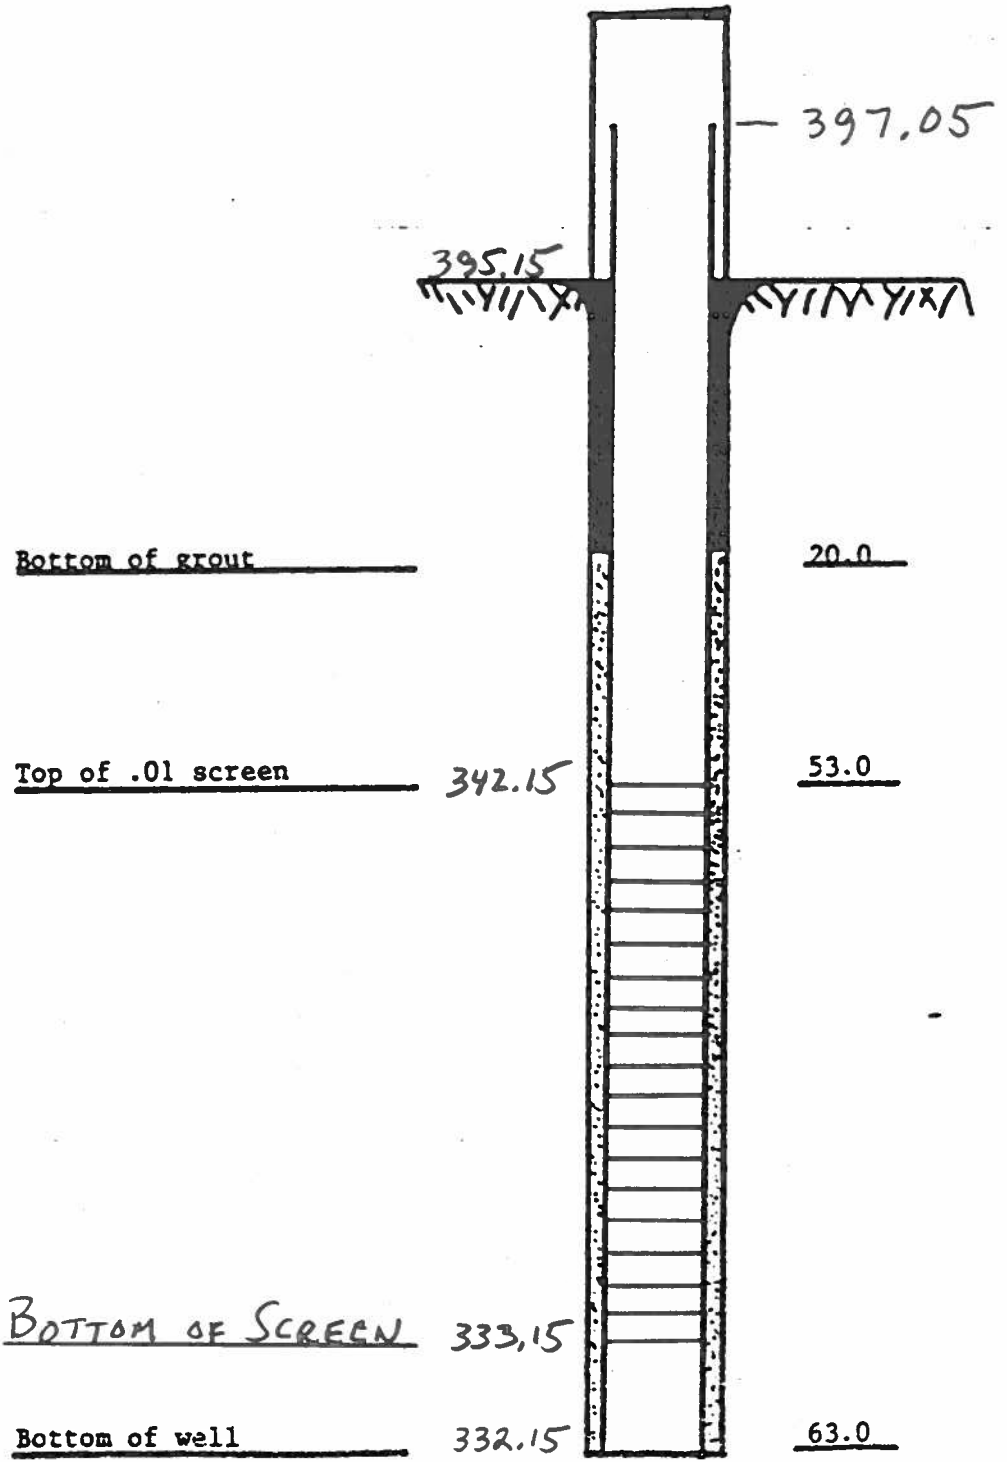

AME AN ELECTRIC POWER SERVICE CO. CORPORATION
AEP CIVIL ENGINEERING LABORATORY
 LOG OF BORING



JOB NUMBER _____
 COMPANY INDIANA MICHIGAN POWER COMPANY
 PROJECT ROCKPORT PLANT
 COORDINATES N 162,287.4 E 520,118.1
 GROUND ELEVATION 394.7 SYSTEM _____

MW-3
 BORING NO. 9903 DATE 4/27/99 SHEET 1 OF 3
 BORING START 1/15/99 BORING FINISH 1/16/99
 PIEZOMETER TYPE _____ WELL TYPE OW
 HGT. RISER ABOVE GROUND _____ DIA _____
 DEPTH TO TOP OF WELL SCREEN _____ BOTTOM _____
 WELL DEVELOPMENT _____ BACKFILL Grout
 FIELD PARTY MCR-DLB RIG BK-81

WATER LEVEL	▽	▽	▽
TIME			
DATE			

SAMPLE NUMBER	SAMPLE	SAMPLE DEPTH IN FEET		STANDARD PENETRATION RESISTANCE BLOWS / 6"	TOTAL LENGTH RECOVERY	RQD %	DEPTH IN FEET	GRAPHIC LOG	USCS	SOIL / ROCK IDENTIFICATION	WELL	DRILLER'S NOTES
		FROM	TO									
1	SS	0.0	1.5	1-1-2	1.3				CL	BROWNISH GRAY CLAY		Water for drilling and grouting from fire protection well at Rockport Plant.
2	SS	1.5	3.0	2-2-3	1.5				CL	With organic, moist. BROWNISH GRAY CLAY		
3	SS	3.0	4.5	3-5-8	1.5				CL	Moist REDDISH BROWN CLAY		
4	SS	4.5	6.0	6-8-10	1.6		5		CL	Stiff, dry. REDDISH BROWN SANDY CLAY		Grouted from 105.2' to grade; used approx. 100 gallons (4 bags).
5	SS	6.0	7.5	4-3-4	1.5				CL	Dry REDDISH BROWN SILTY CLAY		
6	SS	7.5	9.0	1-3-4	1.5				CL	Dry REDDISH BROWN SILTY CLAY		
7	SS	9.0	10.5	3-5-8	1.5		10		CL	Dry REDDISH BROWN SILTY CLAY		
8	SS	10.5	12.0	3-5-8	1.5				CL	With vertical strip of gray clay, dry. REDDISH BROWN SILTY CLAY		
9	SS	12.0	13.5	3-4-5	1.5				GL	Dry REDDISH BROWN SANDY CLAY		
10	SS	13.5	15.0	2-3-5	1.5				CL	Dry REDDISH BROWN SANDY CLAY		
11	SS	15.0	16.5	5-10-10	1.5		15		SP	Dry REDDISH BROWN SILTY CLAY		Used approx. 200 gallons drill mud (2 bags) while drilling hole.
12	SS	16.5	18.0	6-9-10	1.5					Dry BROWN MEDIUM GRAIN SAND		
13	SS	18.0	19.5	7-10-12	1.5					Dry		
14	SS	19.5	21.0	7-8-9	1.5		20					
15	SS	21.0	22.5	8-10-13	1.5							
16	SS	22.5	24.0	8-10-12	1.5							
17	SS	24.0	25.5	10-10-11	1.5		25		SP	BROWN MEDIUM GRAIN SAND With few pea size gravel, dry		
18	SS	27.0	28.5	5-5-5	1.5		30					Water on A-rods at 27.5'.
19	SS	30.0	31.5	4-4-4	1.5							
20	SS	31.5	33.0	2-3-4	1.5				SP	MEDIUM GRAIN SAND With pea to 1/2" gravel, wet		
21	SS	33.0	34.5	2-3-4	1.5							Started using drill mud to prevent heaving sands at 34.5'.
22	SS	34.5	36.0	8-13-20	1.5		35					
23	SS	36.0	37.5	5-8-9	1.5							
24	SS	37.5	39.0	6-9-15	1.5							

AEP R0PT.GPJ AEP FULL.GDT 4/27/99

TYPE OF CASING USED

	NQ-2 ROCK CORE
X	6" x 3.25 HSA
	9" x 6.25 HSA
	HW CASING ADVANCER 4"
	NW CASING 3"
	SW CASING 6"
	AIR HAMMER 8"

Continued Next Page

PIEZOMETER TYPE: PT = OPEN TUBE POROUS TIP, SS = OPEN TUBE SLOTTED SCREEN, G = GEONOR, P = PNEUMATIC
 WELL TYPE: OW = OPEN TUBE SLOTTED SCREEN, GM = GEOMON

RECORDER DLB

AME AN ELECTRIC POWER SERVICE COF RATION
AEP CIVIL ENGINEERING LABORATORY
 LOG OF BORING



JOB NUMBER _____

COMPANY **INDIANA MICHIGAN POWER COMPANY**

BORING NO. **9903** DATE **4/27/99** SHEET **2** OF **3**

PROJECT **ROCKPORT PLANT**

BORING START **1/15/99** BORING FINISH **1/16/99**

SAMPLE NUMBER	SAMPLE	SAMPLE DEPTH IN FEET		STANDARD PENETRATION RESISTANCE BLOWS / 6"	TOTAL LENGTH RECOVERY	RQD %	DEPTH IN FEET	GRAPHIC LOG	USCS	SOIL / ROCK IDENTIFICATION	WELL	DRILLER'S NOTES
		FROM	TO									
25	SS	39.0	40.5	5-6-6	1.5							
26	SS	42.0	43.5	10-11-9	1.5		45		SP	MEDIUM GRAIN SAND With pea to 1/2" gravel and small bits of wood, wet		
27	SS	47.0	48.5	3-6-7	1.5		50		SP	MEDIUM GRAIN SAND With pea size gravel, wet		
28	SS	52.0	53.5	6-8-9	1.5		55		SP	BROWN MEDIUM GRAIN SAND With pea to 1/2" gravel, wet		
29	SS	57.0	58.5	5-6-7	1.5		60					
30	SS	62.0	63.5	8-9-8	1.5		65					
31	SS	67.0	68.5	7-7-12	1.5		70					
32	SS	72.0	73.5	10-10-12	1.5		75					
33	SS	77.0	78.5	3-4-7	1.5		80					
34	SS	82.0	83.5	5-6-6	1.5		85					
35	SS	87.0	88.5	4-5-8	1.5		90		SP	BROWN MEDIUM GRAIN SAND With pea size gravel, wet		

AEP RKPT.GPJ AEP_FULL.GDT 4/27/99


Continued Next Page

AME AN ELECTRIC POWER SERVICE CORPORATION
AEP CIVIL ENGINEERING LABORATORY
 LOG OF BORING



JOB NUMBER _____
 COMPANY INDIANA MICHIGAN POWER COMPANY BORING NO. 9903 DATE 4/27/99 SHEET 3 OF 3
 PROJECT ROCKPORT PLANT BORING START 1/15/99 BORING FINISH 1/16/99

SAMPLE NUMBER	SAMPLE	SAMPLE DEPTH IN FEET		STANDARD PENETRATION RESISTANCE BLOWS / 6"	TOTAL LENGTH RECOVERY	RQD	DEPTH IN FEET	GRAPHIC LOG	USCS	SOIL / ROCK IDENTIFICATION	WELL	DRILLER'S NOTES
		FROM	TO			%						
36	SS	92.0	93.5	4-6-6	1.5		95		SP GP	BROWN FINE SAND Wet PEA SIZE GRAVEL Wet		
37	SS	97.0	98.5	5-7-6	1.5		100		SP	MEDIUM GRAIN SAND With pea size gravel, wet.		
38	SS	102.0	103.5	8-10-11	1.5		105		SP	MEDIUM GRAIN SAND With pea to 3/4" gravel, wet		
39	SS	105.0	105.2	50/2	.2					GRAY FINE GRAIN SANDY CLAY SHALE		Auger refusal at 105.0' Spoon refusal at 105.2' Stopped boring at 105.2'

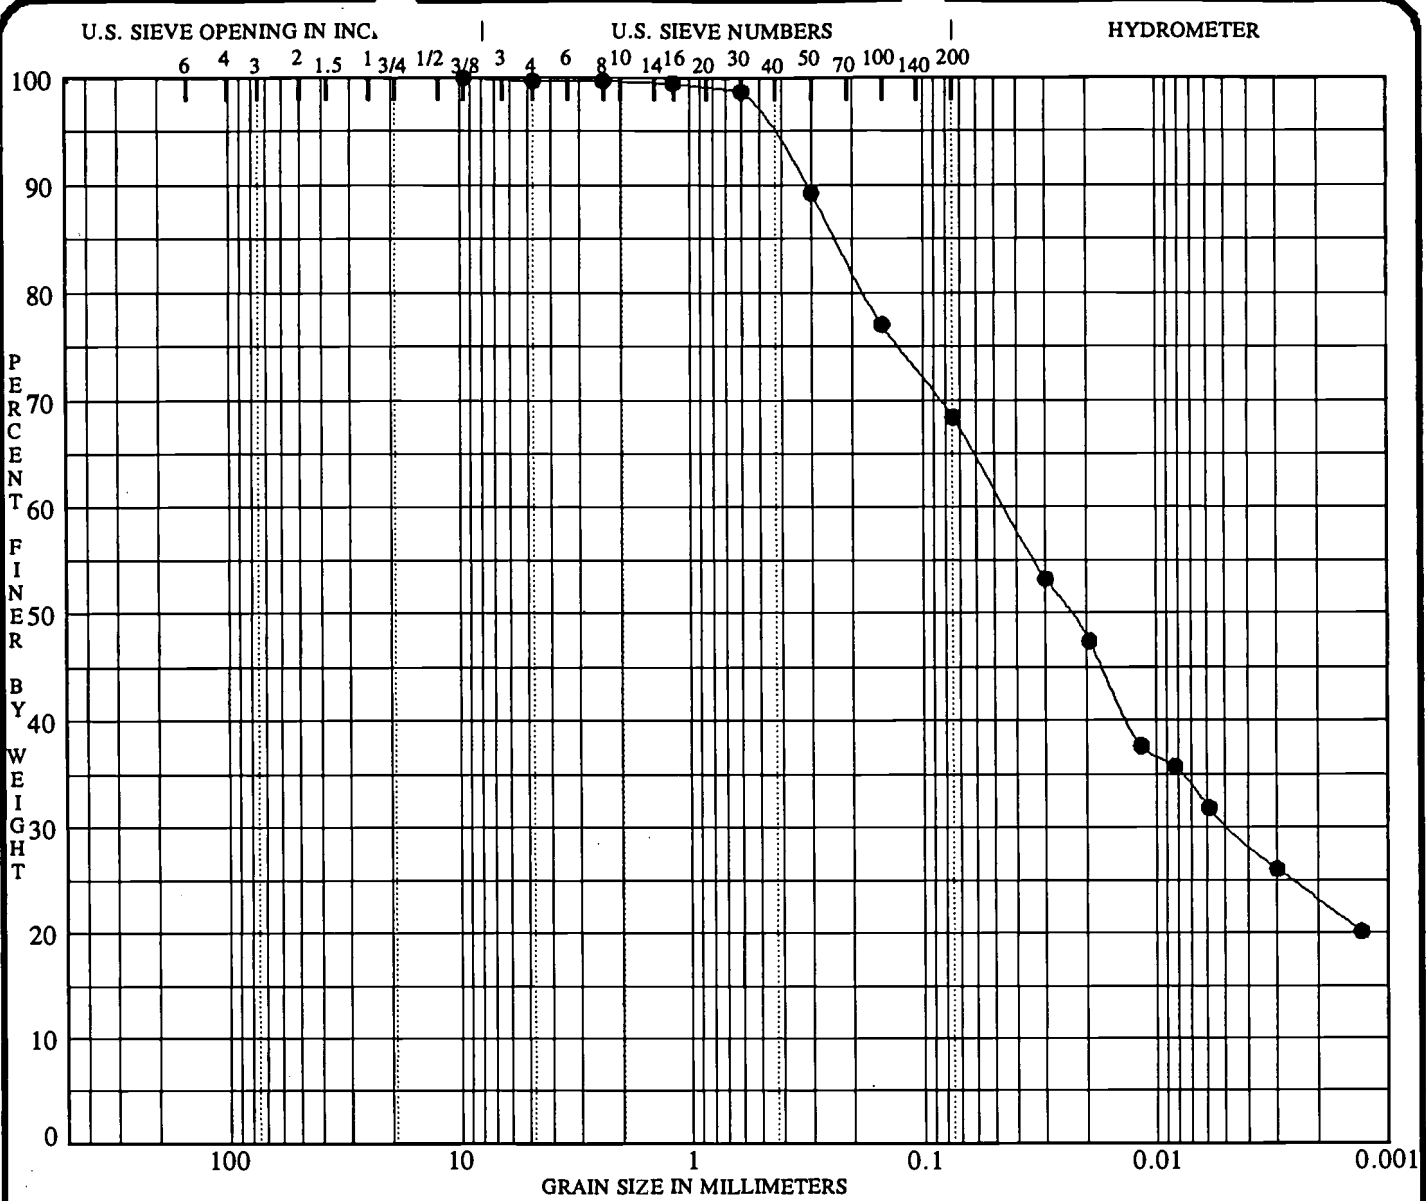

COBBLES	GRAVEL		SAND			SILT OR CLAY
	coarse	fine	coarse	medium	fine	


Specimen Identification	Classification	MC%	LL	PL	PI	Sp.Gr.
● 9903 1.5			27.7	15.6	12.1	
	SANDY LEAN CLAY CL					
	COMPOSITE 1.5'-15.0'					

Specimen Identification	D100	D60	D30	D10	%Gravel	%Sand	%Fines	% < .002
● 9903 1.5	9.500	0.045	0.005		0.3	31.3	68.4	23.1

PROJECT ROCKPORT PLANT - ROCKPORT, INDIANA JOB NO. WO#SC3750
 DATE 06/01/99

GRADATION CURVES
 American Electric Power Service Corp.
 Groveport, Ohio



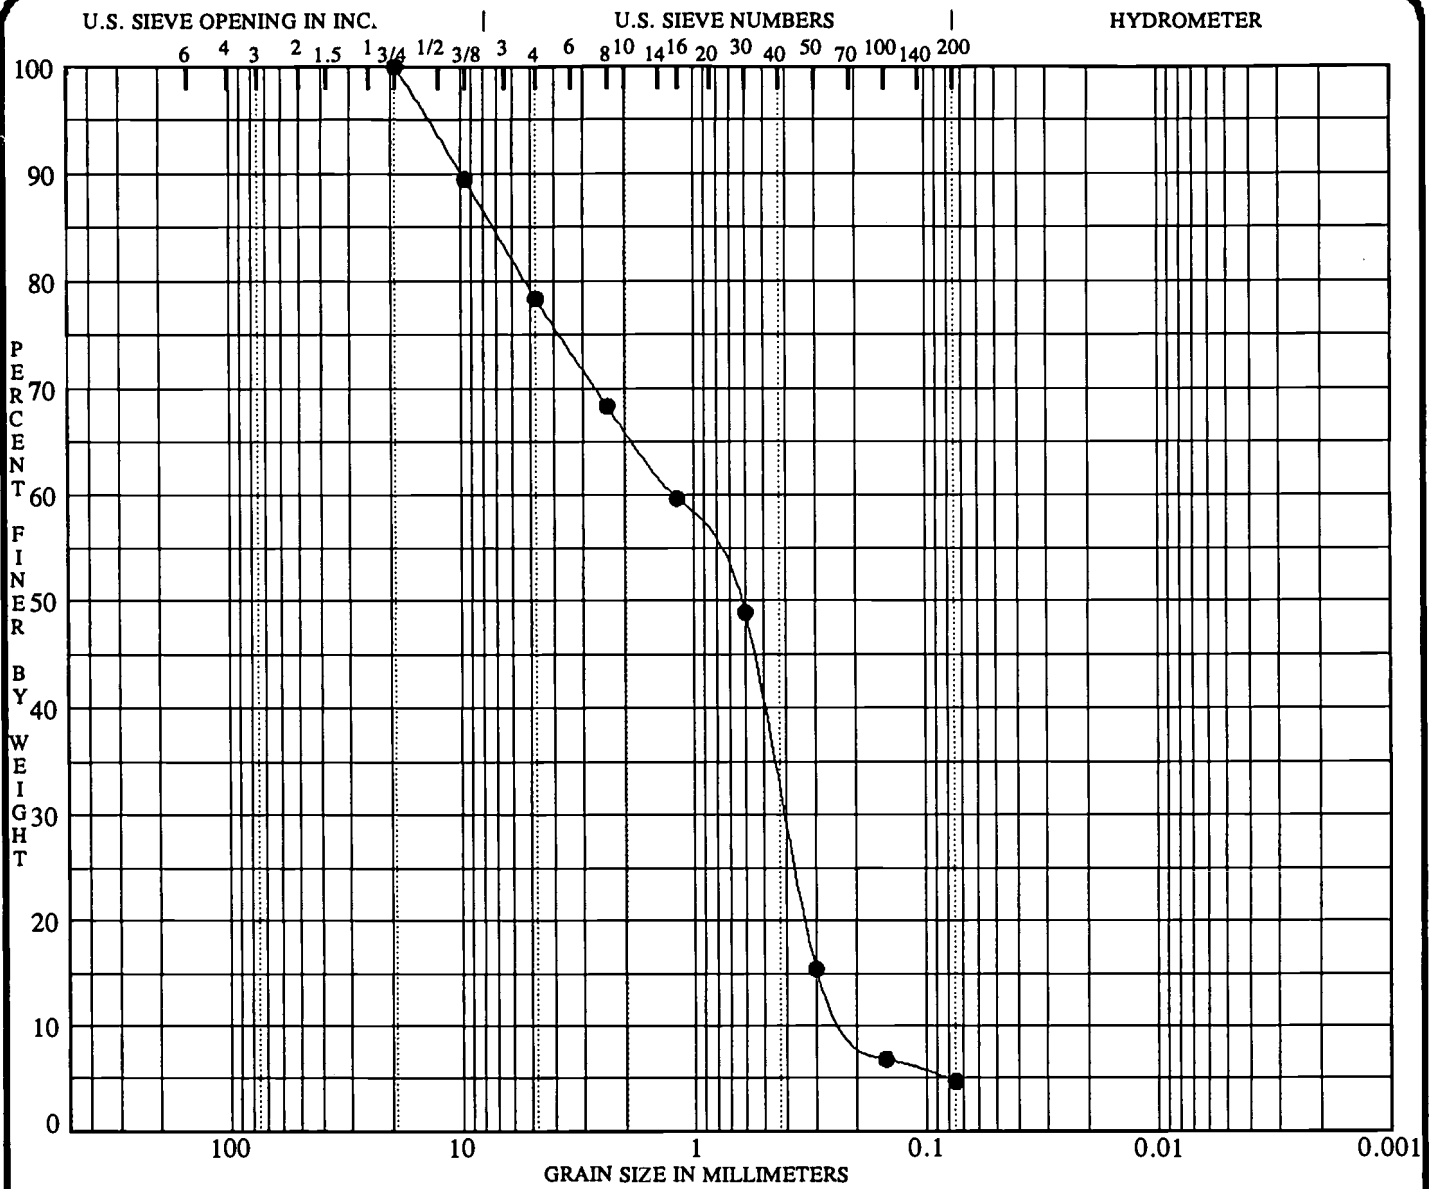

COBBLES	GRAVEL		SAND			SILT OR CLAY
	coarse	fine	coarse	medium	fine	


Specimen Identification	Classification	MC%	LL	PL	PI	Sp.Gr.
● 9903 30.0			NP	NP	NP	
POORLY GRADED SAND with SILT and GRAVEL SP-SM						
WELL #3-S COMPOSITE SAMPLE 30.0'-40.5'						

Specimen Identification	D100	D60	D30	D10	%Gravel	%Sand	%Fines	% < .002
● 9903 30.0	19.000	1.209	0.406	0.194	21.7	73.6	4.7	

PROJECT ROCKPORT PLANT - ROCKPORT, INDIANA JOB NO. WO#1352
 DATE 04/22/99

GRADATION CURVES
 American Electric Power Service Corp.
 Groveport, Ohio



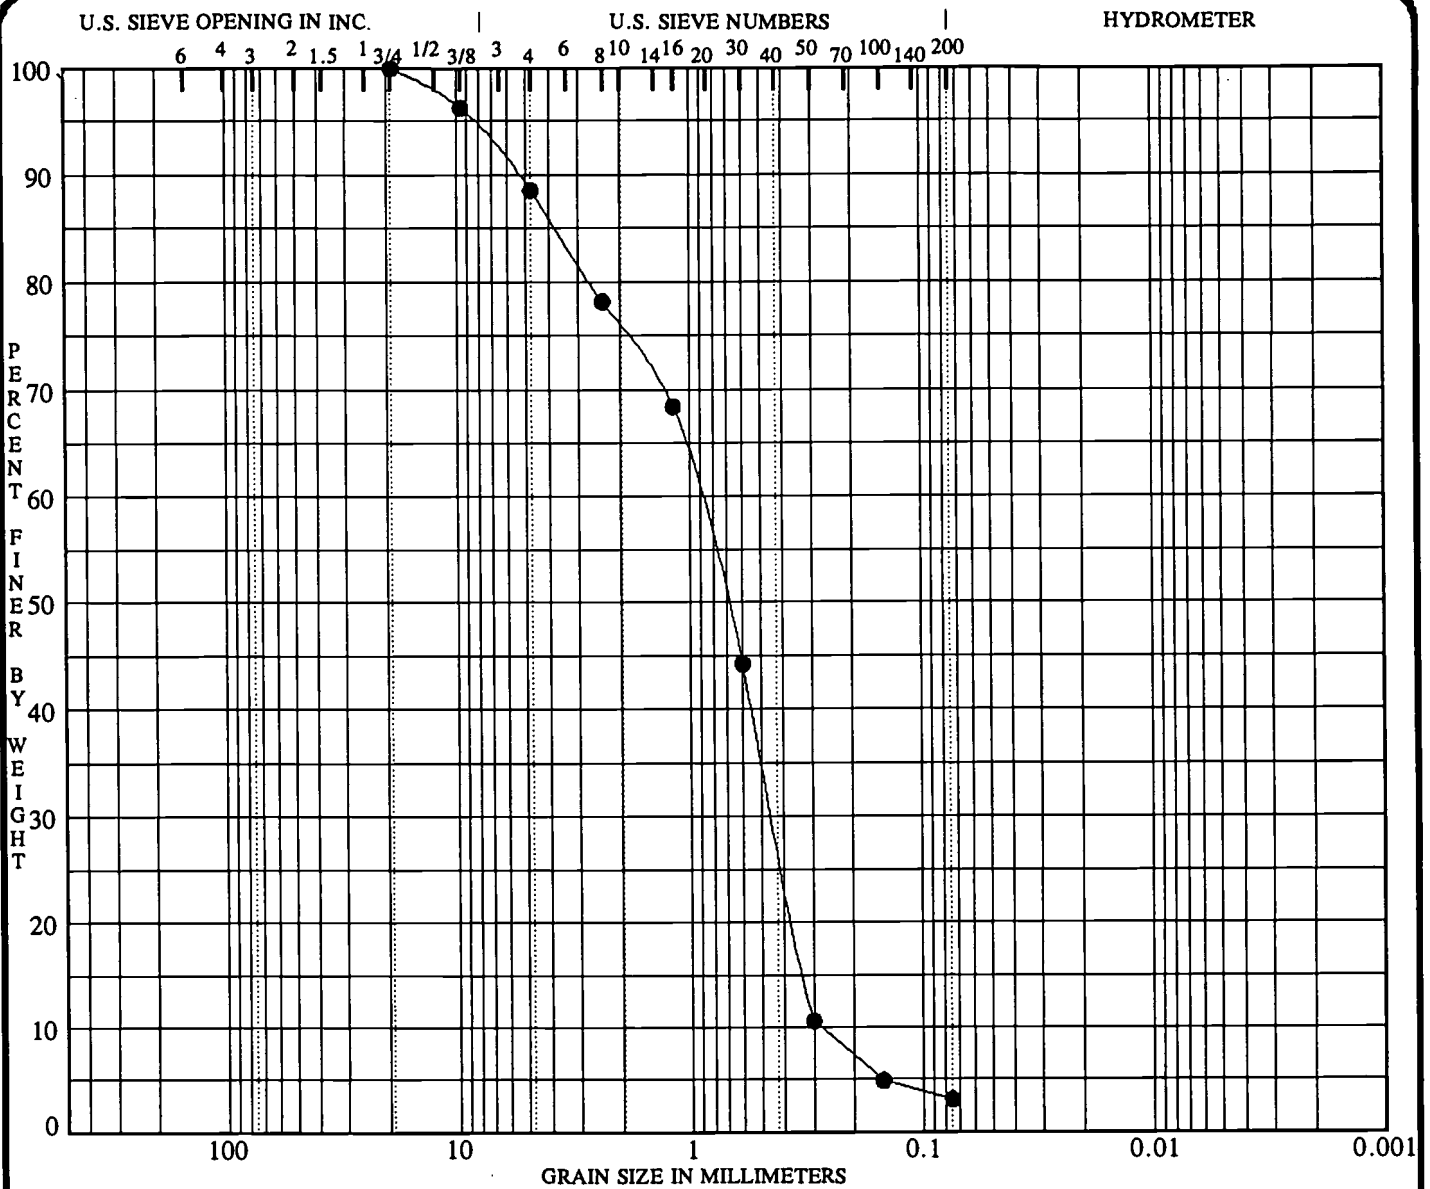

COBBLES	GRAVEL		SAND			SILT OR CLAY
	coarse	fine	coarse	medium	fine	

Specimen Identification	Classification	MC%	LL	PL	PI	Sp.Gr.
● 9903 52.0			NP	NP	NP	
	POORLY GRADED SAND SP					
	WELL #3-I COMPOSITE SAMPLE 52.0'-63.5'					

Specimen Identification	D100	D60	D30	D10	%Gravel	%Sand	%Fines	% < .002
● 9903 52.0	19.000	0.933	0.448	0.279	11.5	85.4	3.1	

PROJECT ROCKPORT PLANT - ROCKPORT, INDIANA JOB NO. WO#1352
 DATE 04/22/99


GRADATION CURVES
 American Electric Power Service Corp.
 Groveport, Ohio



I & M
Rockport Plant
Ash Storage Area
Well No. 4-S
5-9-84

MW-4S
(Abandoned)


2" PVC Pipe

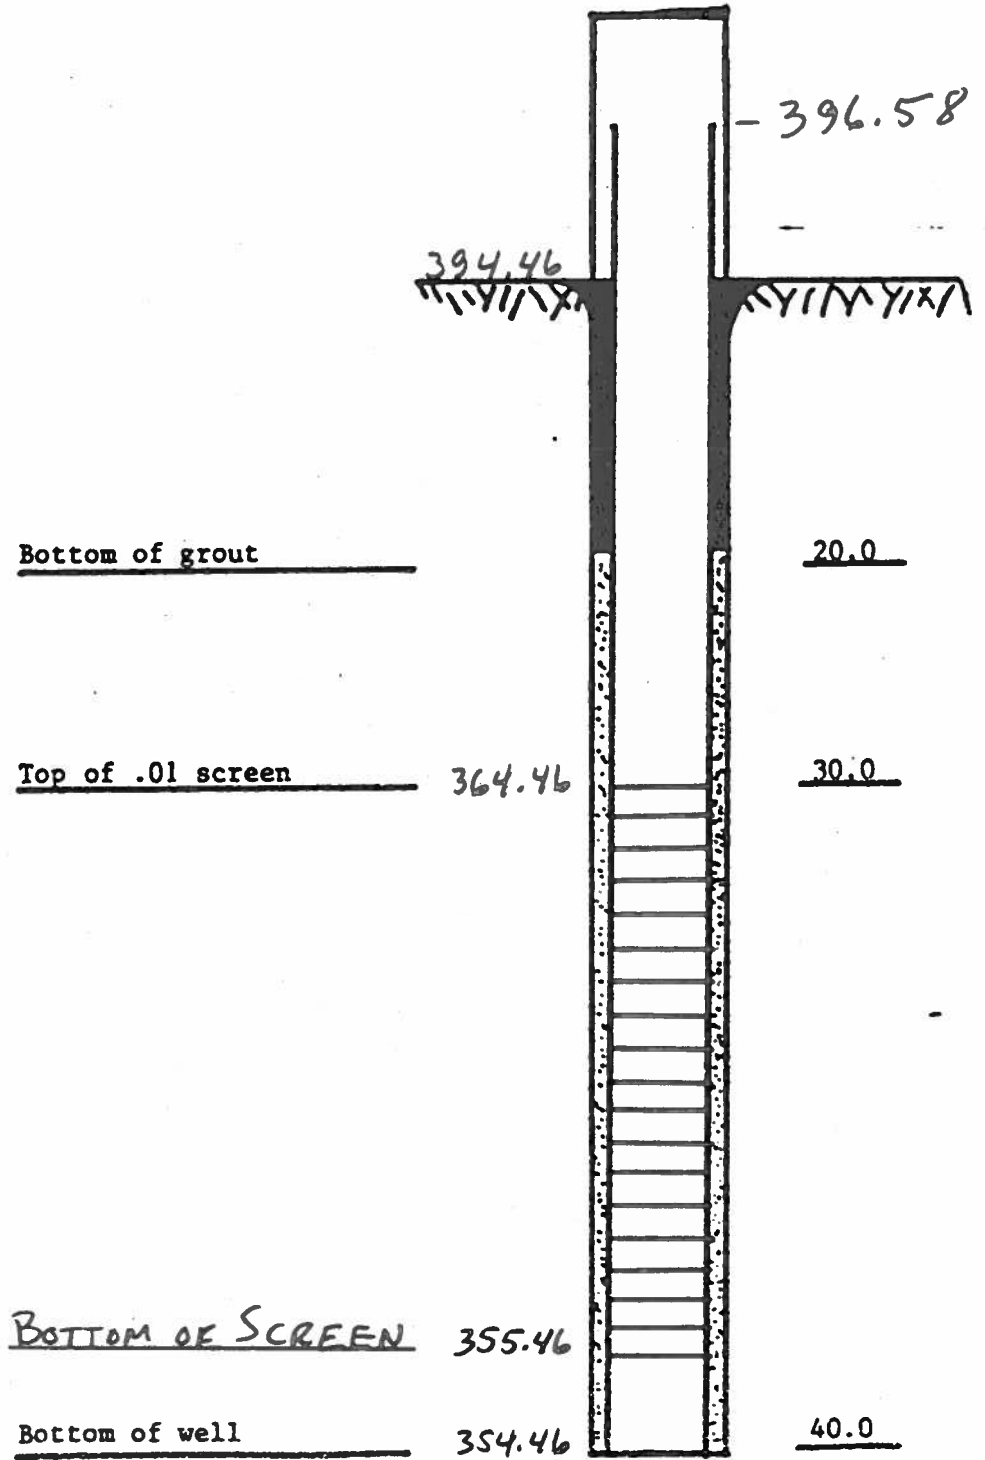

I & M
Rockport Plant
Ash Storage Area
Well No. 4I
5-09-84

MW-4I
(Abandoned)

~ 2" PVC Pipe

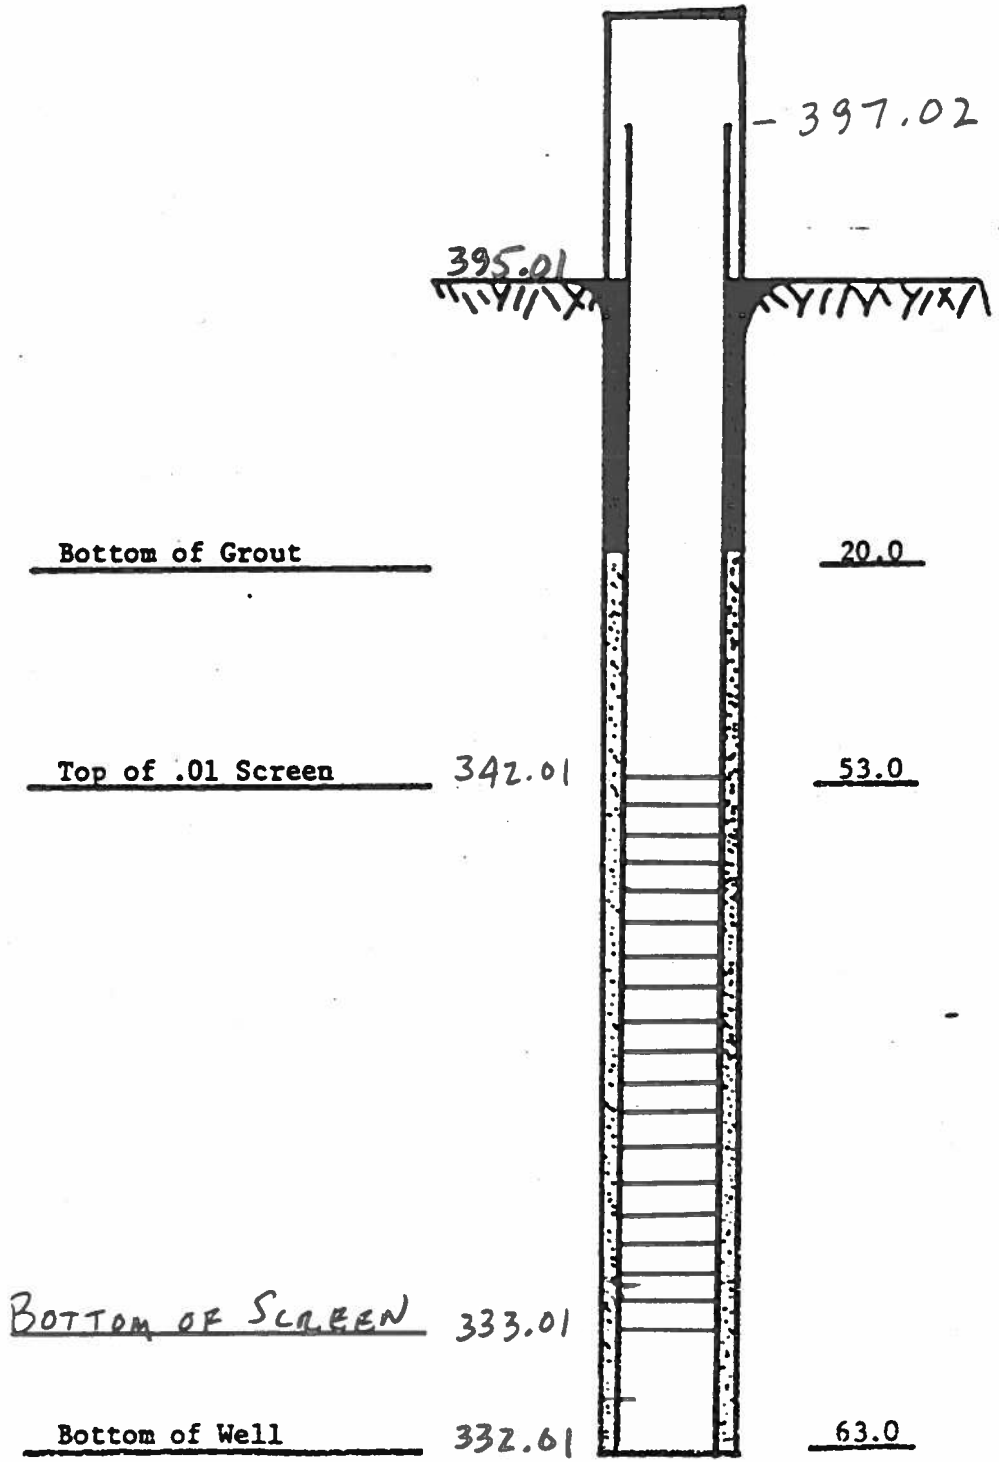

AMERICAN ELECTRIC POWER SERVICE CORPORATION
AEP CIVIL ENGINEERING LABORATORY
 LOG OF BORING



JOB NUMBER _____
 COMPANY INDIANA MICHIGAN POWER COMPANY
 PROJECT ROCKPORT PLANT
 COORDINATES N 163,459.8 E 519,814.2
 GROUND ELEVATION 394.6 SYSTEM _____

MW-4

BORING NO. 9904 DATE 4/27/99 SHEET 1 OF 2
 BORING START 1/31/99 BORING FINISH 2/1/99
 PIEZOMETER TYPE _____ WELL TYPE OW
 HGT. RISER ABOVE GROUND _____ DIA _____
 DEPTH TO TOP OF WELL SCREEN _____ BOTTOM _____
 WELL DEVELOPMENT _____ BACKFILL Grout
 FIELD PARTY MCR-DLB RIG BK-81

WATER LEVEL	▽	▽	▽
TIME			
DATE			

SAMPLE NUMBER	SAMPLE	SAMPLE DEPTH IN FEET		STANDARD PENETRATION RESISTANCE BLOWS / 6"	TOTAL LENGTH RECOVERY	RQD %	DEPTH IN FEET	GRAPHIC LOG	USCS	SOIL / ROCK IDENTIFICATION	WELL	DRILLER'S NOTES
		FROM	TO									
1	SS	0.0	2.0	1-1-2-3	2.0				CL	BROWN CLAY With organic in top 0.5, moist		Water for drilling & grouting came from fire protection wells at Rockport Plant Used approximately 300 gallons of quick grout to drill and grout with 5 bags.
2	SS	2.0	4.0	2-3-3-4	2.0				CL	BROWN SILTY CLAY		
3	SS	4.0	6.0	2-3-3-4	2.0							
4	SS	6.0	8.0	3-2-3-5	2.0		5		SW	BROWN SAND Well graded, medium grain, Wet		
5	SS	8.0	10.0	2-3-4-4	2.0				CL	BROWN SILTY CLAY Wet at 6.0; Moist at 8.0		
6	SS	10.0	12.0	3-4-6-8	2.0		10		SP	BROWN SAND Poorly graded, dry		
7	SS	12.0	14.0	3-4-6-8	2.0				SP	SAND Medium grain, Dry		
8	SS	14.0	16.0	2-2-3-3	2.0		15					
9	SS	16.0	18.0	3-6-8-10	2.0				SP	SAND Medium grain, with pea gravel, dry at 16.0; wet at 24.0		
10	SS	18.0	20.0	2-5-7-8	2.0		20					
11	SS	20.0	22.0	5-8-10-13	2.0							
12	SS	22.0	24.0	3-7-10-13	2.0							
13	SS	24.0	26.0	7-9-11-12	2.0		25					
14	SS	30.0	32.0	2-2-3-3	2.0		30		SP	SAND Medium grain, with pea to 1/2" gravel, wet		
15	SS	32.0	34.0	2-2-3-4	2.0							
16	SS	34.0	36.0	9-11-12-14	1.5		35		SP	SAND Medium grain, wet		
17	SS	36.0	38.0	2-2-2-4	2.0				SP	SAND Medium grain, with pea to 1/2" gravel, wet		
18	SS	38.0	40.0	1-1-2-5	2.0						Instead of using muc to prevent heaving sands, started inducing quick grout at 34'.	

RPT.GPJ AEP FULL GDT 4/27/99

TYPE OF CASING USED				Continued Next Page			
	X	NO-2 ROCK CORE		PIEZOMETER TYPE: PT = OPEN TUBE POROUS TIP, SS = OPEN TUBE SLOTTED SCREEN, G = GEONOR, P = PNEUMATIC			
		6" x 3.25 HSA		WELL TYPE: OW = OPEN TUBE SLOTTED SCREEN, GM = GEOMON			
		9" x 6.25 HSA		RECORDER DLB			
		HW CASING ADVANCER	4"				
		NW CASING	3"				
		SW CASING	6"				

AMERICAN ELECTRIC POWER SERVICE CORPORATION
AEP CIVIL ENGINEERING LABORATORY
 LOG OF BORING



JOB NUMBER _____

COMPANY **INDIANA MICHIGAN POWER COMPANY**


BORING NO. **9904** DATE **4/27/99** SHEET **2** OF **2**

PROJECT **ROCKPORT PLANT**

BORING START **1/31/99** BORING FINISH **2/1/99**

SAMPLE NUMBER	SAMPLE	SAMPLE DEPTH IN FEET		STANDARD PENETRATION RESISTANCE BLOWS / 6"	TOTAL LENGTH RECOVERY	RQD	DEPTH IN FEET	GRAPHIC LOG	USCS	SOIL / ROCK IDENTIFICATION	WELL	DRILLER'S NOTES
		FROM	TO			%						
19	SS	41.6	43.1	3-5-8	1.5		45		SW	SAND Well grain, medium grain, wet		
20	SS	46.6	48.1	3-6-11	1.5		50		SP	SAND Medium grain, with pea gravel, wet		
21	SS	51.6	53.1	4-7-8	1.5		55		SW	SAND Well graded, medium grain, wet		
22	SS	53.1	55.1	4-5-7-9	2.0							
23	SS	55.1	57.1	4-8-9-11	2.0							
24	SS	57.1	59.1	2-3-8-10	2.0							
25	SS	59.1	61.1	8-11-11-18	2.0		60		SP	SAND Medium grain, with pea to 1/2" gravel, wet		
26	SS	61.1	63.1	9-11-12-16	2.0		65		SP	SAND Medium grain, with pea gravel, few coal particles, wet		
27	SS	66.6	68.1	7-9-12	1.5		70		SP	SAND Medium grain, with pea to 3/4" gravel, wet		
28	SS	71.6	73.1	6-8-6	1.5		75		SP	SAND Medium grain, with pea to 1/2" gravel, wet		
29	SS	76.6	78.1	10-12-14	1.5		80		SP	SAND Medium grain, with pea to 3/4" gravel, wet		
30	SS	81.6	83.1	5-5-8	1.5				CL	GRAY SILTY CLAY Moist		
31	SS	84.1	84.8	16-50/2	0.8				CL	BLUISH GRAY SANDY CLAY		
									CL	BLUISH GRAY SILTY CLAY		
										SHALE		Auger refusal 84.1' Spoon refusal 84.8'. Stopped boring at 84.8

P: RKPT.GPJ_AEP_FULL.GDT_4/27/99

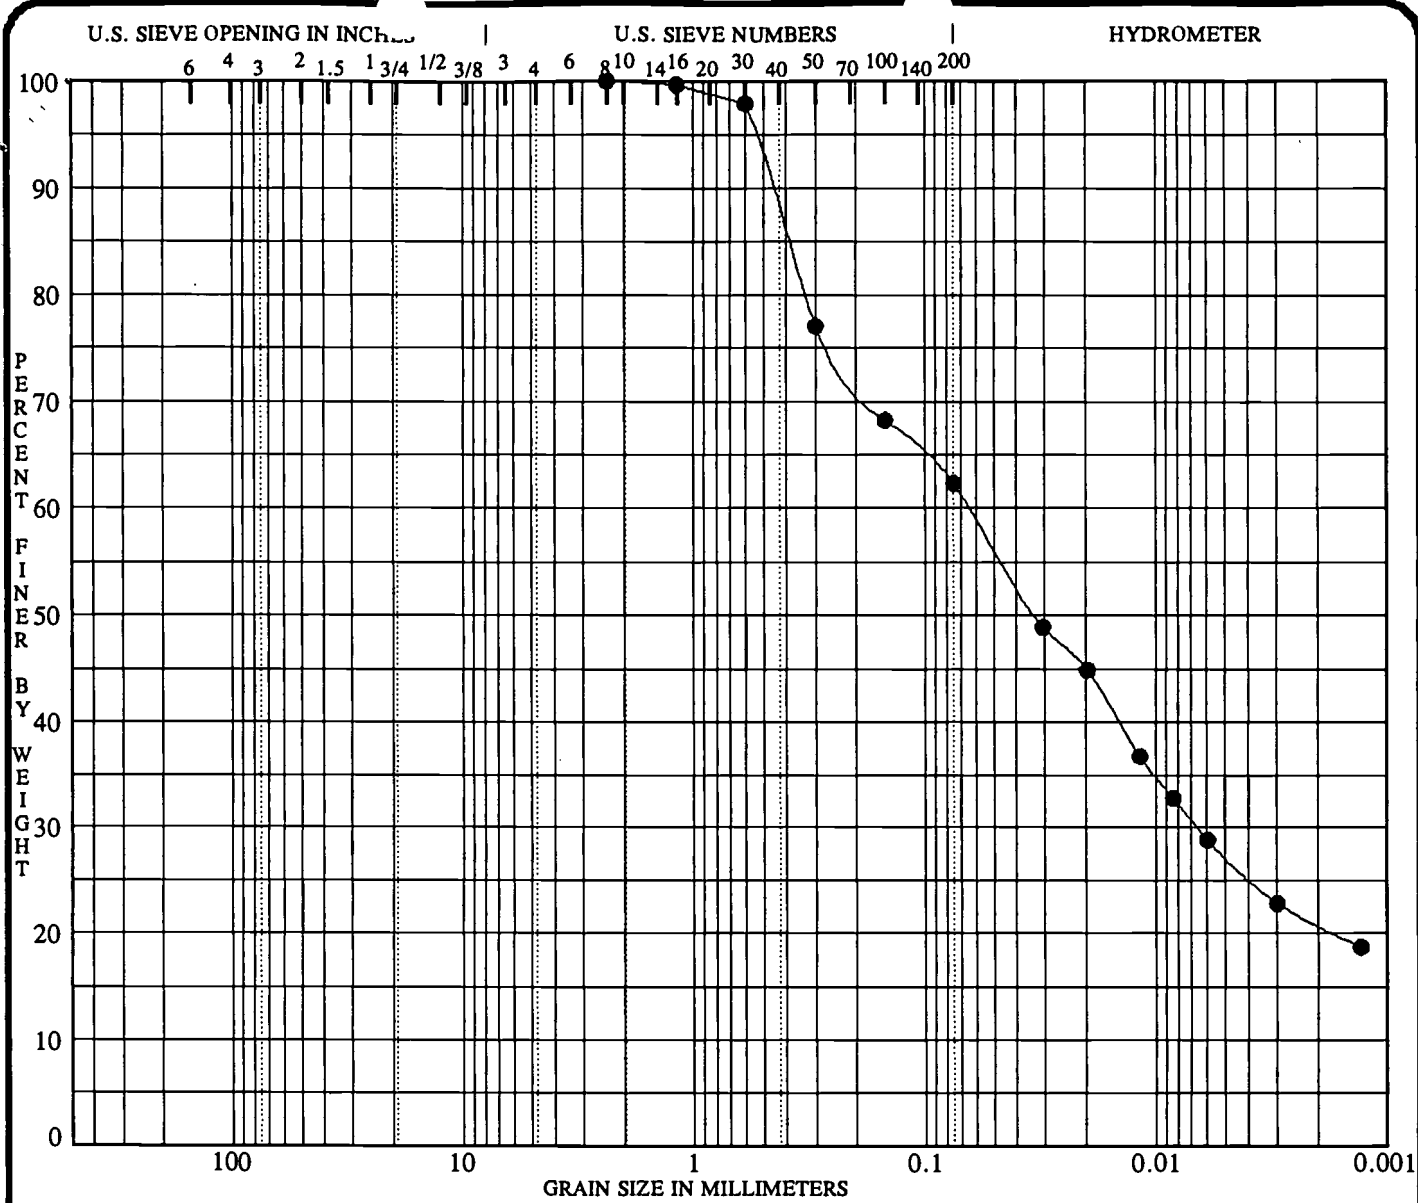

COBBLES	GRAVEL		SAND			SILT OR CLAY
	coarse	fine	coarse	medium	fine	


Specimen Identification	Classification	MC%	LL	PL	PI	Sp.Gr.
● 9904 2.0			34.0	18.4	15.6	
	SANDY LEAN CLAY CL					
	COMPOSITE - 2.0'-5.0'					

Specimen Identification	D100	D60	D30	D10	%Gravel	%Sand	%Fines	% < .002
● 9904 2.0	2.360	0.064	0.007		0.0	37.7	62.3	20.8

PROJECT ROCKPORT PLANT - ROCKPORT, INDIANA JOB NO. WO#SC3750
 DATE 06/01/99

GRADATION CURVES
 American Electric Power Service Corp.
 Groveport, Ohio



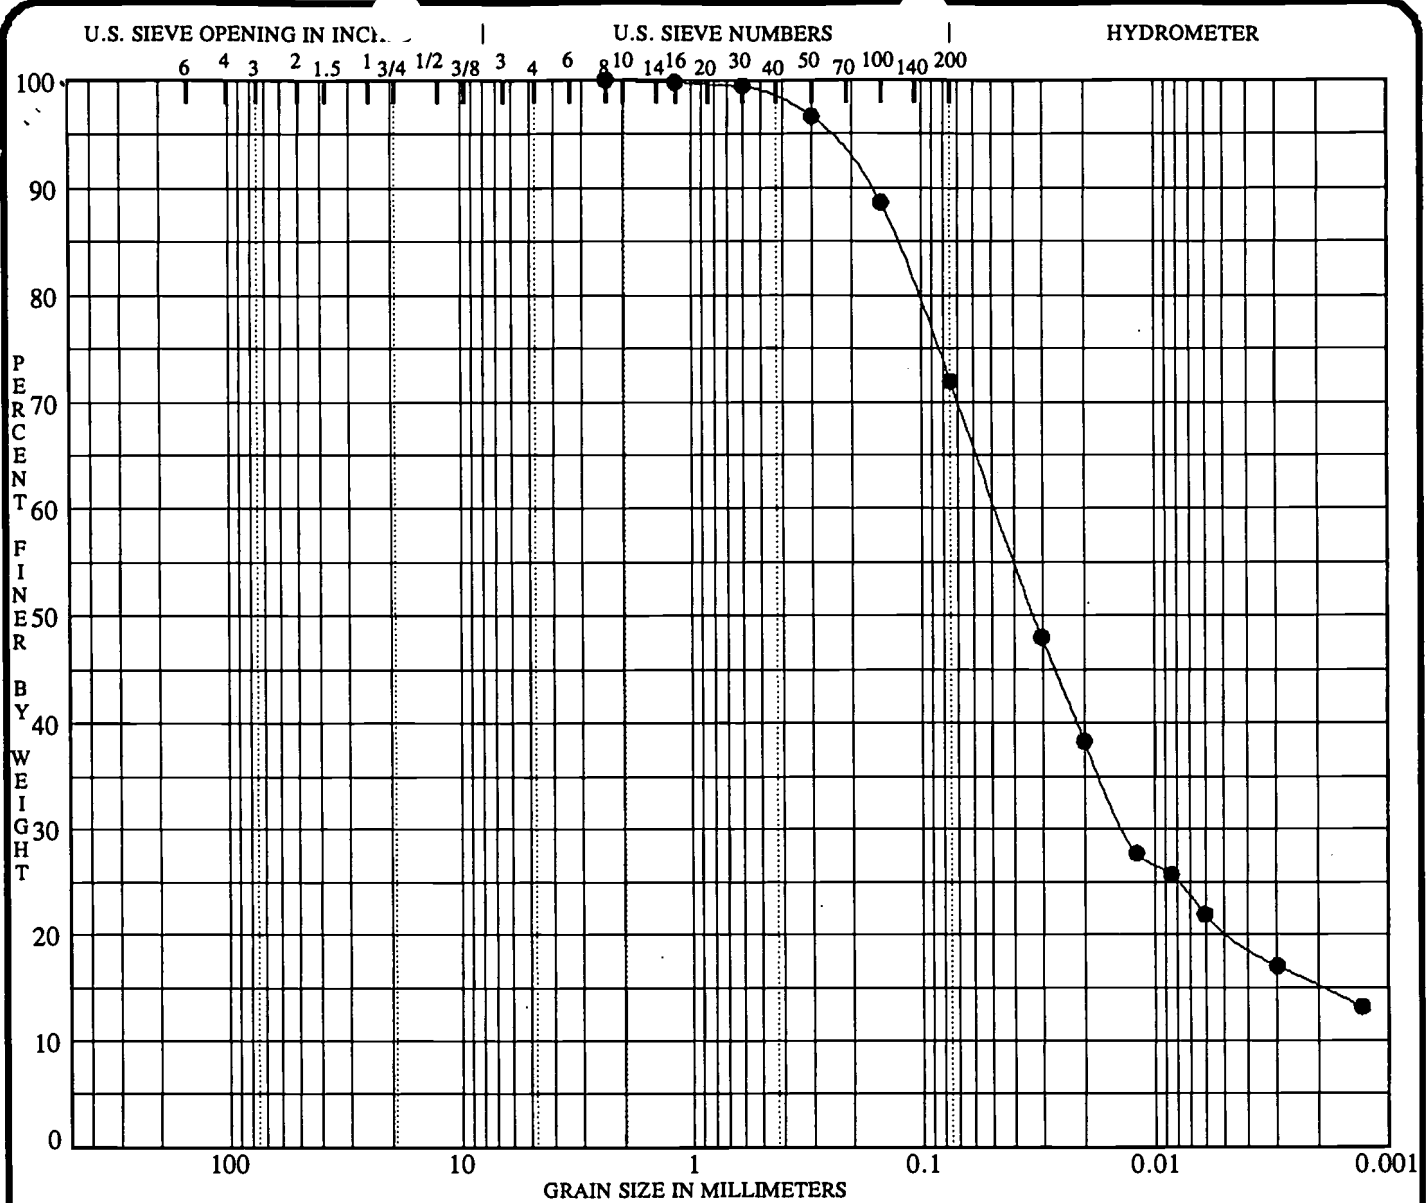

COBBLES	GRAVEL		SAND			SILT OR CLAY
	coarse	fine	coarse	medium	fine	


Specimen Identification	Classification	MC%	LL	PL	PI	Sp.Gr.
● 9904 8.0			26.6	17.7	8.9	
	LEAN CLAY with SAND CL					
	COMPOSITE 8.0'-11.0'					

Specimen Identification	D100	D60	D30	D10	%Gravel	%Sand	%Fines	% < .002
● 9904 8.0	2.360	0.048	0.013		0.0	28.1	71.9	15.2

PROJECT ROCKPORT PLANT - ROCKPORT, INDIANA JOB NO. WO#SC3750
 DATE 06/01/99

GRADATION CURVES
 American Electric Power Service Corp.
 Groveport, Ohio



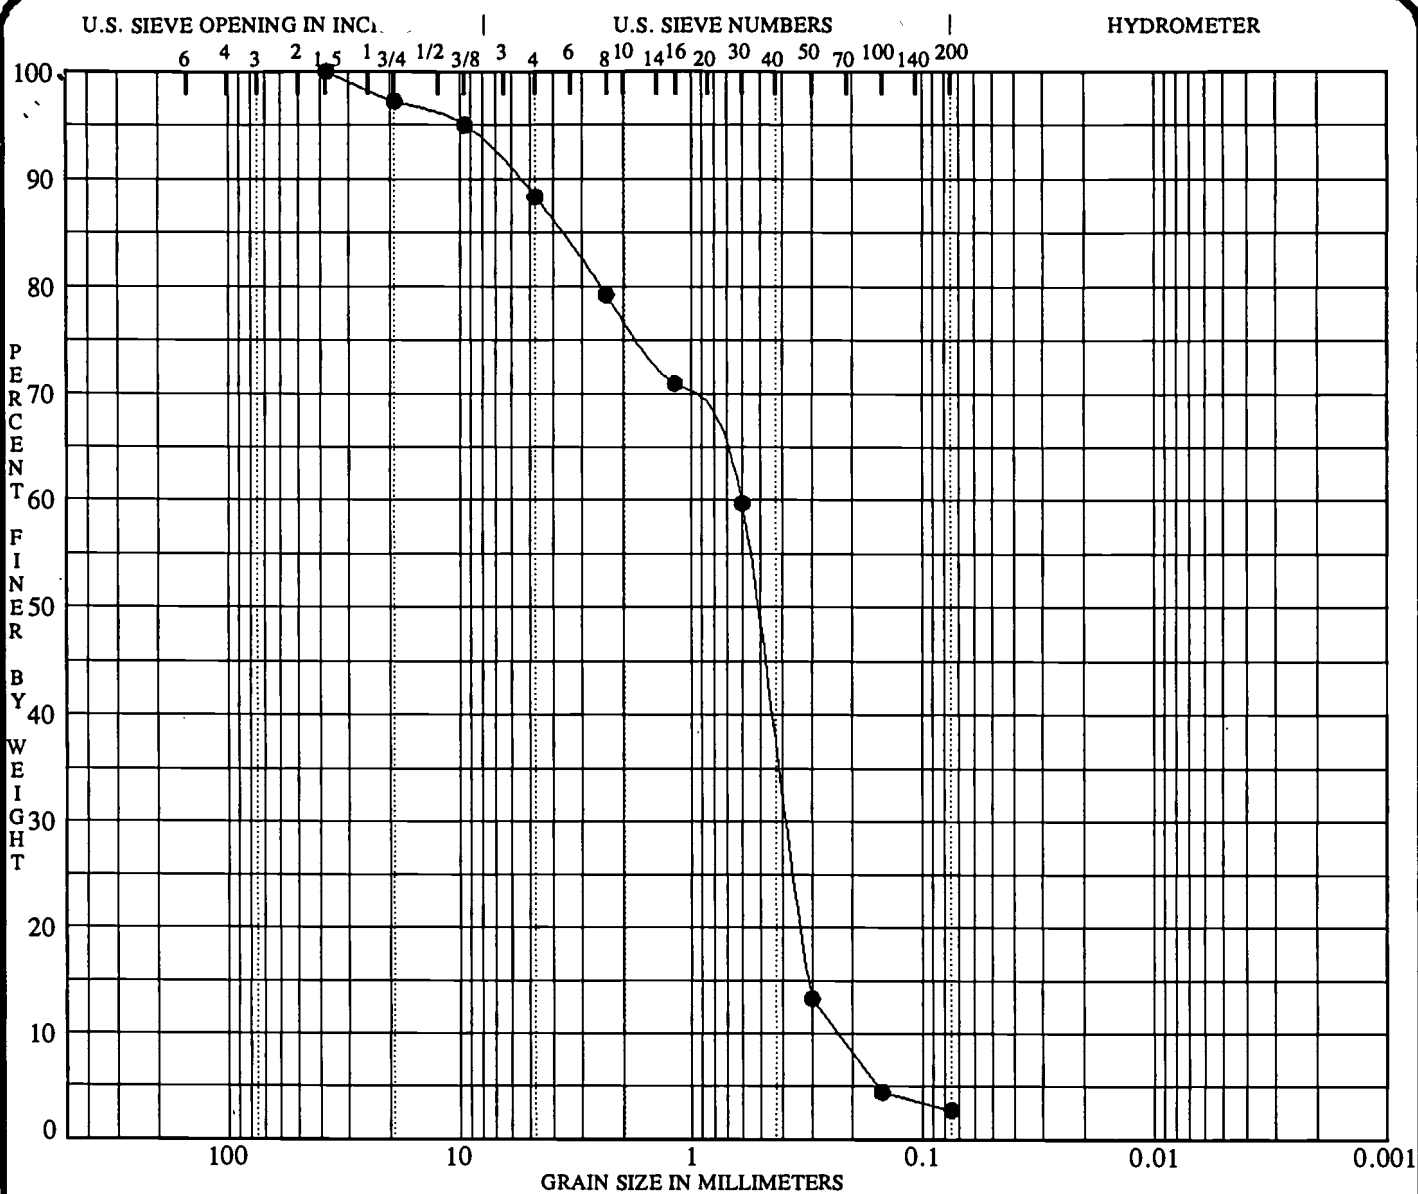

COBBLES	GRAVEL		SAND			SILT OR CLAY
	coarse	fine	coarse	medium	fine	


Specimen Identification	Classification					MC%	LL	PL	PI	Sp.Gr.
● 9904 30.0							NP	NP	NP	
POORLY GRADED SAND SP										
WELL #4-S COMPOSITE SAMPLE 30.0'-40.0'										

Specimen Identification	D100	D60	D30	D10	%Gravel	%Sand	%Fines	% < .002
● 9904 30.0	37.500	0.611	0.385	0.231	11.7	85.5	2.8	

PROJECT ROCKPORT PLANT - ROCKPORT, INDIANA JOB NO. WO#1352
 DATE 04/22/99

GRADATION CURVES
 American Electric Power Service Corp.
 Groveport, Ohio



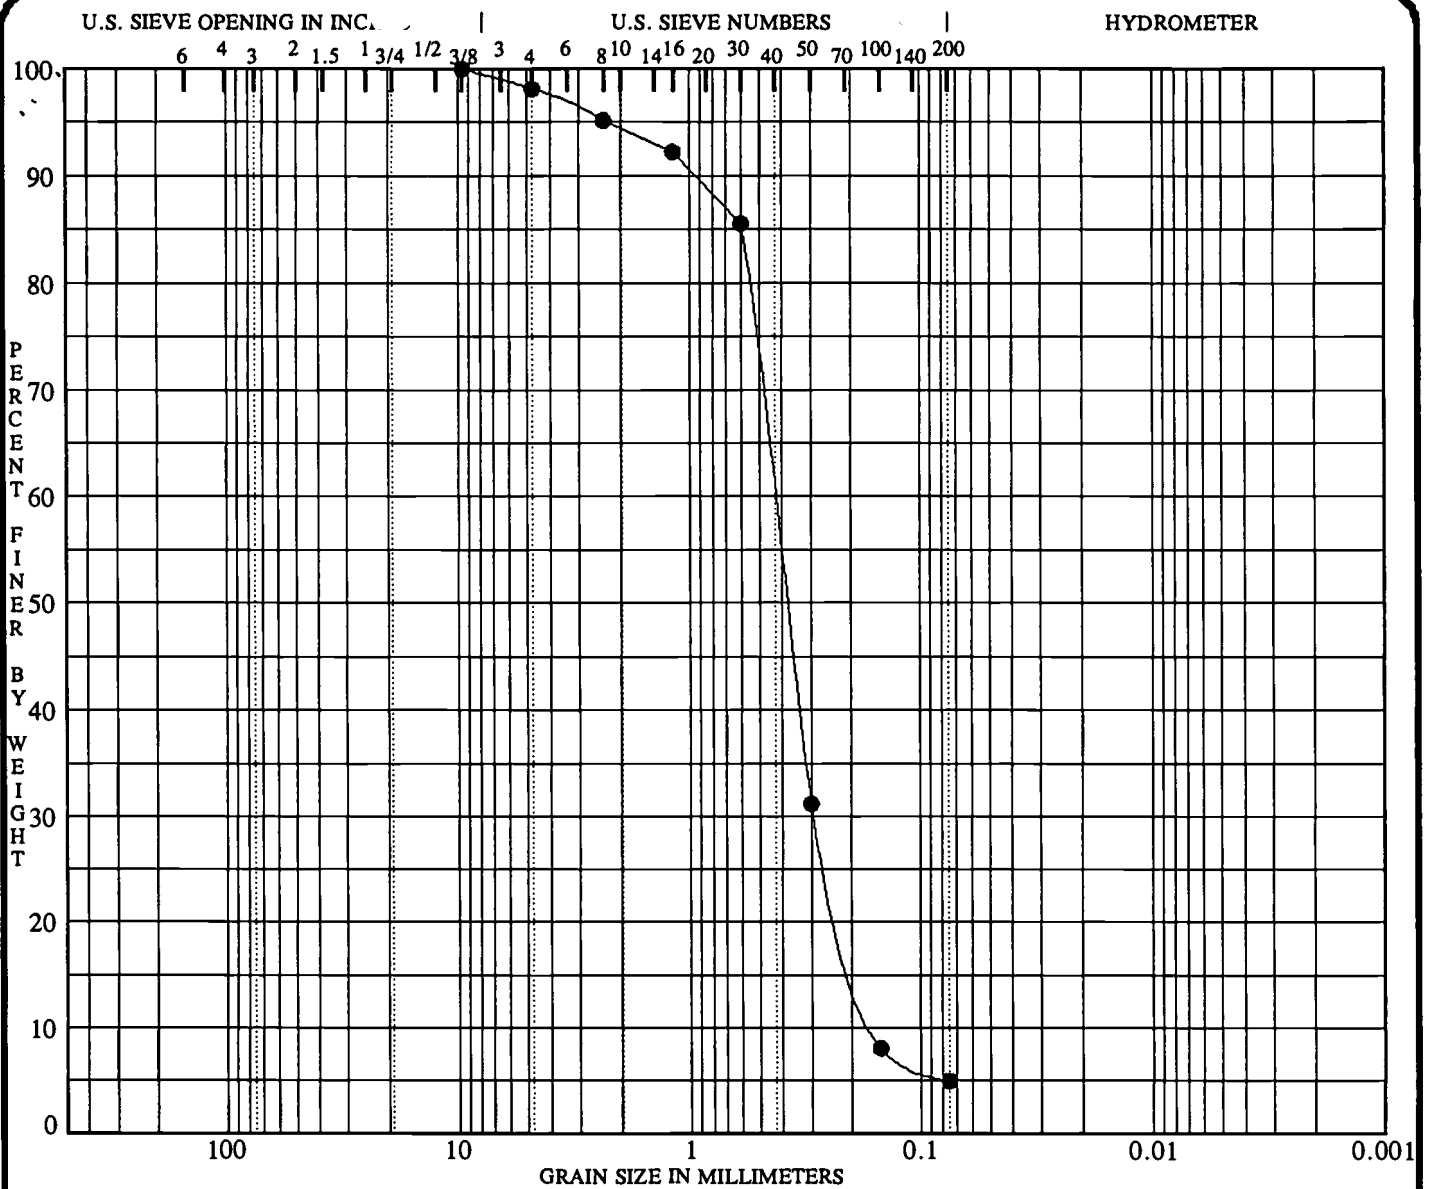

COBBLES	GRAVEL		SAND			SILT OR CLAY
	coarse	fine	coarse	medium	fine	

Specimen Identification	Classification	MC%	LL	PL	PI	Sp.Gr.
● 9904 53.1			NP	NP	NP	
	POORLY GRADED SAND with SILT SP-SM					
	WELL #4-I COMPOSITE SAMPLE 53.1'-63.1'					

Specimen Identification	D100	D60	D30	D10	%Gravel	%Sand	%Fines	% < .002
● 9904 53.1	9.500	0.433	0.289	0.159	1.9	93.1	5.0	

PROJECT ROCKPORT PLANT - ROCKPORT, INDIANA JOB NO. WO#1352
 DATE 04/22/99

GRADATION CURVES
 American Electric Power Service Corp.
 Groveport, Ohio




I & M
Rockport Plant
Ash Storage Area
Well No. 5-S
5-10-84

MW-5S

5/31/2016
Reference Point
396.08
(top of 4" coupler,
lid removed)

5/31/2016
Top of Ground
393.42

2" PVC Pipe

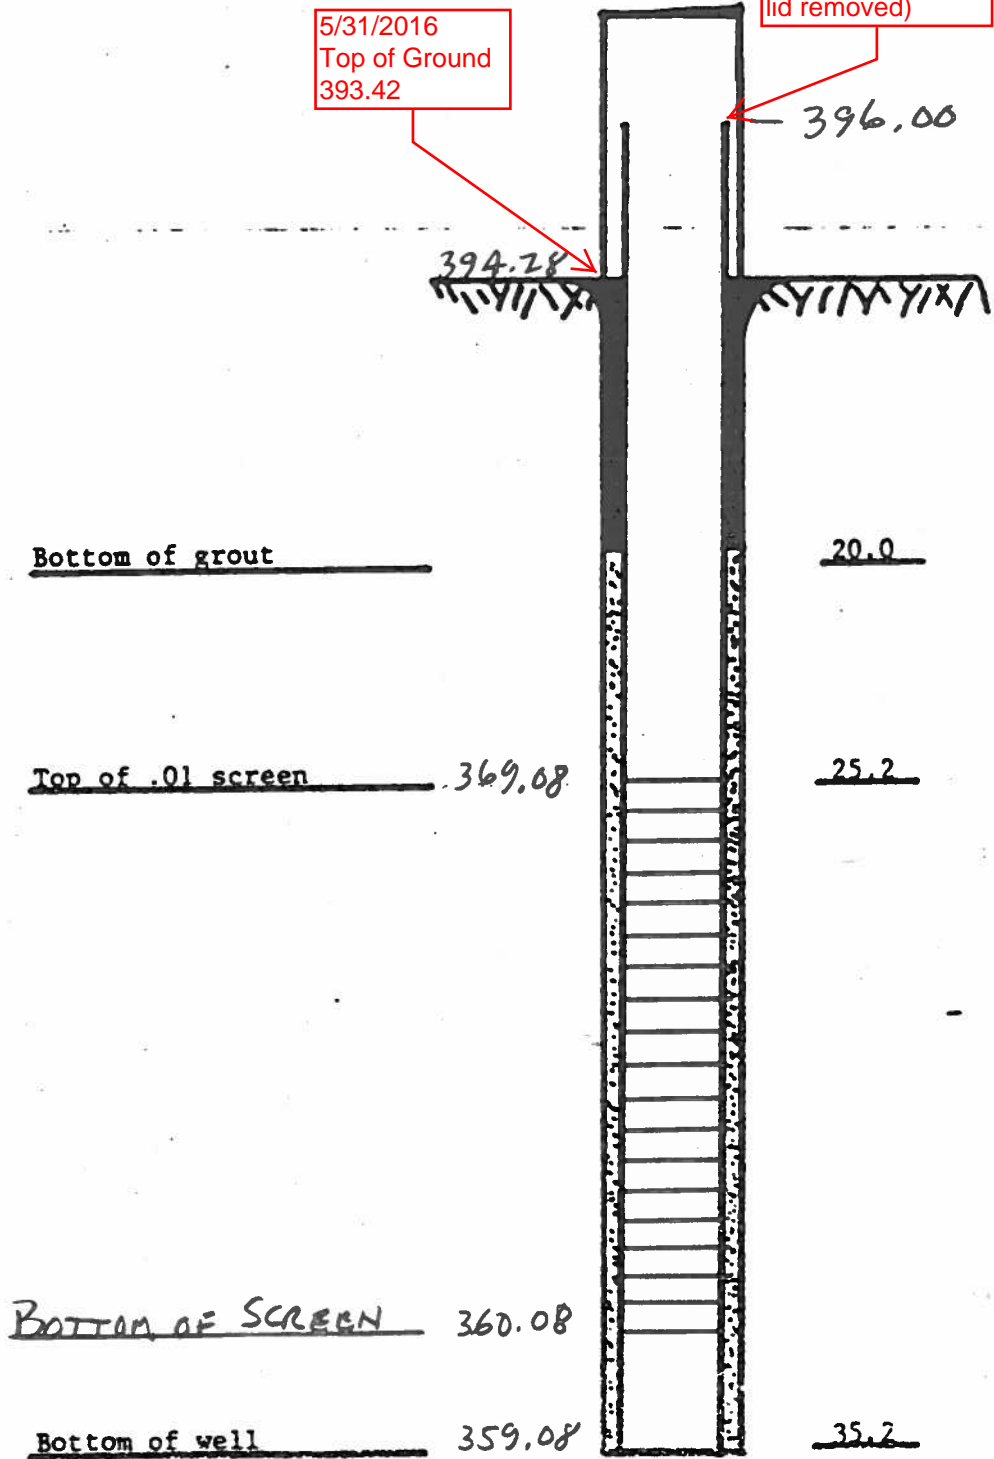

I & M
Rockport Plant
Ash Storage Area
Well No. 5-I
5-22-84

MW-5I

5/31/2016
Reference Point
394.17
(top of 3" protector
pipe, cap removed)

5/31/2016
Top of Ground
393.39

2" PVC Pipe

Bottom of grout


28.5

Top of .01 screen

30.0

Bottom of well

40.0

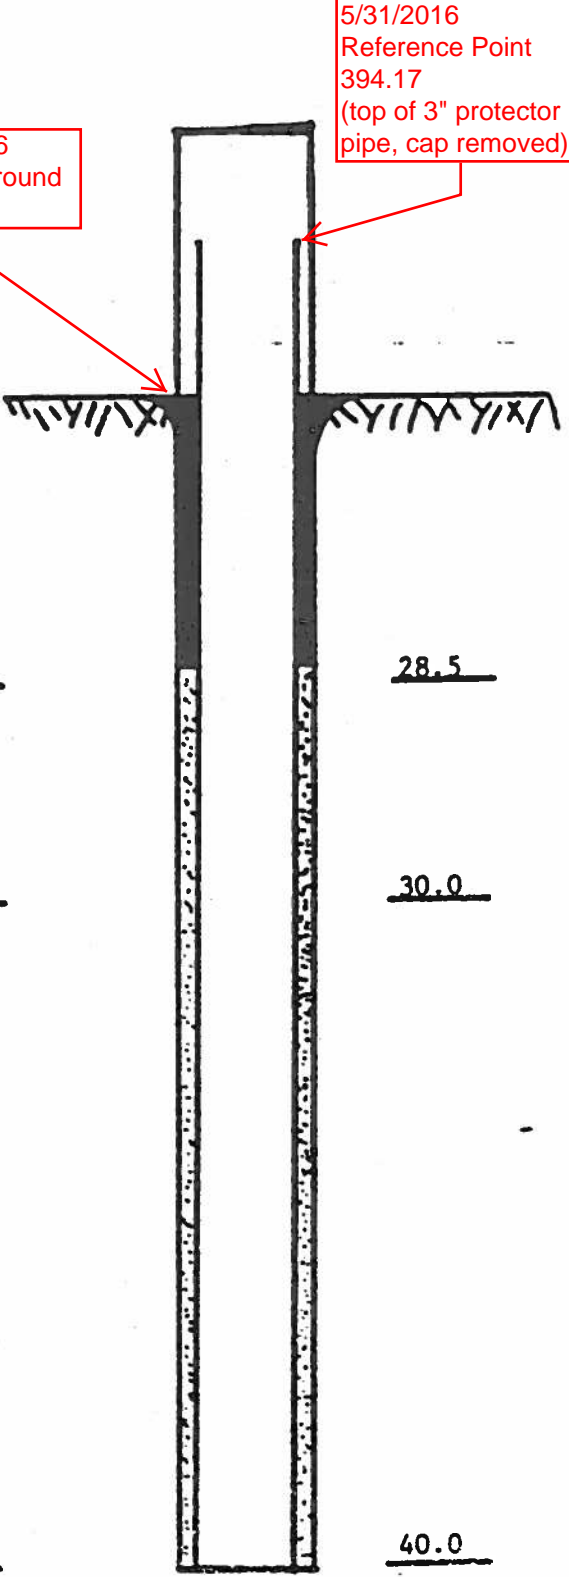

AME AN ELECTRIC POWER SERVICE CO. CORPORATION
AEP CIVIL ENGINEERING LABORATORY
 LOG OF BORING



JOB NUMBER _____
 COMPANY INDIANA MICHIGAN POWER COMPANY
 PROJECT ROCKPORT PLANT
 COORDINATES N 164,993.0 E 520,610.0
 GROUND ELEVATION 392.1 SYSTEM _____

MW-5
 BORING NO. 9905 DATE 4/27/99 SHEET 1 OF 2
 BORING START 2/12/99 BORING FINISH 2/12/99
 PIEZOMETER TYPE _____ WELL TYPE OW
 HGT. RISER ABOVE GROUND _____ DIA _____
 DEPTH TO TOP OF WELL SCREEN _____ BOTTOM _____
 WELL DEVELOPMENT _____ BACKFILL Grout
 FIELD PARTY MCR-DLB RIG BK-81

WATER LEVEL	▽	▽	▽
TIME			
DATE			

SAMPLE NUMBER	SAMPLE	SAMPLE DEPTH IN FEET		STANDARD PENETRATION RESISTANCE BLOWS / 6"	TOTAL LENGTH RECOVERY	RQD %	DEPTH IN FEET	GRAPHIC LOG	USCS	SOIL / ROCK IDENTIFICATION	WELL	DRILLER'S NOTES
		FROM	TO									
1	SS	0.0	2.0	1-1-2-2	2.0				CL	BROWN CLAY With organics		Water from fire protection well at Rockport Plant was used for drilling and grouting. Decon drill and hand tools before drilling. No drill mud used. Grouted from 58.6' to grade. Used approx. 50 gallons; 2 bags.
2	SS	2.0	4.0	2-2-3-3	2.0				CL	GRAY CLAY Moist		
3	SS	4.0	6.0	2-2-3-4	2.0		5					
4	SS	6.0	8.0	2-3-3-4	2.0							
5	SS	8.0	10.0	1-2-2-2	2.0				CL	BROWNISH GRAY SILTY CLAY Dry		
6	SS	10.0	12.0	1-1-2-2	2.0		10					
7	SS	12.0	14.0	1-1-1-1	2.0				CL	GRAY CLAY Soft, wet		
8	SS	14.0	16.0	0-0-0-0	2.0				CL	BLUISH GRAY SILTY CLAY Soft, moist		
9	SS	16.0	18.0	1-1-2-3	2.0				CL	BLUISH SANDY CLAY Wet		
10	SS	18.0	20.0	1-1-2-2	2.0							
11	SS	20.0	21.9	10-15-25-50/2	1.7		20		SP	SAND With pea to 1/2" gravel, wet		
12	NQ-2	21.9	24.6		2.2					BLUISH GRAY SHALE Dry		
13	NQ-2	24.6	33.6		4.8		25			BLUISH GRAY SANDY CLAYSTONE BLUISH GRAY SANDY SHALE LIGHT GRAY LIMESTONE		
							30					
14	NQ-2	33.6	43.6		10		35			TOP 5.0 - DARK GRAY SHALE BOTTOM 5.0 - DARK GRAY SANDY SHALE		

AEP ROCKPORT AEP FULL GDT 4/27/99

TYPE OF CASING USED

Continued Next Page

X	NQ-2 ROCK CORE	
X	6" x 3.25 HSA	
	9" x 6.25 HSA	
	HW CASING ADVANCER	4"
	NW CASING	3"
	SW CASING	6"
	AIR HAMMER	8"

PIEZOMETER TYPE: PT = OPEN TUBE POROUS TIP, SS = OPEN TUBE SLOTTED SCREEN, G = GEONOR, P = PNEUMATIC
 WELL TYPE: OW = OPEN TUBE SLOTTED SCREEN, GM = GEOMON
 RECORDER DLB

AME AN ELECTRIC POWER SERVICE CORPORATION
AEP CIVIL ENGINEERING LABORATORY
 LOG OF BORING



JOB NUMBER _____


COMPANY **INDIANA MICHIGAN POWER COMPANY**

BORING NO. **9905** DATE **4/27/99** SHEET **2** OF **2**

PROJECT **ROCKPORT PLANT**

BORING START **2/12/99** BORING FINISH **2/12/99**

SAMPLE NUMBER	SAMPLE	SAMPLE DEPTH IN FEET		STANDARD PENETRATION RESISTANCE BLOWS / 6"	TOTAL LENGTH RECOVERY	RQD	DEPTH IN FEET	GRAPHIC LOG	USCS	SOIL / ROCK IDENTIFICATION	WELL	DRILLER'S NOTES
		FROM	TO			%						
15	NQ-2	43.6	53.6		9.6		45			TOP 1.5 - DARK GRAY SANDY SHALE 0.5 - COAL, fractured 0.6 - DARK GRAY CLAYSTONE 7.0 - GRAY CLAYSTONE		
16	NQ-2	53.6	58.6		5.5		55			LIGHT GRAY SANDY SHALE		
												Stopped boring at 58.6' on 2/12/99

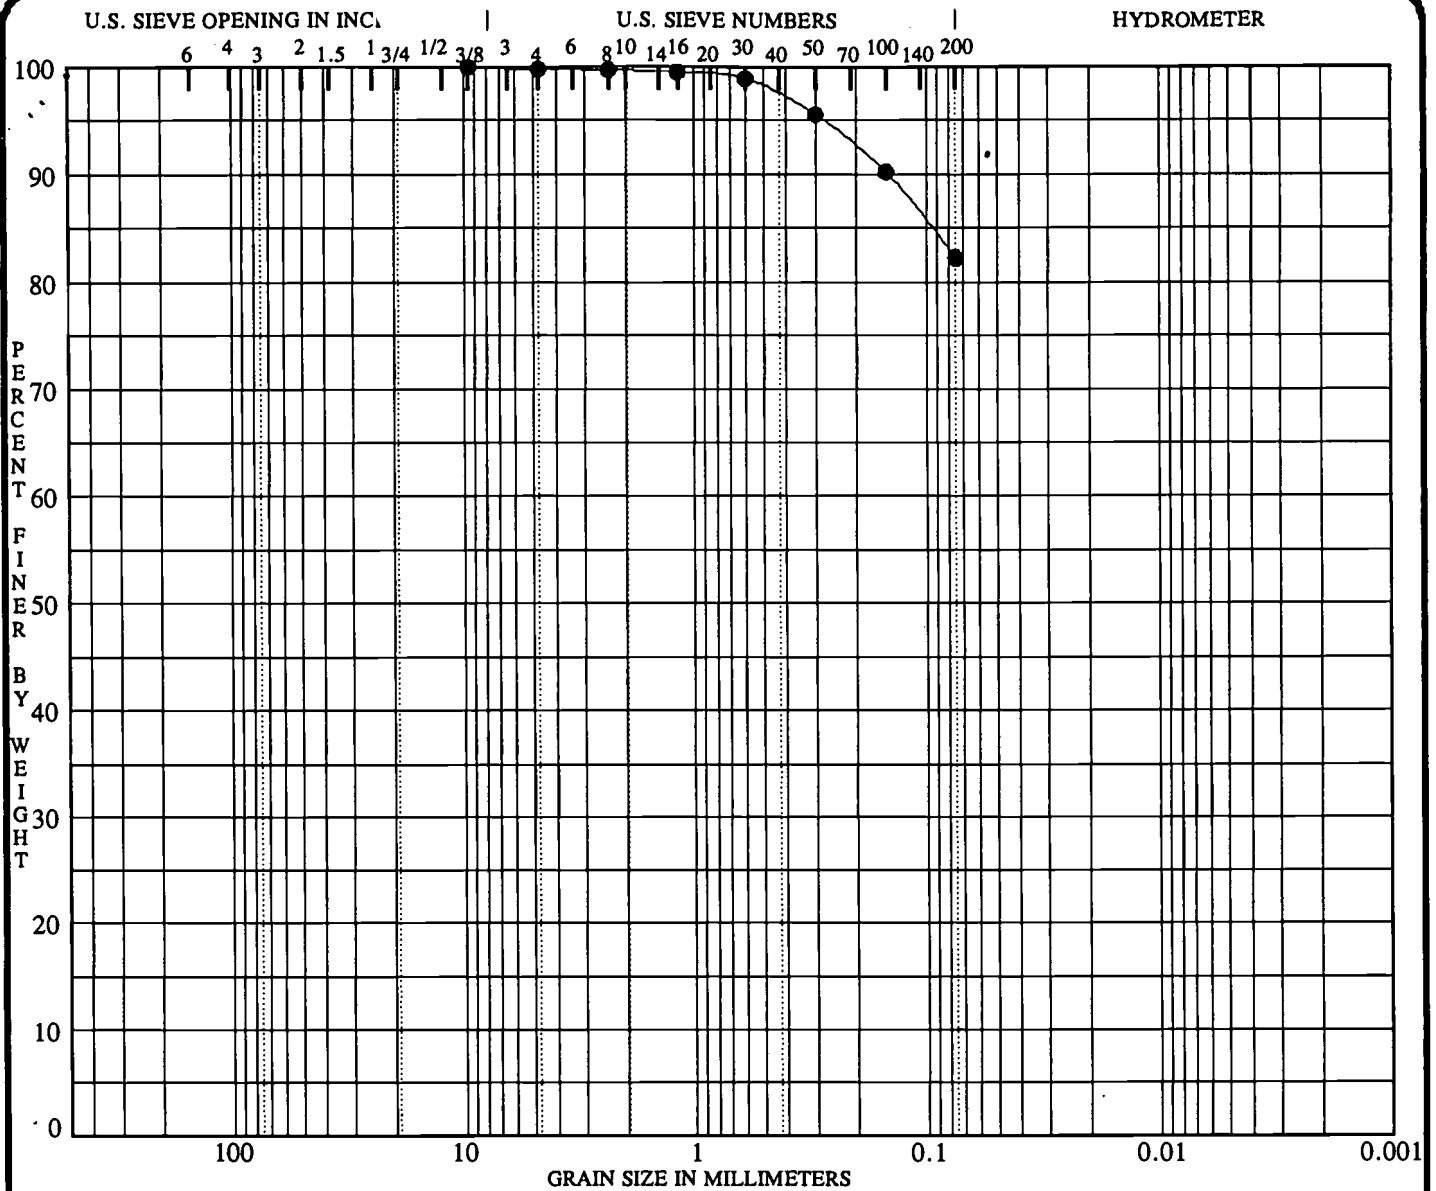

COBBLES	GRAVEL		SAND			SILT OR CLAY
	coarse	fine	coarse	medium	fine	

Specimen Identification	Classification	MC%	LL	PL	PI	Sp.Gr.
● 9905 2.0			NP	NP	NP	
	SILT with SAND ML					
	COMPOSITE SAMPLE 2.0'-20.0'					

Specimen Identification	D100	D60	D30	D10	%Gravel	%Sand	%Fines	% < .002
● 9905 2.0	9.500				0.2	17.6	82.2	

PROJECT ROCKPORT PLANT - ROCKPORT, INDIANA JOB NO. WO#1352
 DATE 04/22/99

GRADATION CURVES
 American Electric Power Service Corp.
 Groveport, Ohio




I & M.
Rockport Plant
Ash Storage Area
Well No. 6-S
5-17-84

MW-6S

5/31/2016
Reference Point
394.72
(top of 2" PVC pipe)

5/31/2016
Top of Ground
392.98

2" PVC Pipe

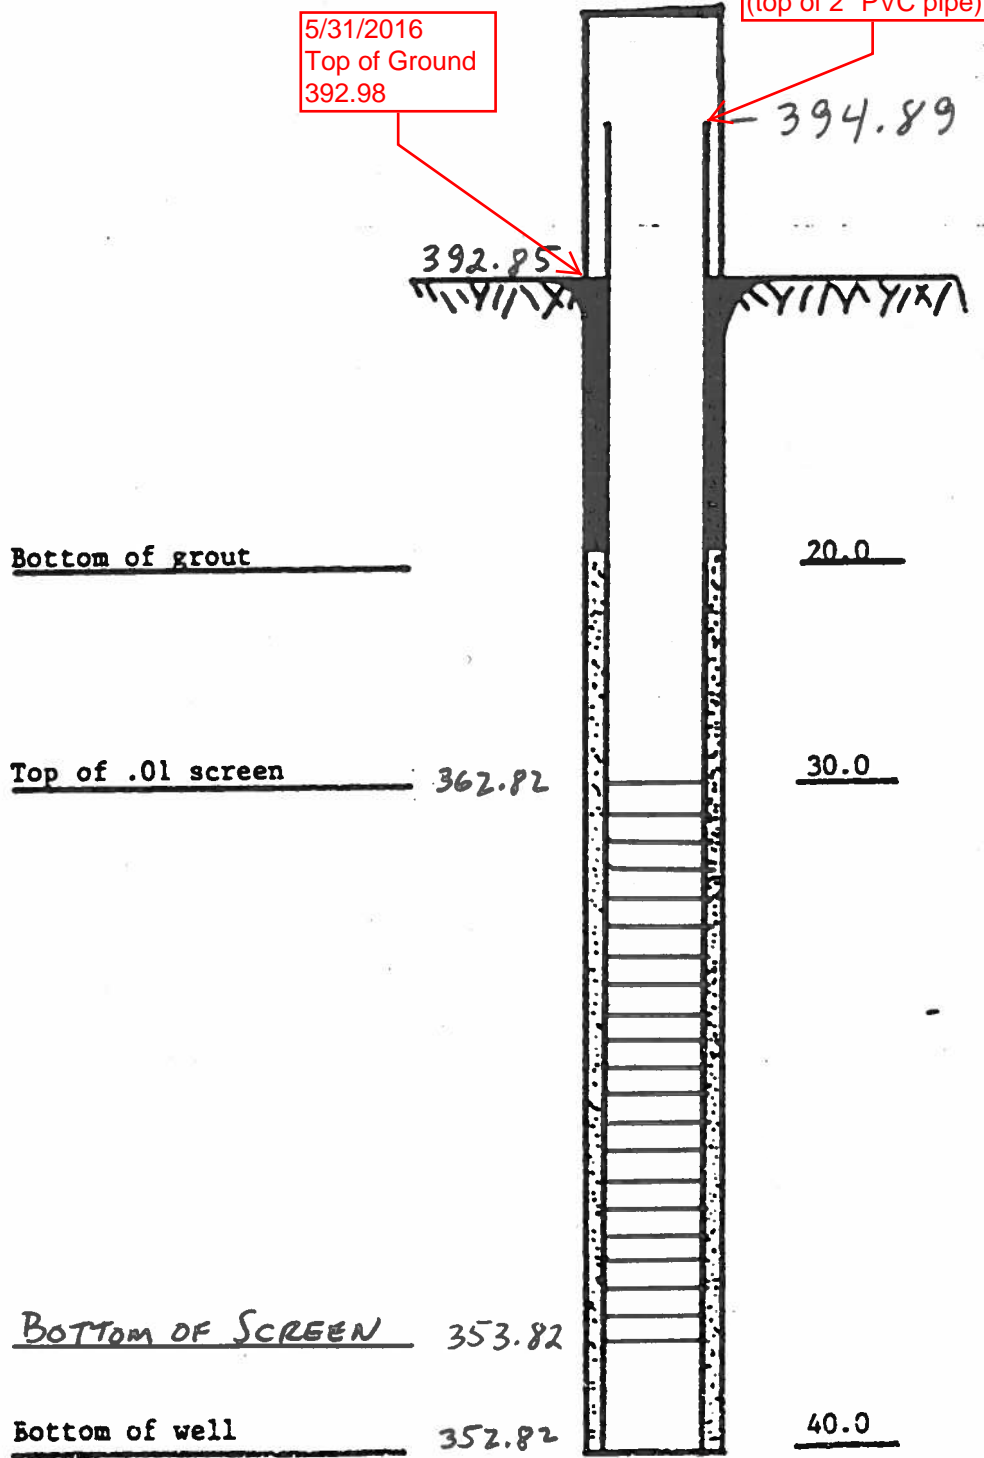


I & M
Rockport Plant
Ash Storage Area
Well No. 7-S
5-1-84

MW-7S

5/31/2016
Reference Point
393.70
(top of 4" coupler,
lid removed)

5/31/2016
Top of Ground
392.87

2" PVC Pipe

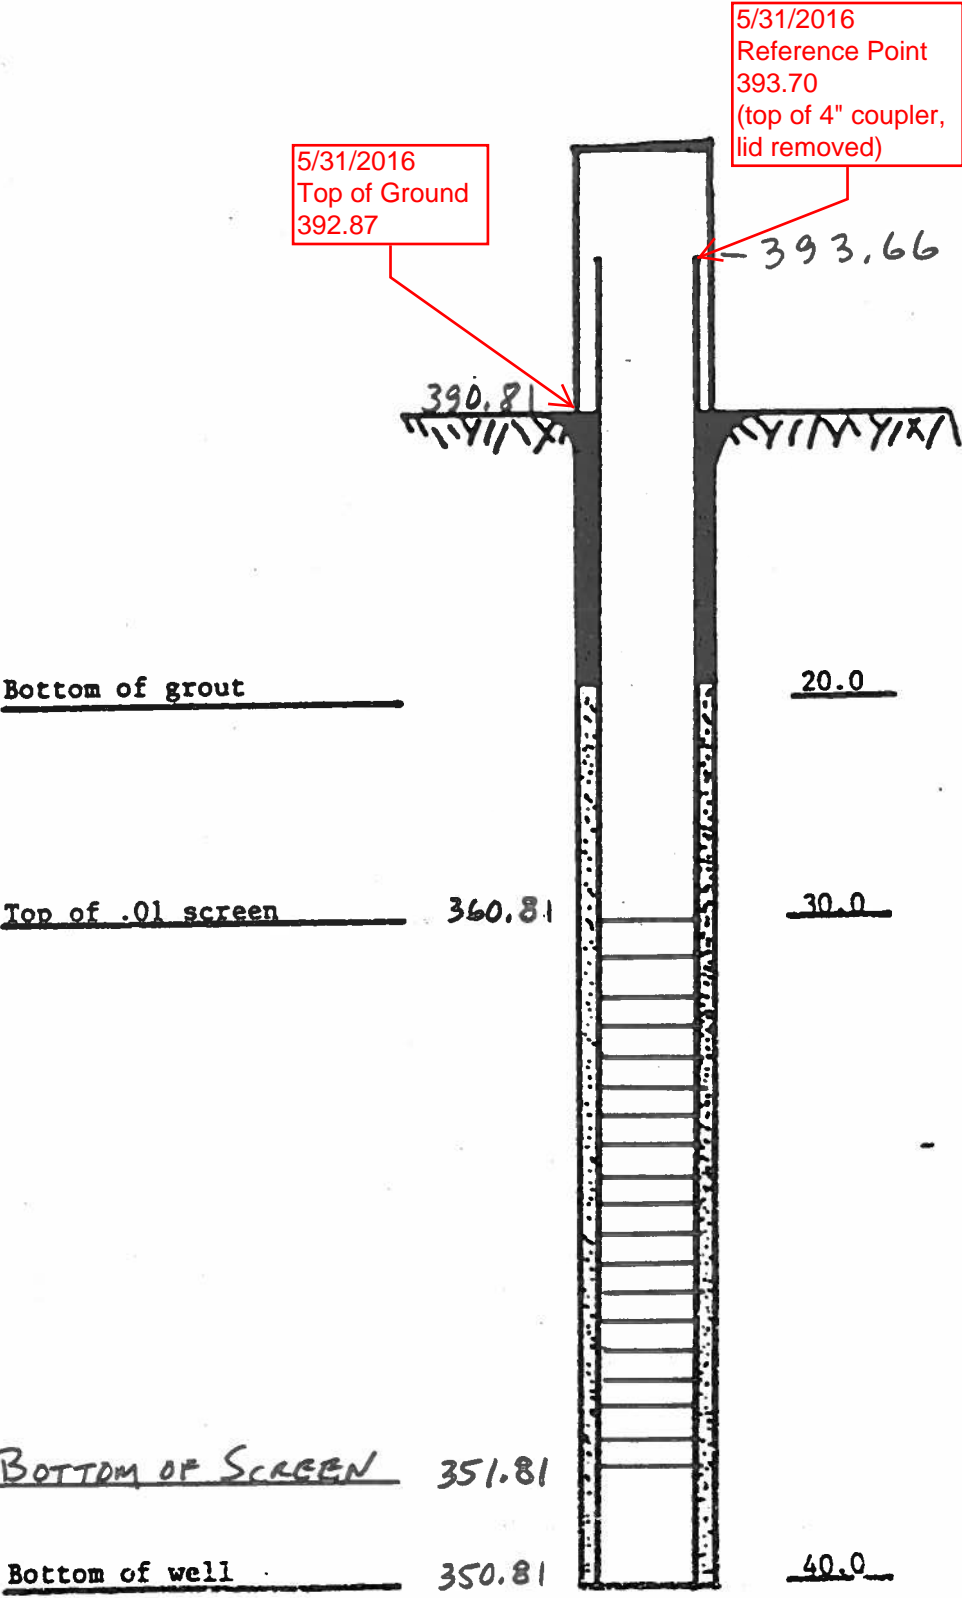


I & M.
Rockport Plant
Ash Storage Area
Well No. 7-I
5-24-84

MW-7I

5/31/2016
Reference Point
393.49
(top of 4" coupler,
lid removed)

5/31/2016
Top of Ground
392.66


2" PVC Pipe

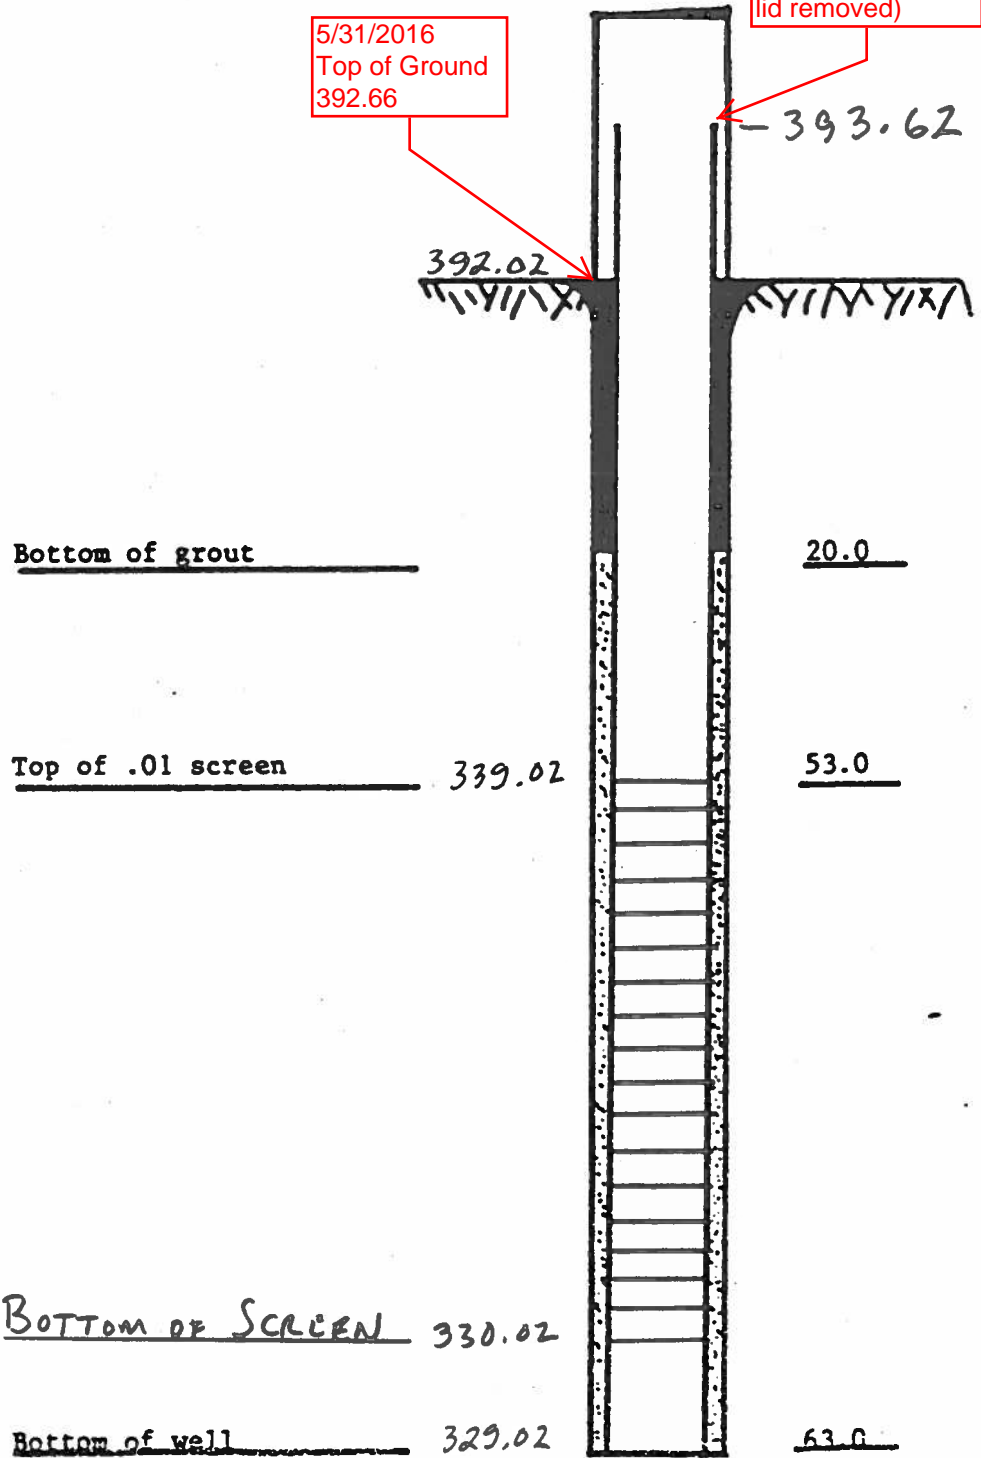

I & M
Rockport Plant
Ash Storage Area
Well No. 8-S
5-8-84

MW-8S
(Abandoned)

2" PVC Pipe

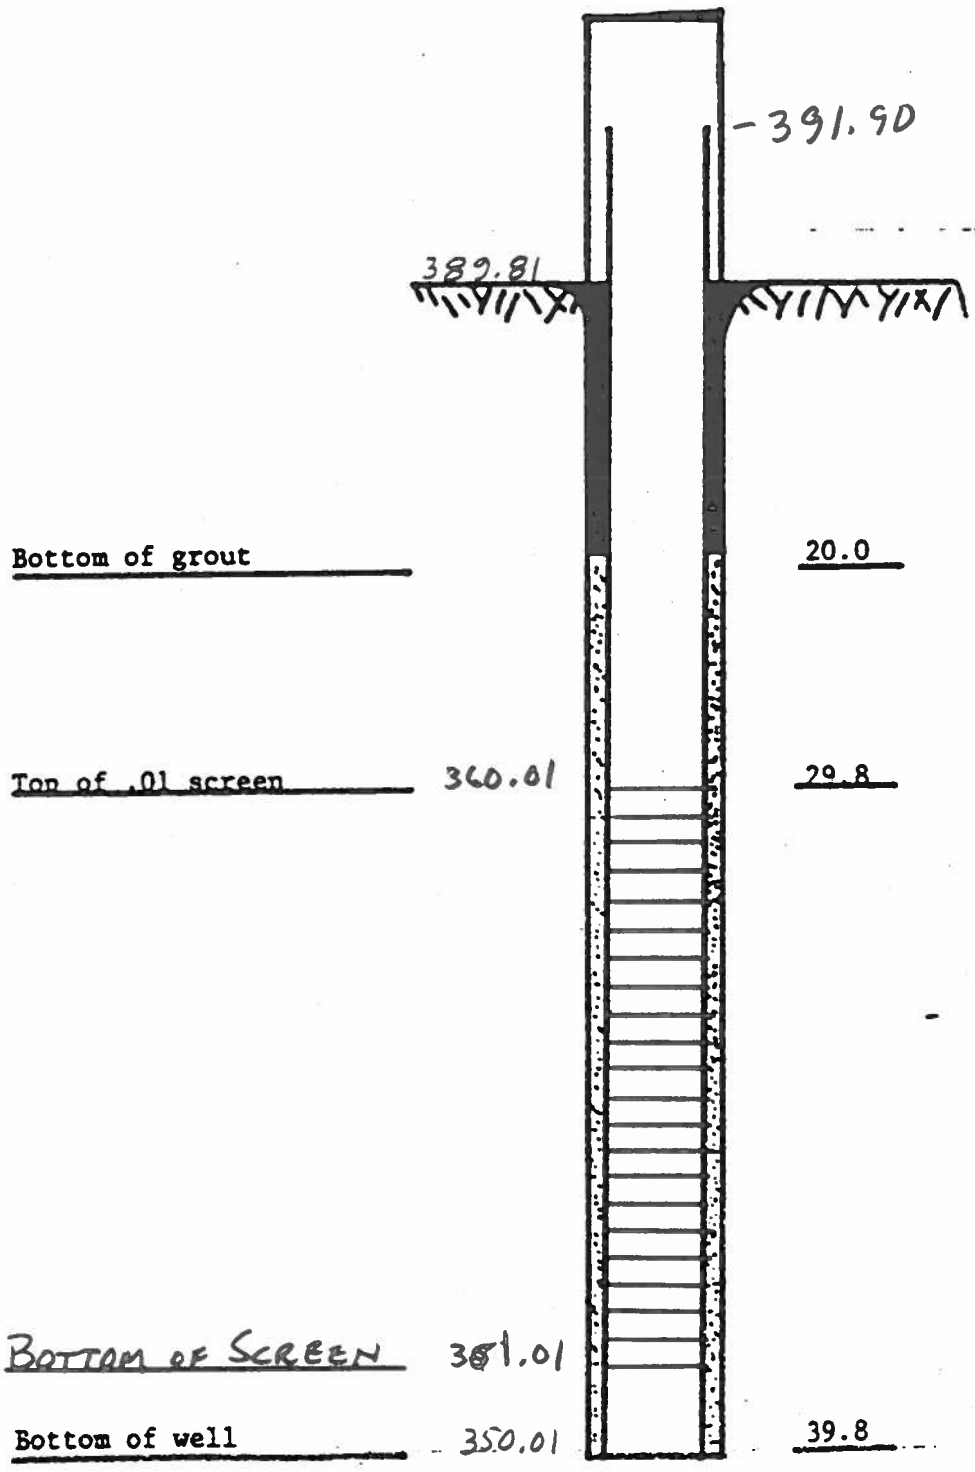



RECORD OF WATER WELL
State Form 35880 (RS / 9-04)

Driller—Mail complete record in 30 days to:
INDIANA DEPT. OF NATURAL RESOURCES
Division of Water
402 W. Washington St., Rm. W264
Indianapolis, IN 46204-2641
(877) 928-3755 toll-free or (317) 233-4160

County Permit Number
DNR Variance Number
Include if applicable

Fill in completely

WELL LOCATION					
County where drilled Spencer	Civil township name Ohio	Township number (N-S) 6-5	Range number (E-W) 5-W	Section 31	
Driving directions to the well location (include trip origin, street & road names, intersecting roads, and compass directions). Show well address below and subdivision in box at lower right. There is space for a map on the reverse side. US 231 ~ 5 mi. to CR 350 (E of 231). ~ 2 mi. to entrance of landfill on N side of CR 350.			UTM Northing 162926.8	UTM Easting 517492.5	
Well address: 2791 N US Hwy 231 Rockport, IN, 47635			Datum <input checked="" type="checkbox"/> NAD 27 <input type="checkbox"/> NAD 83	GPS used	
If drilled for water supply, this well is: <input type="checkbox"/> First well on property <input type="checkbox"/> Replacement well <input type="checkbox"/> Additional well on property <input type="checkbox"/> Dry hole					
OWNER - CONTRACTOR					
Well owner—name ISM Rockport Plant			Telephone number 812-649-9171		
Address (number and street, city, state, ZIP code) 2791 N US Hwy 231 Rockport, IN, 47635					
Building contractor—name ARP Solar Lab		Address (number and street, city, state, ZIP code) 4001 Bixby Rd, Groveport, OH 43125		Telephone number 614-836-4200	
Drilling contractor—name ARP Solar Lab		Address (number and street, city, state, ZIP code) 4001 Bixby Rd, Groveport, OH, 43125		Telephone number 614-836-4200	
Equipment operator—name Rick E. Bankes		License number of operator		Date of well completion 10/30/13	
CONSTRUCTION DETAILS			WELL LOG		
Use of well <input type="checkbox"/> Home <input type="checkbox"/> Public supply <input type="checkbox"/> Industrial / commercial <input type="checkbox"/> Livestock <input type="checkbox"/> Irrigation <input type="checkbox"/> Monitoring / environ. <input type="checkbox"/> Test hole Other:		Drilling method <input type="checkbox"/> Rotary <input type="checkbox"/> Reverse rotary <input type="checkbox"/> Cable tool <input type="checkbox"/> Jet <input type="checkbox"/> Bucket / bore <input type="checkbox"/> Auger (including HSA) <input type="checkbox"/> Direct push Other:		Type of pump <input type="checkbox"/> Submersible <input type="checkbox"/> Shallow-well jet <input type="checkbox"/> Deep-well jet <input type="checkbox"/> No pump installed Other:	
Total depth of well (feet)		Borehole diameter (in.)		FORMATIONS: Type of material	
Casing length (feet)		Casing diameter (in.)		From (feet)	
Screen length (feet)		Screen diameter (in.)		To (feet)	
Screen slot size		Water quality (clear, odor, etc.)		From Top of Pipe 31W 25.15'	
Test method <input type="checkbox"/> Air <input type="checkbox"/> Bailing <input type="checkbox"/> Pumping		Static level below surface		From Top of PVC Bottom of Well 43.9'	
Gallons per min.		Hours tested		100 Gals of lean cement grout to fill hole	
Drawdown (change in level)		feet		feet	
GROUTING		WELL ABANDONMENT			
Grout material		Grout depth from to		Sealing material	
Installation method		No. of bags used		Depth filled from to	
				Lean Cement Grout 42 0	
				Tremie Grout 4	
I hereby swear or affirm, under the penalties for perjury, that the information submitted herewith is, to the best of my knowledge and belief, true, accurate, and complete.			Signature of drilling contractor or authorized representative Rick Bankes		
			Additional space for well log and comments on reverse side MUST BE SIGNED OR STAMPED		
			Date 11/25/13		

WELL CLOSURE / ABANDONMENT

American Electric Power Service Corporation / Rockport Plant

Well 8S

Spencer County / Township 6S / Range 5W / Section 31

- **Removed monitoring well pump and recorded static water and sounding of bottom of well.**
- **Removed steel casing protector and concrete pad.**
- **Proceeded to drill 4.25" hollow stem auger over 2" PVC well to bottom.**
- **Once augers reached bottom of well, a 3 7/8" tri-cone roller bit and A rods were placed inside and lowered to a depth of 42.0' below grade. The PVC was pulled from inside of augers.**
- **Flushed out old cuttings.**
- **Finished project by tremie grouting from 42.0' to grade using 100 gallons of lean cement grout.**



RECORD OF WATER WELL
State Form 35680 (R5 / 9-04)

Driller—Must complete record in 30 days to:
INDIANA DEPT. OF NATURAL RESOURCES
Division of Water
402 W. Washington St., Rm. W204
Indianapolis, IN 46204-2641
(877) 828-3733 toll-free or (317) 232-4180

County Permit Number

DNR Variance Number

Include if applicable

Fill in completely

WELL LOCATION						
County where drilled Spencer	Civil township name Ohio	Township number (N-S) 6-5	Range number (E-W) 5-W	Section 31		
Driving directions to the well location (include trip origin, street & road names, intersecting roads, and compass directions). Show well address below and subdivision in box at lower right. There is space for a map on the reverse side. US 231 ~ 5 mi. to CR350 (E of 231). ~ 2 mi. to entrance of landfill on N side of CR350.			UTM Northing 162910.454			
			UTM Easting 517492.008			
			Datum <input checked="" type="checkbox"/> NAD 27 <input type="checkbox"/> NAD 83			
			GPS used <input type="checkbox"/>			
Well address: <input type="checkbox"/> First well on property <input type="checkbox"/> Replacement well <input type="checkbox"/> Additional well on property <input type="checkbox"/> Dry hole			Subdivision name & lot number (if applicable)			
OWNER-CONTRACTOR						
Well owner-name IBM Rockport Plant					Telephone number 812-649-9171	
Address (number and street, city, state, ZIP code) 2791 N US Hwy 231, Rockport, IN, 47635						
Building contractor-name APP - Nolan Lab		Address (number and street, city, state, ZIP code) 4001 Bisby Rd, Groveport, OH 43125		Telephone number 614-836-4200		
Drilling contractor-name APP - Nolan Lab		Address (number and street, city, state, ZIP code) 4001 Bisby Rd, Groveport, OH 43125		Telephone number 614-836-4200		
Equipment operator-name Rich B. Banks		License number of operator 4		Date of well completion 10/30/13		
CONSTRUCTION DETAILS			WELL LOG			
Use of well <input type="checkbox"/> Home <input type="checkbox"/> Public supply <input type="checkbox"/> Industrial / commercial <input type="checkbox"/> Livestock <input type="checkbox"/> Irrigation <input checked="" type="checkbox"/> Monitoring / environ. <input type="checkbox"/> Test hole Other:	Drilling method <input type="checkbox"/> Rotary <input type="checkbox"/> Reverse rotary <input type="checkbox"/> Cable tool <input type="checkbox"/> Jet <input type="checkbox"/> Bucket / bore <input checked="" type="checkbox"/> Auger (Including HSA) <input type="checkbox"/> Direct push Other:	Type of pump <input checked="" type="checkbox"/> Submersible <input type="checkbox"/> Shallow-well jet <input type="checkbox"/> Deep-well jet <input type="checkbox"/> No pump installed Other:	FORMATIONS: Type of material		From (feet)	To (feet)
Total depth of well (feet) 42.0			APP MW-85R			
Borehole diameter (in.) 6.25			Sandy clay		0	9
Casing length (feet) 43.6			Med-Fine sand		9	42
Casing diameter (in.) 2.0						
Screen length (feet) 9.6						
Screen diameter (in.) 2.0						
Screen material <input checked="" type="checkbox"/> PVC <input type="checkbox"/> Steel						
Screen slot size .010						
Water quality (clear, odor, etc.) clear						
WELL CAPACITY TEST						
Test method <input type="checkbox"/> Air <input type="checkbox"/> Sealing <input checked="" type="checkbox"/> Pumping	Static level below surface 26.12 feet	Gallons per min.	Hours tested	Drawdown (change in level) N/A feet		
GROUTING			WELL ABANDONMENT			
Grout material Holeplug	Grout depth from to 42 0	Sealing material	Depth filled from to			
Installation method Tremie	No. of bags used 14	Installation method	No. of bags used			
Additional space for well log and comments on reverse side						
I hereby swear or affirm, under the penalties for perjury, that the information submitted herewith is, to the best of my knowledge and belief, true, accurate, and complete.			Signature of drilling contractor or authorized representative Rich Banks		Date 11/26/13	

AMERICAN ELECTRIC POWER SERVICE CORPORATION
 AEP CIVIL ENGINEERING LABORATORY
 MONITORING WELL CONSTRUCTION




JOB NUMBER _____
 COMPANY INDIANA MICHIGAN POWER COMPANY WELL No. MW-8SR BORING No. MW-8SR INSTALLED 10/30/13
 PROJECT ROCKPORT PLANT
 COORDINATES N 162,910.5 E 517,492.0
 SYSTEM _____







MW-8SR

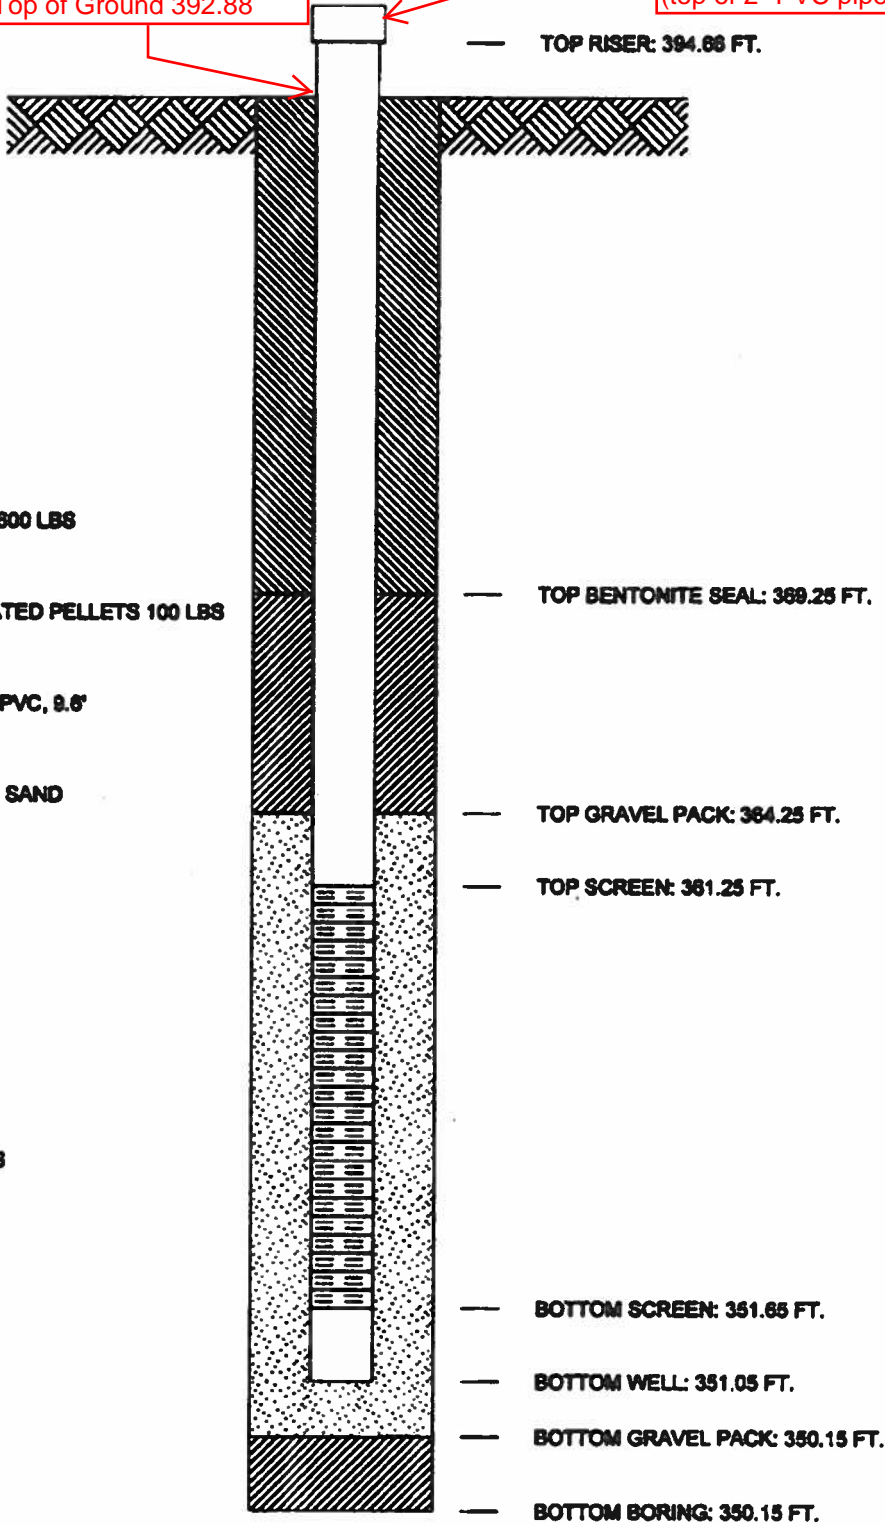5/31/2016
 Reference Point
 394.86
 (top of 2" PVC pipe)

5/31/2016
 Top of Ground 392.88

GROUND ELEVATION 392.15 FT.



-  **GROUT SEAL: HOLE PLUG 600 LBS**
-  **BENTONITE SEAL: 3/8" COATED PELLETS 100 LBS**
-  **SCREEN: 2" dia., .010 SLOT PVC, 9.6'**
-  **GRAVEL PACK: #5 COARSE SAND**
-  **RISER PIPE: 2", dia., PVC**
-  **SPACERS, DEPTH: N/A**

To replace abandoned MW-88

GEOINVEST ROCKPORT PLANT.GPJ AEP.GDT 11/22/13

COMPANY INDIAN AND MICHIGAN POWER CO.
 PROJECT ROCKPORT ASH LANDFILL
 COORDINATES N.162921.29 E.517496.00
 DATE INSTALLED 11-14-92

**WELL CONSTRUCTION
 SUMMARY ELEVATION
 (ft. NGVD)**

WELL NO. 8-I
 REF. DATUM PT. 393.71
 GRADE 391.78


MW-8I

NOTE: CASING PROTECTOR DETAILS
 NOT SHOWN

5/31/2016
 Reference Point
 393.52
 (top of 2" PVC cap)

5/31/2016
 Top of Ground 392.42

- 1 GROUT SEAL VOLCLAY
- 2 BENTONITE SEAL
- 3 SCREEN 9.0 FEET
- 4 GRAVEL PACK
- 5 N.A.
- 6 RISER PIPE 2.0 INCH

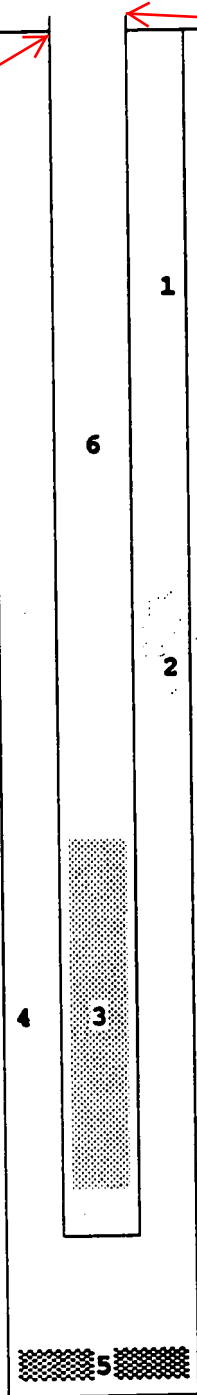

TOP OF BENTONITE SEAL 341.8

TOP OF GRAVEL PACK 336.8

TOP OF SCREEN 336.1

BOTTOM OF SCREEN 327.1

BOTTOM OF GRAVEL PACK 326.1

BOTTOM OF BORE HOLE 326.1

GEOTECHNICAL ENGINEERING SECTION
 CIVIL ENGINEERING DESIGN

AMERICAN ELECTRIC POWER SERVICE CORPORATION

OBSERVATION
 WELL

CDS-04

AEP CIVIL ENGINEERING LABORATORY
LOG OF BORING



JOB NUMBER _____
 COMPANY **INDIANA MICHIGAN POWER COMPANY**
 PROJECT **ROCKPORT PLANT**
 COORDINATES **N 162,921.3 E 517,496.0**
 GROUND ELEVATION **391.8** SYSTEM _____

BORING NO. **9244** DATE _____ SHEET **1** OF **2**
 BORING START **10/07/92** BORING FINISH **10/08/92**
 PIEZOMETER TYPE _____ WELL TYPE **SS**
 HGT. RISER ABOVE GROUND _____ DIA **2.0**
 DEPTH TO TOP OF WELL SCREEN _____ BOTTOM _____
 WELL DEVELOPMENT _____ BACKFILL **VOLCLAY**
 FIELD PARTY **MCR-CGF** RIG **BK-81**

WATER LEVEL	▽ 24.8	▽	▽
TIME			
DATE	10-7-92		

SAMPLE NUMBER	SAMPLE	SAMPLE DEPTH IN FEET		STANDARD PENETRATION RESISTANCE BLOWS / 6"	TOTAL LENGTH RECOVERY	RQD %	DEPTH IN FEET	GRAPH LOG	U S C S	SOIL / ROCK IDENTIFICATION	WELL	DRILLER'S NOTES
		FROM	TO									
1	SS	0.0	1.5	2-4-5	1.1					BROWN AND GRAY CLAYEY SILT moist TRACE OF SAND, BLACK ORGANIC MATERIAL.		<div style="border: 1px solid red; padding: 2px;">WELL NO. 8-I</div> Second hole was drilled to install well. 5.0 to 7.0 push 2.0, recovery 1.65, time 5, psi 500 7.0 to 9.0 2.0, recovery, push 2.0, time 5, psi 400. 10.0 to 12.0 push 2.0, recovery 2.0, time 5, psi 250. 36.0 started washing out hole with mud to keep plug out.
2	SS	1.5	3.0	2-3-6	1.5							
3	SS	3.0	5.0	2-4-6-5	1.8							
4	ST	5.0	7.0		1.65		5			LIGHT BROWN CLAYEY SILT with trace of fine grain sand.		
5	ST	7.0	9.0		2.0					BROWN SILTY CLAY		
6	SS	9.0	10.0	2-2	1.0		10			BROWNISH RED SILTY CLAY		
7	ST	10.0	12.0		2.0					BROWN SAND poorly graded fine to medium grain, dry.		
8	SS	12.0	13.5	10-12-15	1.5							
9	SS	13.5	15.0	10-15-23	1.4							
10	SS	15.0	16.5	12-16-25	1.4					BROWN SAND well graded, moist, quartz.		
11	SS	16.5	18.0	15-17-18	1.0							
12	SS	18.0	19.5	10-12-15	1.2		20			BROWN GRAVELLY SAND MOIST , 1" MAXIMUM SIZE, QUARTZ.		
13	SS	19.5	21.0	15-17-21	1.0							
14	SS	21.0	22.5	15-19-28	1.2							
15	SS	22.5	24.0	12-20-24	1.5							
16	SS	24.0	25.5	9-16-19	1.2		25			BROWN SAND MOIST , WELL GRADED, QUARTZ. SATURATED		
17	SS	25.5	27.0	7-9-9	1.5							
18	SS	27.0	28.5	4-6-11	1.4							
19	SS	28.5	30.0	5-7-9	1.2		30			BROWN SAND AND GRAVEL saturated, quartz, 1/2 maximum.		
20	SS	30.0	31.5	4-5-6	1.2							
21	SS	31.5	33.0	3-4-4	1.5							
22	SS	33.0	34.5	4-5-5	1.1							
23	SS	34.5	36.0	7-10-13	1.5		35					
24	SS	36.0	37.5	8-12-16	.8							
25	SS	37.5	39.0	5-13-17	1.2							
26	SS	39.0	40.5	4-8-17	1.0		40			BROWN SAND medium to fine grain, saturated, quartz.		
27	SS	41.9	43.4	5-9-10	1.2							
28	SS	44.4	45.9	12-16-19	1.5		45					
29	SS	46.9	48.4	5-14-16	1.4							

TYPE OF CASING USED			<i>Continued Next Page</i>	
	NQ-2 ROCK CORE		PIEZOMETER TYPE: PT = OPEN TUBE POROUS TIP, SS = OPEN TUBE SLOTTED SCREEN, G = GEONOR, P = PNEUMATIC	
X	6" x 3.25 HSA		WELL TYPE: OW = OPEN TUBE, GM = GEOMON	
X	9" x 6.25 HSA		RECORDER: _____	
	HW CASING ADVANCER 4"			
	NW CASING 3"			
	SW CASING 6"			

AMERICAN ELECTRIC POWER SERVICE CORPORATION
AEP CIVIL ENGINEERING LABORATORY
 LOG OF BORING



JOB NUMBER _____

COMPANY **INDIANA MICHIGAN POWER COMPANY**

BORING NO. **9244**

DATE _____

SHEET **2** OF **2**

PROJECT **ROCKPORT PLANT**

BORING START **10/07/92**

BORING FINISH **10/08/92**

SAMPLE NUMBER	SAMPLE	SAMPLE DEPTH IN FEET		STANDARD PENETRATION RESISTANCE BLOWS / 6"	LOG RECOVERY %	RQD %	DEPTH IN FEET	GRAPH LOG	U S C S	SOIL / ROCK IDENTIFICATION	WELL	DRILLER'S NOTES
		FROM	TO									
30	SS	49.4	50.9	8-12-15	1.5							50.0 top of bentonite seal.
31	SS	50.9	52.4	10-16-17	1.0							
32	SS	52.4	53.9	7-8-10	1.3							
33	SS	53.9	55.4	10-12-13	1.3							
34	SS	55.4	56.9	11-17-18	1.5		55			GRAY SAND fine to course grain, saturated, quartz.		55.0 top of gravel pack. 55.5 to 56.9 spacer. 55.7 top of screen.
35	SS	56.9	58.4	9-12-16	1.5					GRAY SAND fine grain, saturated, quartz.		
36	SS	58.4	59.9	5-10-23	1.5					1" LAYER OF LIGNITE		
37	SS	61.9	63.4	8-10-14	1.1		60			GRAY SAND well graded, saturated, quartz.		64.0 to 65.4 spacer. 64.7 bottom of screen. 65.7 Bottom of gravel pack. Hole drilled with 6.25 augers with stainless steel plate remaining in bottom of hole and using new premade bentonite donuts.
38	SS	64.4	65.9	9-10-12	1.2		65					
39	SS	66.9	68.4	2-3-7-	1.5					GRAY SAND fine to medium grain, saturated, quartz.		
40	SS	69.4	69.8	50/4	-					GRAY CLAY SHALE		


I & M
Rockport Plant
Ash Storage Area
Well No. 9-S
5-23-84

MW-9S

5/31/2016
Reference Point
404.35
(top of inner sleeve)

5/31/2016
Top of Ground 402.92

2" PVC Pipe
Installed well 10 ft. into silty sand

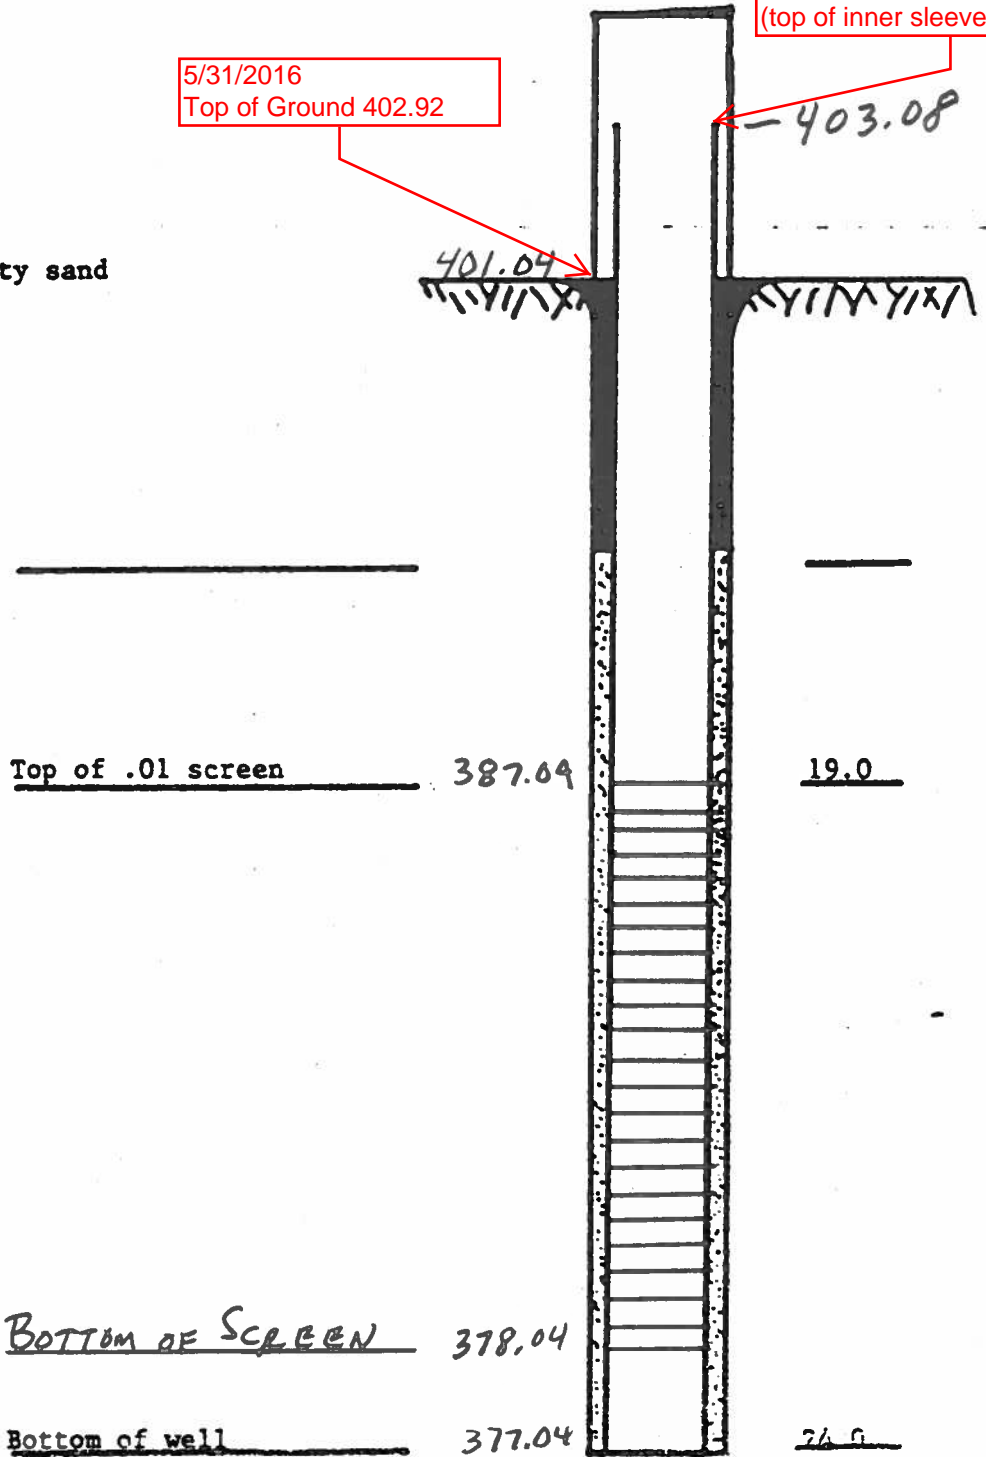



JOB NUMBER _____
 COMPANY INDIANA MICHIGAN POWER COMPANY
 PROJECT ROCKPORT PLANT
 COORDINATES N 165,472.1 E 521,801.1
 GROUND ELEVATION 401.6 SYSTEM _____

MW-9

BORING NO. 9909 DATE 4/27/99 SHEET 1 OF 1
 BORING START 2/11/99 BORING FINISH 2/11/99
 PIEZOMETER TYPE _____ WELL TYPE OW
 HGT. RISER ABOVE GROUND _____ DIA _____
 DEPTH TO TOP OF WELL SCREEN _____ BOTTOM _____
 WELL DEVELOPMENT _____ BACKFILL Grout
 FIELD PARTY MCR-DLB RIG BK-81

WATER LEVEL	∇	∇	∇
TIME			
DATE			

SAMPLE NUMBER	SAMPLE	SAMPLE DEPTH IN FEET		STANDARD PENETRATION RESISTANCE BLOWS / 6"	TOTAL LENGTH RECOVERY	RQD %	DEPTH IN FEET	GRAPHIC LOG	USCS	SOIL / ROCK IDENTIFICATION	WELL	DRILLER'S NOTES
		FROM	TO									
1	SS	0.0	2.0	1-1-2-2	2.0				CL	BROWN FINE GRAIN SANDY CLAY Dry		Water for drilling and grouting came from fire protection well at Rockport Plant. Grouted from 44.9' to grade; used approx. 40 gallons (1.5 bags). No quick gel used when soil sampling.
2	SS	2.0	4.0	2-2-2-3	2.0				CL	TAN to LIGHT BROWN SILTY CLAY With trace of fine grain sand, dry.		
3	SS	4.0	6.0	2-2-2-4	2.0		5					
4	SS	6.0	8.0	2-3-4-5	2.0							
5	SS	8.0	10.0	3-3-4-5	1.8				SP	REDDISH BROWN FINE GRAIN SILTY SAND		
6	SS	10.0	12.0	1-1-1-2	1.7		10		SP	Moist.		
7	SS	12.0	14.0	2-2-3-4	2.0				SP	BROWN FINE GRAIN SAND Wet.		
8	SS	14.0	16.0	2-2-2-3	2.0		15			DARK BROWN to LIGHT BROWN FINE GRAIN SAND		
9	SS	16.0	18.0	1-1-4-5	2.0				SP	Moist.		
10	SS	18.0	20.0	5-16-7-6	2.0				SW	LIGHT BROWN FINE to MEDIUM GRAIN SAND		
11	SS	20.0	22.0	3-3-5-8	2.0		20			Wet.		
12	SS	22.0	24.0	3-4-5-8	2.0					LIGHT BROWN to DARK BROWN WELL GRADED MEDIUM GRAIN SAND		
13	SS	24.0	26.0	5-8-13-37	2.0		25			Moist.		
									SP	POORLY GRADED SAND With pea to 1/2" gravels, moist.		
14	NQ-2	29.0	29.9		0		30			NO RECOVERY		Auger refusal at 29.0' Pulled tools. Inner tube not latching. Took this core from inside of core barrel. All return drill water showed gray clay shale. Stopped boring at 44.9' on 2/11/99
15	NQ-2	29.9	34.9		3.0					BLUISH GRAY SHALE		
16	NQ-2	34.9	39.9				35			GRAY FINE GRAIN SANDY CLAY SHALE		
17	NQ-2	39.9	44.9				40					


TYPE OF CASING USED

X	NQ-2 ROCK CORE
X	6" x 3.25 HSA
	9" x 6.25 HSA
	HW CASING ADVANCER 4"
	NW CASING 3"
	SW CASING 6"
	AIR HAMMER 8"

PIEZOMETER TYPE: PT = OPEN TUBE POROUS TIP, SS = OPEN TUBE SLOTTED SCREEN, G = GEONOR, P = PNEUMATIC

WELL TYPE: OW = OPEN TUBE SLOTTED SCREEN, GM = GEOMON

RECORDER DLB

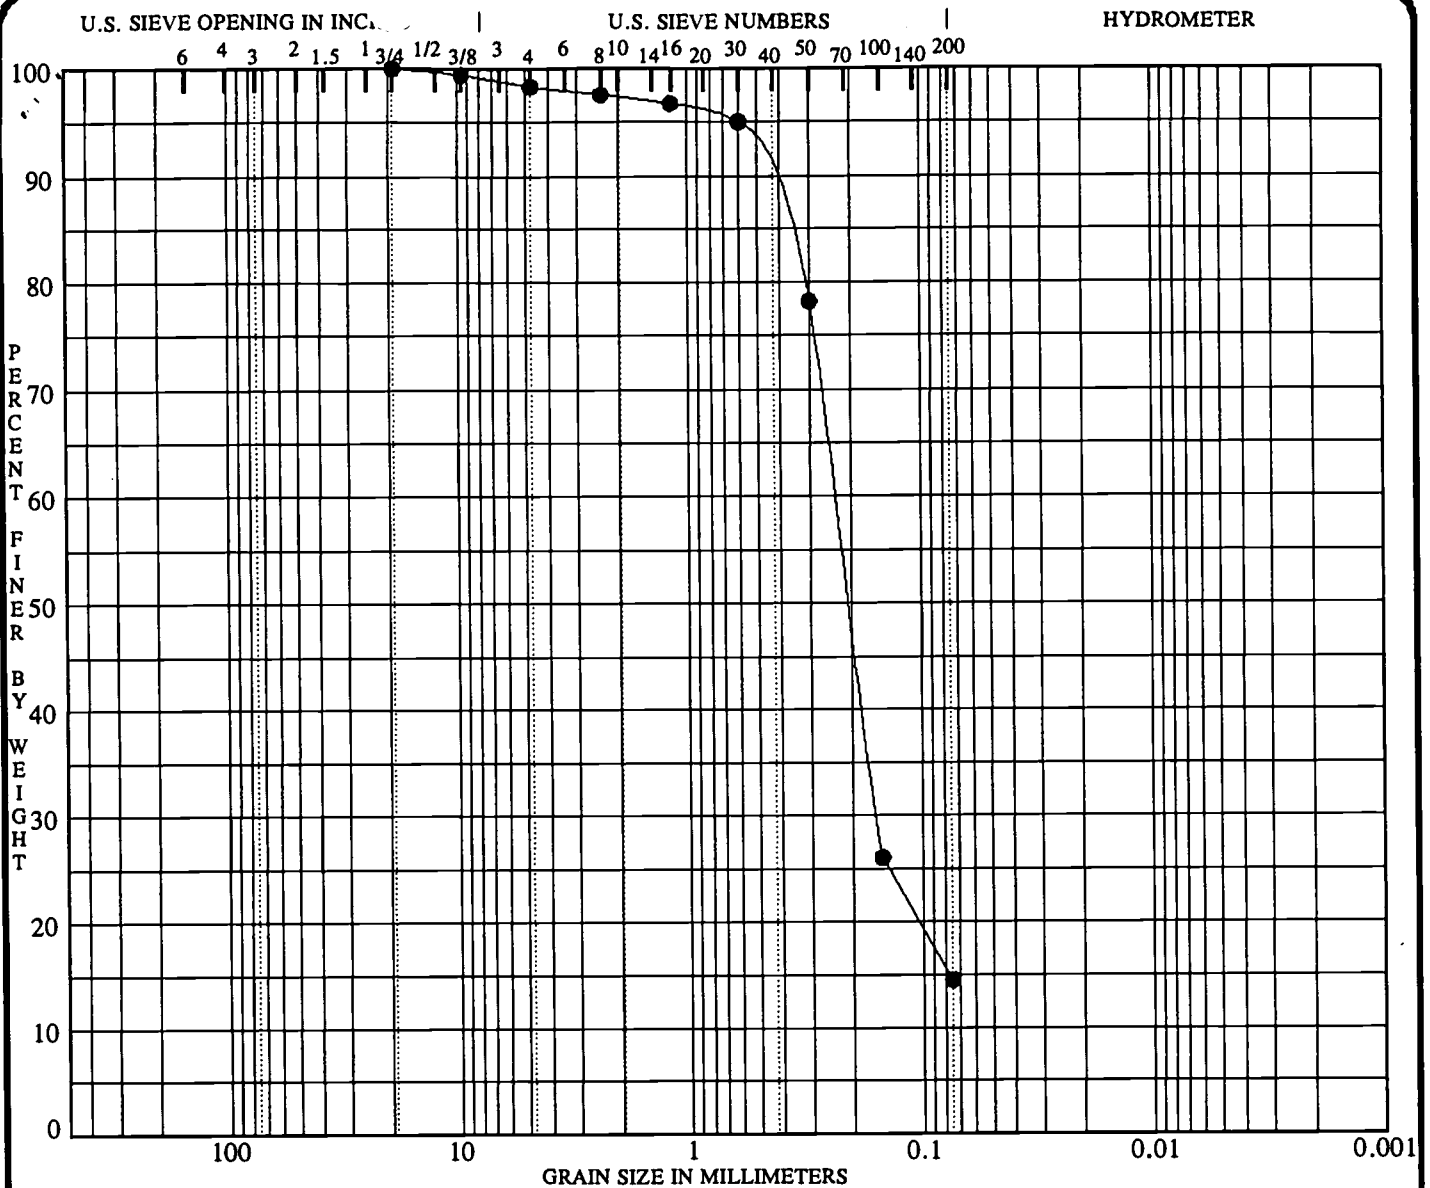

COBBLES	GRAVEL		SAND			SILT OR CLAY
	coarse	fine	coarse	medium	fine	

Specimen Identification	Classification	MC%	LL	PL	PI	Sp.Gr.
● 9909 16.0			NP	NP	NP	
	SILTY SAND SM					
	COMPOSITE SAMPLE 16.0'-26.0'					

Specimen Identification	D100	D60	D30	D10	%Gravel	%Sand	%Fines	% < .002
● 9909 16.0	19.000	0.236	0.158		1.7	83.8	14.5	

PROJECT ROCKPORT PLANT - ROCKPORT, INDIANA JOB NO. WO#1352
 DATE 04/22/99

GRADATION CURVES
 American Electric Power Service Corp.
 Groveport, Ohio




I & M
Rockport Plant
Ash Storage Area
Well No. 10-S
5-23-84

MW-10S

5/31/2016
Reference Point
409.16
(top of inner slope
indicator sleeve)

5/31/2016
Top of Ground 407.80

2" PVC Pipe
Installed well 10 ft. in silty sand

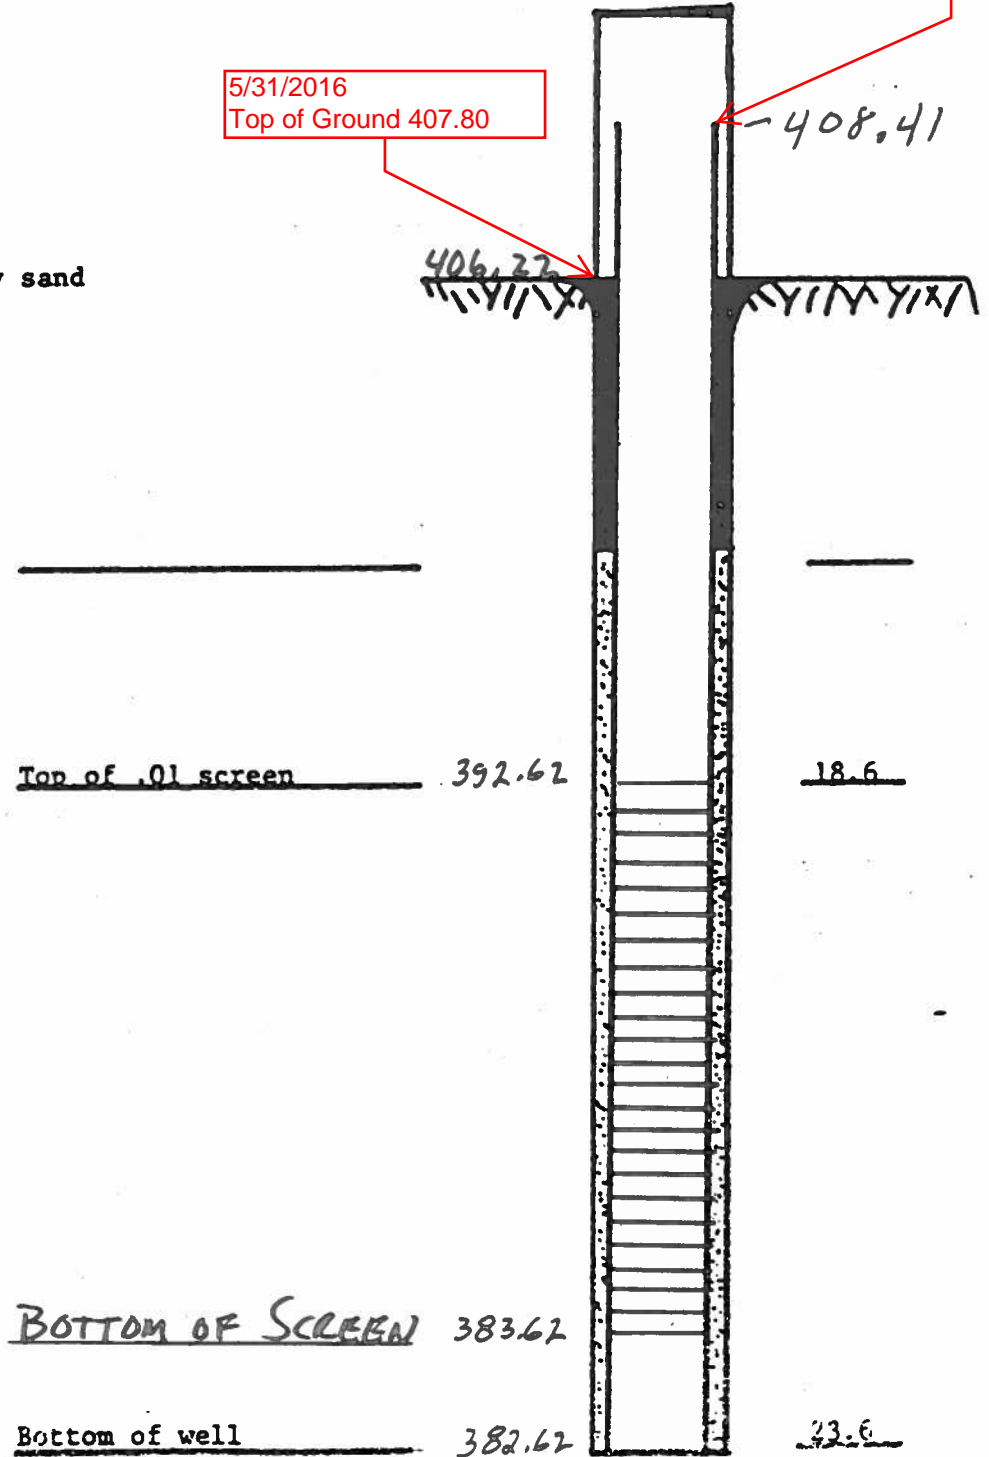

AME. AN ELECTRIC POWER SERVICE CORPORATION
AEP CIVIL ENGINEERING LABORATORY
 LOG OF BORING



JOB NUMBER _____
 COMPANY **INDIANA MICHIGAN POWER COMPANY**
 PROJECT **ROCKPORT PLANT**
 COORDINATES **N 166,560.6 E 520,751.6**
 GROUND ELEVATION **406.4** SYSTEM _____

MW-10
 BORING NO. **9910** DATE **4/27/99** SHEET **1** OF **2**
 BORING START **2/11/99** BORING FINISH **2/11/99**
 PIEZOMETER TYPE _____ WELL TYPE **OW**
 HGT. RISER ABOVE GROUND _____ DIA _____
 DEPTH TO TOP OF WELL SCREEN _____ BOTTOM _____
 WELL DEVELOPMENT _____ BACKFILL **Grout**
 FIELD PARTY **MCR-DLB** RIG **BK-81**

WATER LEVEL	▽	▽	▽
TIME			
DATE			

SAMPLE NUMBER	SAMPLE	SAMPLE DEPTH IN FEET		STANDARD PENETRATION RESISTANCE BLOWS / 6"	TOTAL LENGTH RECOVERY	RQD %	DEPTH IN FEET	GRAPHIC LOG	USCS	SOIL / ROCK IDENTIFICATION	WELL	DRILLER'S NOTES
		FROM	TO									
1	SS	0.0	2.0	1-1-1-1	2.0				CL	BROWN CLAY With organic		Water for drilling and grouting came from fire protection well at Rockport Plant. Grouted from 40.0' to grade using approx. 40 gallons of grout - 1.5 bags. No quick gel used when soil sampling.
2	SS	2.0	4.0	1-1-1-2	2.0			CL	BROWN SILTY CLAY Moist			
3	SS	4.0	6.0	2-2-3-4	2.0			CL	LIGHT BROWN SILTY CLAY Moist			
4	SS	6.0	8.0	3-4-4-6	2.0		5	CL	BROWN CLAY Stiff; moist.			
5	SS	8.0	10.0	1-2-2-3	2.0			CL	BROWNISH GRAY CLAY Stiff			
6	SS	10.0	12.0	2-2-3-4	2.0		10	CL	BROWN CLAY Moist			
7	SS	12.0	14.0	2-1-2-4	2.0			CL	SILTY CLAY Wet			
8	SS	14.0	16.0	1-1-2-2	2.0			CL	BROWN SILTY CLAY Moist			
9	SS	16.0	18.0	2-4-4-7	2.0		15	SW	WELL GRADED SAND Medium grained; wet.			
10	SS	18.0	20.0	2-3-7-9	2.0			CL	BROWN CLAY Stiff, dry.			
11	SS	20.0	22.0	9-12-15-18	2.0		20	CL	BROWN SILTY CLAY Moist			
12	SS	22.0	24.0	6-8-10-14	2.0			CL	GRAY CLAY Stiff, dry.			
13	SS	24.0	24.7	28-50/2	0.7			CL	BROWN CLAY LIGHT BROWN CLAY Stiff, moist.			
										LIGHT BROWN SHALE		

TYPE OF CASING USED

Continued Next Page

	NO-2 ROCK CORE
X	6" x 3.25 HSA
	9" x 6.25 HSA
	HW CASING ADVANCER 4"
	NW CASING 3"
	SW CASING 6"
	AIR HAMMER 8"

PIEZOMETER TYPE: PT = OPEN TUBE POROUS TIP, SS = OPEN TUBE SLOTTED SCREEN, G = GEONOR, P = PNEUMATIC
 WELL TYPE: OW = OPEN TUBE SLOTTED SCREEN, GM = GEOMON

RECORDER **DLB**

AEP RKPT.GPJ AEP FULL.GDT 4/27/99

AME AN ELECTRIC POWER SERVICE COF RATION
AEP CIVIL ENGINEERING LABORATORY
 LOG OF BORING



JOB NUMBER _____


COMPANY **INDIANA MICHIGAN POWER COMPANY**


BORING NO. **9910** DATE **4/27/99** SHEET **2** OF **2**

PROJECT **ROCKPORT PLANT**

BORING START **2/11/99** BORING FINISH **2/11/99**

SAMPLE NUMBER	SAMPLE	SAMPLE DEPTH IN FEET		STANDARD PENETRATION RESISTANCE BLOWS / 6"	TOTAL LENGTH RECOVERY	RQD	DEPTH IN FEET	GRAPHIC LOG	USCS	SOIL / ROCK IDENTIFICATION	WELL	DRILLER'S NOTES
		FROM	TO			%						
14	NQ-2	24.7	28.8		0.5					BROWN SHALE		Looking at core showed fine grain sand from overburden Inbedded in core which was not letting core slide into inner tube and causing it to be washed away.
15	NQ-2	28.8	33.0		5.2		30			GRAY FINE GRAIN SANDY CLAY SHALE Medium hard, somewhat cemented.		
16	NQ-2	33.0	40.0		7.0		35					
							40					Stopped boring at 40.0' on 2/11/99

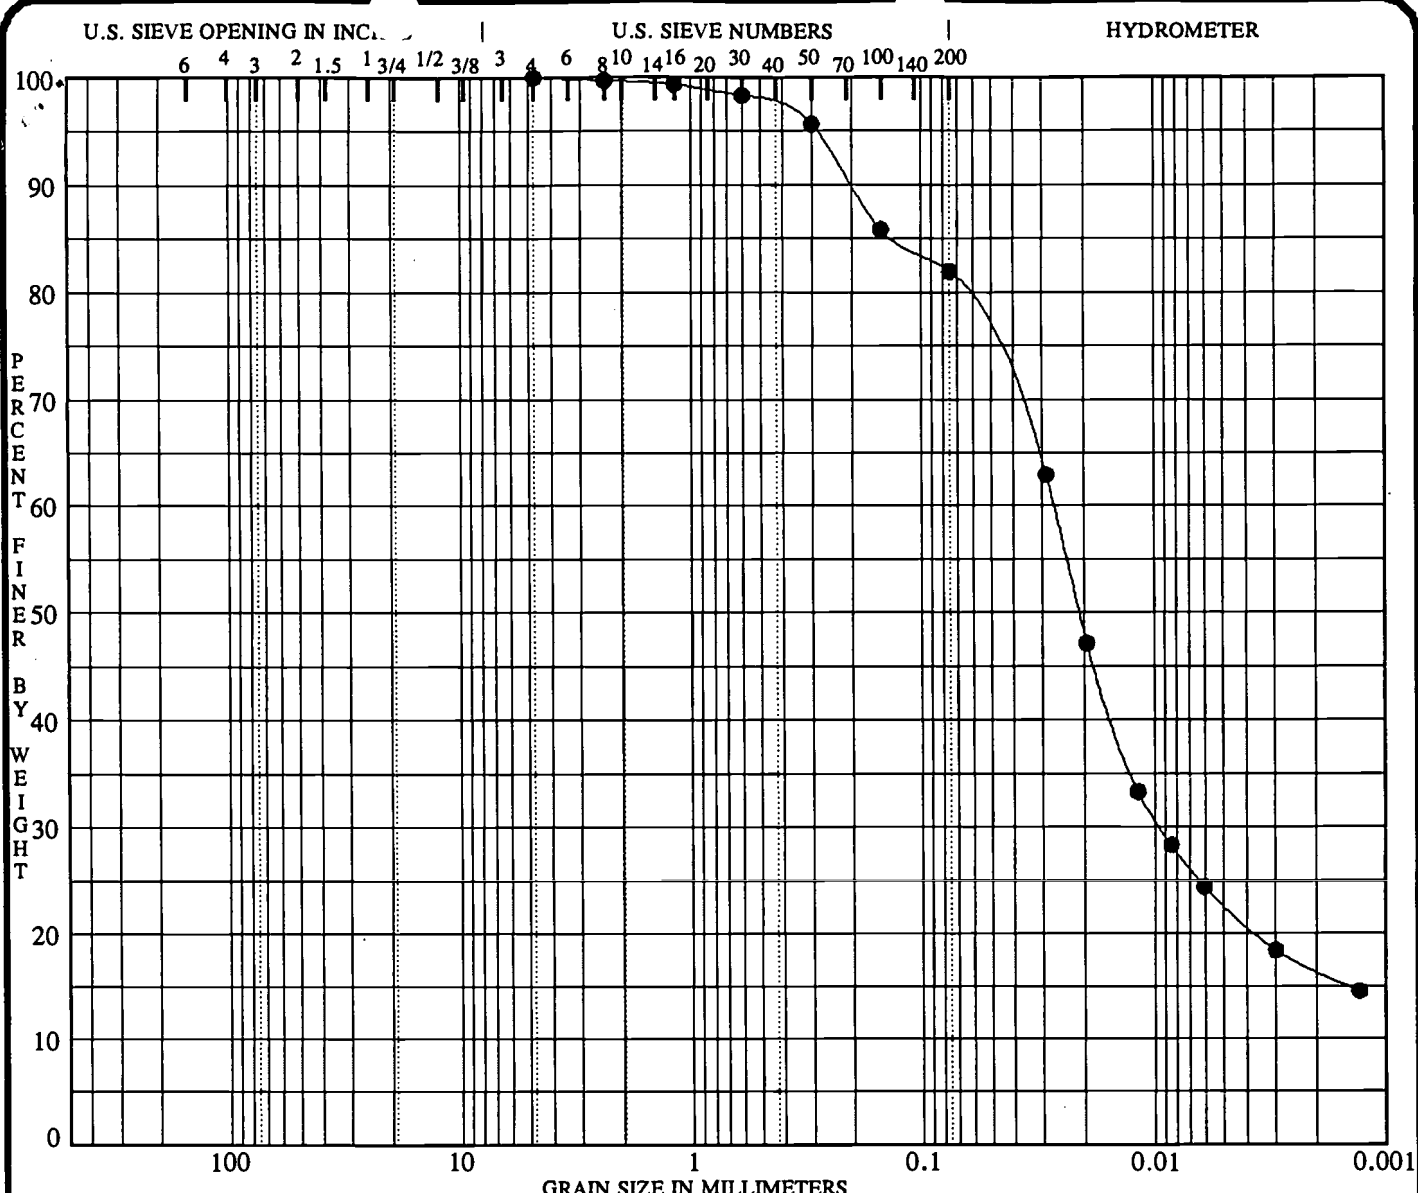

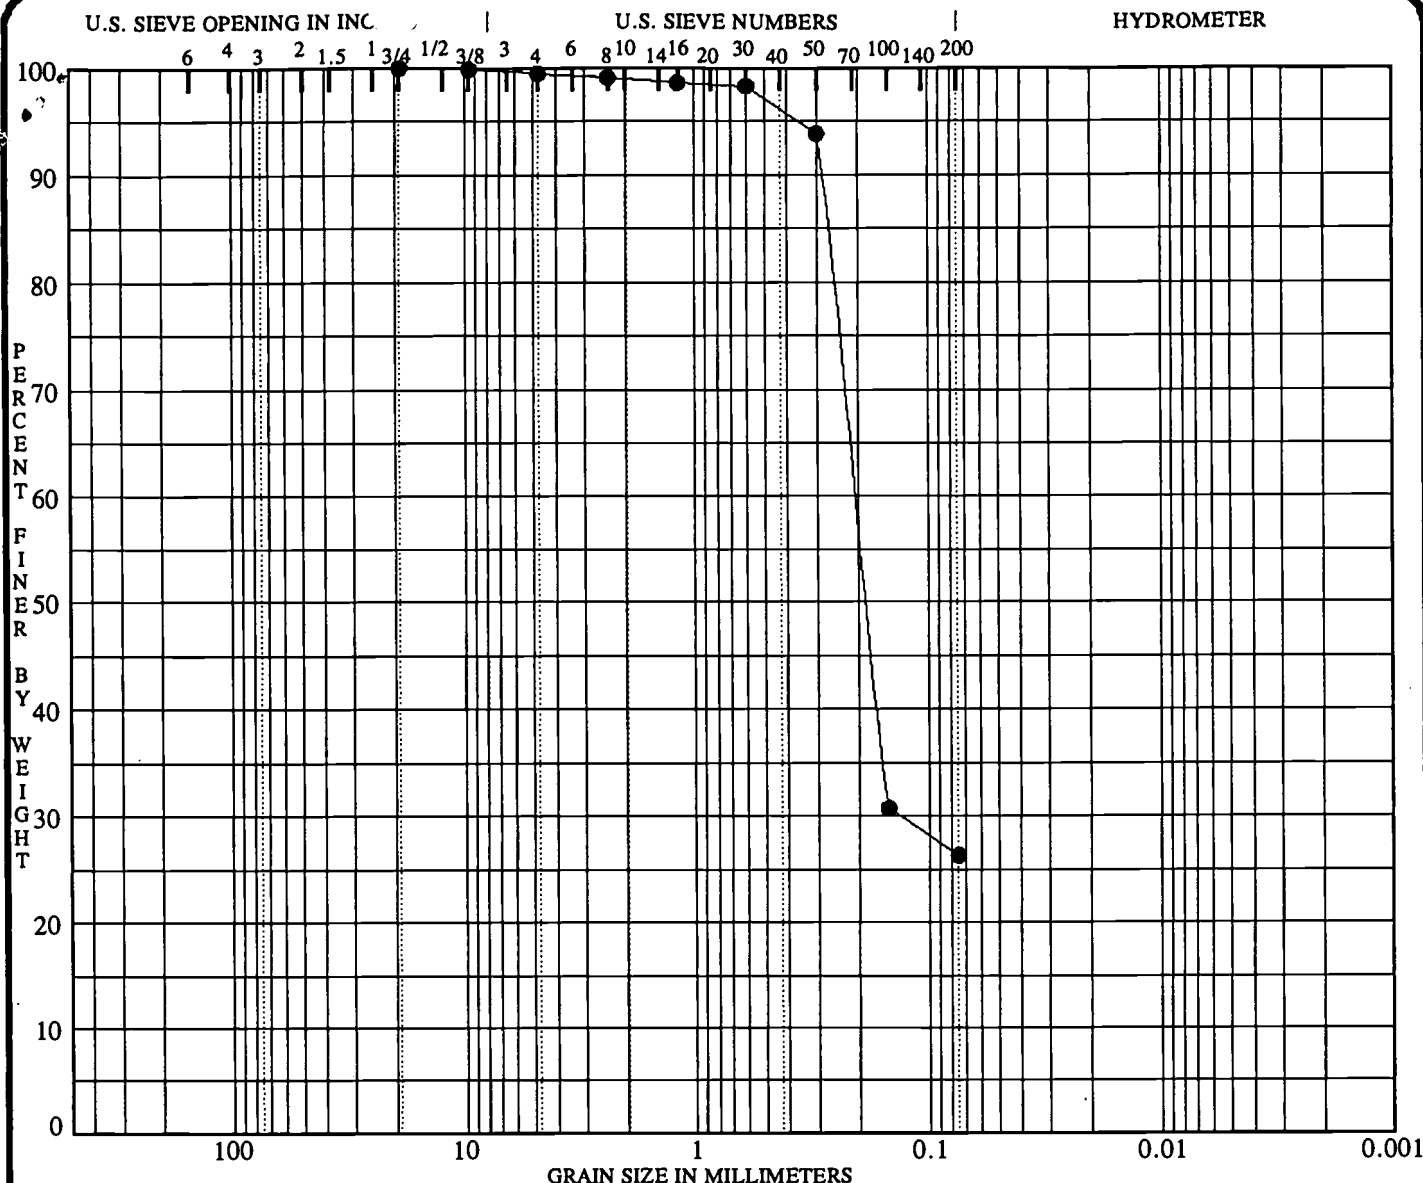

COBBLES	GRAVEL		SAND			SILT OR CLAY
	coarse	fine	coarse	medium	fine	

Specimen Identification	Classification	MC%	LL	PL	PI	Sp.Gr.
● 9910 14.0			NP	NP	NP	
	SILTY SAND SM					
	COMPOSITE SAMPLE 14.0'-20.0'					

Specimen Identification	D100	D60	D30	D10	%Gravel	%Sand	%Fines	% < .002
● 9910 14.0	19.000	0.207	0.134		0.5	73.2	26.3	

PROJECT ROCKPORT PLANT - ROCKPORT, INDIANA JOB NO. WO#1352
 DATE _____ DATE 04/22/99

GRADATION CURVES
 American Electric Power Service Corp.
 Groveport, Ohio



COMPANY INDIAN AND MICHIGAN POWER CO.
 PROJECT ROCKPORT ASH LANDFILL
 COORDINATES N.164421.03 E.523964.21
 DATE INSTALLED 11-16-92

**WELL CONSTRUCTION
 SUMMARY ELEVATION
 (ft. NGVD)**

WELL NO. 11-S
 REF. DATUM PT. 399.97
 GRADE 397.60


MW-11S

NOTE: CASING PROTECTOR DETAILS
 NOT SHOWN

5/31/2016
 Reference Point
 400.07
 (top of 2" PVC pipe)

5/31/2016
 Top of Ground 398.22

- 1 GROUT SEAL VOLCLAY
- 2 BENTONITE SEAL
- 3 SCREEN 9.0 FEET
- 4 GRAVEL PACK
- 5 N.A.
- 6 RISER PIPE 2.0 INCH

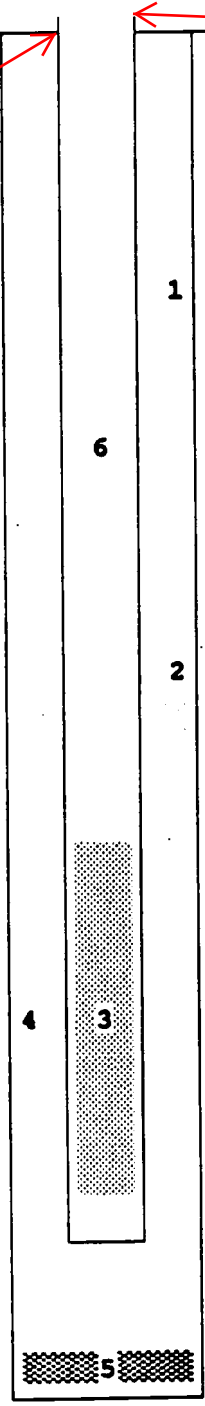

TOP OF BENTONITE SEAL 375.4

TOP OF GRAVEL PACK 370.4

TOP OF SCREEN 368.0

BOTTOM OF SCREEN 359.0

BOTTOM OF GRAVEL PACK 358.0

BOTTOM OF BORE HOLE 358.0

GEOTECHNICAL ENGINEERING SECTION
 CIVIL ENGINEERING DESIGN

OBSERVATION
 WELL

AMERICAN ELECTRIC POWER SERVICE CORPORATION

CDS-04

AEP CIVIL ENGINEERING LABORATORY
LOG OF BORING



JOB NUMBER _____
 COMPANY INDIANA MICHIGAN POWER COMPANY
 PROJECT ROCKPORT PLANT
 COORDINATES N 164,421.0 E 523,964.2
 GROUND ELEVATION 397.6 SYSTEM _____

BORING NO. 9230 DATE _____ SHEET 1 OF 2
 BORING START 09/25/92 BORING FINISH 09/27/92
 PIEZOMETER TYPE _____ WELL TYPE SS
 HGT. RISER ABOVE GROUND _____ DIA 2"
 DEPTH TO TOP OF WELL SCREEN _____ BOTTOM _____
 WELL DEVELOPMENT _____ BACKFILL VOLCLAY
 FIELD PARTY ROUSH/FOLGER RIG BK-81

WATER LEVEL	▽ 34.4	▽	▽
TIME			
DATE	9-27-92		

SAMPLE NUMBER	SAMPLE	SAMPLE DEPTH IN FEET		STANDARD PENETRATION RESISTANCE BLOWS / 6"	TOTAL LENGTH RECOVERY	RQD %	DEPTH IN FEET	GRAPH LOG	U S C S	SOIL / ROCK IDENTIFICATION	WELL	DRILLER'S NOTES
		FROM	TO									
1	SPT	1.9	3.4	9-17-19	1.5					<u>BROWN CLAYEY SILT</u> , dry	WELL 11-S Hole drilled with 6.25 augers using stainless plates remaining in borings. New premade bentonite type donuts. Water induced in hole to make seal. 27.4 to 28.8 spacer. 37.9 to 39.3 spacer. Second hole drilled to install well. 22.2 top of bentonite seal. 27.2 top of gravel pack. 29.6 top of screen. Hit water. 38.6 bottom of screen. Began using drill mud. 39.6 bottom of gravel pack.	
2	SPT	4.4	5.9	8-9-11	1.5		5			<u>BROWN CLAYEY SAND</u> , very fine grain, dry, moist		
3	SPT	6.9	8.4		1.3							
4	SPT	9.4	10.9	6-7-7	1.0		10			<u>BROWN SAND</u> , fine to medium grain, moist.		
5	SPT	11.9	13.4	4-6-6	1.5							
6	SPT	14.4	15.9	5-7-7	1.1		15					
7	SPT	16.9	18.4	7-8-28	1.4					<u>SAND w/PEA GRAVEL</u> , medium to coarse grain, some 1/4" to 1/2" gravel.		
8	SPT	19.4	20.9	8-12-19	1.0		20					
9	SPT	21.9	23.4	7-14-27	1.5							
10	SPT	24.4	25.9	12-20-25	1.1		25					
11	SPT	26.9	28.4	9-10-14	1.2							
12	SPT	29.4	30.9	8-14-21	1.4		30					
13	SPT	31.9	33.4	5-8-14	1.0					<u>BROWN SAND w/PEA GRAVEL</u> , fine to medium grain.		
14	SPT	34.4	35.9	7-9-16	1.2		35			<u>GRAY SAND w/PEA GRAVEL</u> , medium to coarse grain, wet.		
15	SPT	36.9	38.4	8-10-12	.9					<u>BROWN SAND</u> , fine to medium grain with some pea gravel and 1/4" gravel.		
16	SPT	39.4	40.9	4-6-7	.9		40					
17	SPT	41.9	43.4	5-7-9	1.3							
18	SPT	44.4	45.9	7-8-12	1.1		45					
19	SPT	46.9	46.9	50/0	0					<u>BROWN SAND</u> , medium grain with 1" lens black organic.		

TYPE OF CASING USED		<i>Continued Next Page</i>	
X	NQ-2 ROCK CORE	PIEZOMETER TYPE: PT = OPEN TUBE POROUS TIP, SS = OPEN TUBE SLOTTED SCREEN, G = GEONOR, P = PNEUMATIC	
X	6" x 3.25 HSA	WELL TYPE: OW = OPEN TUBE, GM = GEOMON	
	9" x 6.25 HSA	RECORDER _____	
	HW CASING ADVANCER 4"		
	NW CASING 3"		
	SW CASING 6"		

AMERICAN ELECTRIC POWER SERVICE CORPORATION
AEP CIVIL ENGINEERING LABORATORY
 LOG OF BORING



JOB NUMBER _____

COMPANY **INDIANA MICHIGAN POWER COMPANY**

BORING NO. **9230** DATE _____ SHEET **2** OF **2**

PROJECT **ROCKPORT PLANT**

BORING START **09/25/92** BORING FINISH **09/27/92**

SAMPLE NUMBER	SAMPLE	SAMPLE DEPTH IN FEET		STANDARD PENETRATION RESISTANCE BLOWS / 6"	TOTAL LENGTH RECOVERY	RQD	DEPTH IN FEET	GRAPH LOG	U S C S	SOIL / ROCK IDENTIFICATION	WELL	DRILLER'S NOTES
		FROM	TO			%						
												Grouted hole with Vol-clay grout. 49.3 auger refusal. broken piece of limestone in auger.

COMPANY INDIAN AND MICHIGAN POWER CO.
 PROJECT ROCKPORT ASH LANDFILL
 COORDINATES N.160223.99 E.523968.99
 DATE INSTALLED 11-15-92

WELL CONSTRUCTION
 SUMMARY ELEVATION
 (ft. NGVD)
 WELL NO. 12-S
 REF. DATUM PT. 403.45
 GRADE 401.57


MW-12S

NOTE: CASING PROTECTOR DETAILS
 NOT SHOWN

5/31/2016
 Reference Point
 403.58
 (top of 2" PVC pipe)

5/31/2016
 Top of Ground 402.35

- 1 GROUT SEAL VOLCLAY
- 2 BENTONITE SEAL
- 3 SCREEN 9.0 FEET
- 4 GRAVEL PACK
- 5 N.A.
- 6 RISER PIPE 2.0 INCH

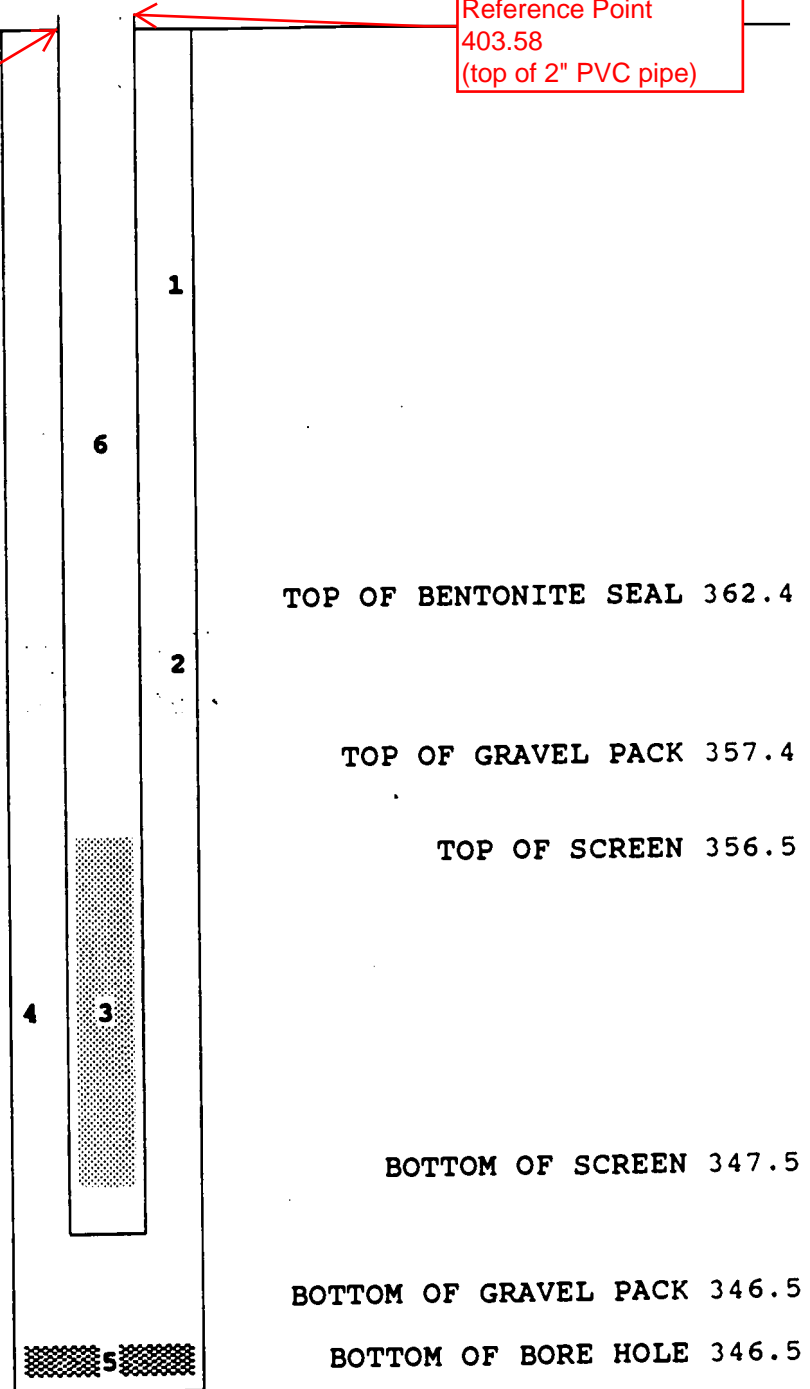

GEOTECHNICAL ENGINEERING SECTION
 CIVIL ENGINEERING DESIGN

OBSERVATION
 WELL

AMERICAN ELECTRIC POWER SERVICE CORPORATION

CDS-04

AEP CIVIL ENGINEERING LABORATORY
LOG OF BORING



JOB NUMBER _____
 COMPANY **INDIANA MICHIGAN POWER COMPANY**
 PROJECT **ROCKPORT PLANT**
 COORDINATES **N 160,224.0 E 523,969.0**
 GROUND ELEVATION **401.6** SYSTEM _____

BORING NO. **9231** DATE _____ SHEET **1** OF **3**
 BORING START **10/28/92** BORING FINISH **11/03/92**
 PIEZOMETER TYPE _____ WELL TYPE **SS**
 HGT. RISER ABOVE GROUND _____ DIA **2"**
 DEPTH TO TOP OF WELL SCREEN _____ BOTTOM _____
 WELL DEVELOPMENT _____ BACKFILL **VOLCLAY**
 FIELD PARTY **MCR-GCF** RIG **BK-81**

WATER LEVEL	▽	39.0	▽	▽
TIME				
DATE		10-28-92		

SAMPLE NUMBER	SAMPLE	SAMPLE DEPTH IN FEET		STANDARD PENETRATION RESISTANCE BLOWS / 6"	TOTAL PENETRATION ALLOWED	RQD %	DEPTH IN FEET	GRAPH LOG	USCS	SOIL / ROCK IDENTIFICATION	WELL	DRILLER'S NOTES
		FROM	TO									
1	SS	1.8	3.3	3-6-6	1.2					BROWN SILT trace of v-fine sand.		Well NO. 12-S Second hole was drilled to install well. 39.1 Top of bentonite seal. 41.8 STARTED USE DRILL MUD TO WASH OUT PLUG. 44.1 Top of gravel pack. 45.0 Top of screen.
2	SS	4.3	5.8	3-5-7	1.4		5			BROWN SAND v-fine grain.		
3	SS	6.8	8.3	10-11-13	1.5					BROWN SAND medium grain.		
4	SS	9.3	10.8	1-2-1	1.5		10			GRAY CLAY moist, trace of very fine sand. BROWN SILTY CLAY moist.		
5	SS	11.8	13.3	1-2-3	1.5							
6	SS	14.3	15.8	1-1-2	1.5		15					
7	SS	16.8	18.3	1-1-2	1.5					16.8 moist to wet.		
8	SS	19.3	20.8	6-8-10	1.0		20			BROWN SAND fine grain, moist to wet.		
9	SS	21.8	23.3	10-12-14	.6					SAND fine to medium grain.		
10	SS	24.3	25.8	7-12-16	.9		25					
11	SS	26.8	28.3	6-6-11	1.3							
12	SS	29.3	30.8	7-10-11	1.2		30					
13	SS	31.8	33.3	9-10-14	1.0							
14	SS	34.3	35.8	9-8-12	1.0		35					
15	SS	36.8	38.3	8-14-16	1.0					BROWN GRAVELLY SAND moist to wet.		
16	SS	39.3	40.8	12-16-17	.9		40			39.3 saturated.		
17	SS	41.8	43.3	8-12-13	1.2							
18	SS	44.3	45.8	6-10-15	1.0		45					
19	SS	46.8	48.3	4-6-9	1.5					BROWN SAND fine grain.		

TYPE OF CASING USED			<i>Continued Next Page</i>	
X	NQ-2 ROCK CORE		PIEZOMETER TYPE: PT = OPEN TUBE POROUS TIP, SS = OPEN TUBE SLOTTED SCREEN, G = GEONOR, P = PNEUMATIC	
X	6" x 3.25 HSA		WELL TYPE: OW = OPEN TUBE, GM = GEOMON	
	9" x 6.25 HSA		RECORDER _____	
	HW CASING ADVANCER 4"			
	NW CASING 3"			
	SW CASING 6"			

AMERICAN ELECTRIC POWER SERVICE CORPORATION
 AEP CIVIL ENGINEERING LABORATORY
 LOG OF BORING



JOB NUMBER _____
 COMPANY INDIANA MICHIGAN POWER COMPANY
 PROJECT ROCKPORT PLANT

BORING NO. 9231 DATE _____ SHEET 2 OF 3
 BORING START 10/28/92 BORING FINISH 11/03/92

SAMPLE NUMBER	SAMPLE	SAMPLE DEPTH IN FEET		STANDARD PENETRATION RESISTANCE BLOWS / 6"	TOTAL LENGTH RECORDED	RQD %	DEPTH IN FEET	GRAPH LOG	U S C S	SOIL / ROCK IDENTIFICATION	WELL	DRILLER'S NOTES
		FROM	TO									
20	SS	49.3	50.8	5-10-11	1.5					1/4" black seam of organic material.		
21	SS	51.8	53.3	4-8-7	1.0					<u>BROWN/GRAY SAND</u> medium to course grain.		
22	SS	54.3	55.8	5-10-12	1.3		55			<u>BROWN/GRAY GRAVELLY SAND</u>		54.0 Bottom of screen.
23	SS	56.8	58.3	10-14-17	1.5					<u>BROWN SAND</u> fine grain		55.0 Bottom of gravel pack.
24	SS	59.3	60.8	8-12-15	.9		60			<u>GRAY GRAVELLY SAND</u>		Hole drilled with 6.25 augers and stainless plates remaining in hole. Bentonite seal premade bentonite donuts.
25	SS	61.8	63.3	10-12-14	1.2					<u>BROWN/GRAY SAND</u> medium grain		45.2-47.6 spacer.
26	SS	64.3	65.8	11-14-16	1.0		65			fine to medium grain		53.3-54.7 spacer.
27	SS	66.8	68.3	10-14-16	1.2					<u>GRAY SAND</u> medium to course grain.		
28	SS	69.3	70.8	8-12-14	1.5		70					
29	SS	71.8	73.3	4-6-7	1.3							
30	SS	74.3	75.8	10-10-15	1.2		75			<u>GRAY GRAVELLY SAND</u>		
31	SS	76.8	78.3	9-14-14	.9					<u>GRAY SAND</u> medium grain.		
32	SS	79.3	80.8	14-10-14	.9		80			<u>GRAY GRAVELLY SAND</u>		
33	SS	81.8	83.3	15-14-14	1.0					<u>BROWN SAND</u> medium to course grain.		
34	SS	84.3	85.8	25-12-10	.2		85					
35	SS	86.8	88.3	6-12-7	.9					<u>BROWN SAND AND GRAVEL</u>		
36	SS	89.3	90.8	21-20-24	1.4		90					
37	SS	91.8	93.3	19-25-26	1.3					<u>BROWN SAND</u> COURSE GRAIN,		
38	SS	94.3	95.8	14-11-13	1.2		95					95.0 started drilling through cobbles
39	SS	96.8	98.3	26-50-50/2	.9					<u>BROWN SAND</u> fine to medium grain.		
40	SS	99.3	100.8	8-10-13	7.		100			medium grain		
41	SS	101.8	103.3	10-10-16	1.5					medium grain with top 3" gray silt.		
42	SS	104.3	105.8	5-5-10	1.5		105			silt layer .1 at top of spoon.		
43	SS	106.8	108.3	6-9-9	1.0					<u>GRAY SAND</u> medium to fine grain.		
44	SS	109.3	110.8	3-3-5			110			<u>GRAY SAND</u> fine grain with .1 reddish brown silt.		
45	SS	111.8	113.3	8-11-12	1.5					<u>GRAY SAND</u> fine grain.		

Continued Next Page

AMERICAN ELECTRIC POWER SERVICE CORPORATION
AEP CIVIL ENGINEERING LABORATORY
 LOG OF BORING



JOB NUMBER _____

COMPANY **INDIANA MICHIGAN POWER COMPANY**

BORING NO. **9231** DATE _____ SHEET **3** OF **3**

PROJECT **ROCKPORT PLANT**

BORING START **10/28/92** BORING FINISH **11/03/92**

SAMPLE NUMBER	SAMPLE	SAMPLE DEPTH IN FEET		STANDARD PENETRATION RESISTANCE BLOWS / 6"	TOTAL LENGTH RECOVERY	RQD %	DEPTH IN FEET	GRAPH LOG	U S C S	SOIL / ROCK IDENTIFICATION	WELL	DRILLER'S NOTES
		FROM	TO									
46	SS	114.3	115.8	3-4-8	1.1					GRAY SAND medium to fine grain.		
47	SS	116.8	118.3	5-10-12	1.3							
48	SS	118.3	119.8	10-14-18								
												119.8 STOPPED BORING PER J.T. MASSEY-NORTON. volclay grout to surface

COMPANY INDIAN AND MICHIGAN POWER CO.
 PROJECT ROCKPORT ASH LANDFILL
 COORDINATES N.160702.32 E.521529.05
 DATE INSTALLED 11-17-92

WELL CONSTRUCTION
 SUMMARY ELEVATION
 (ft. NGVD)
 WELL NO. 13-S
 REF. DATUM PT. 399.91
 GRADE 397.92


MW-13S

NOTE: CASING PROTECTOR DETAILS
 NOT SHOWN

5/31/2016
 Reference Point
 399.79
 (top of 2" PVC pipe)

5/31/2016
 Top of Ground 398.26

- 1 GROUT SEAL VOLCLAY
- 2 BENTONITE SEAL
- 3 SCREEN 9.0 FEET
- 4 GRAVEL PACK
- 5 N.A.
- 6 RISER PIPE 2.0 INCH

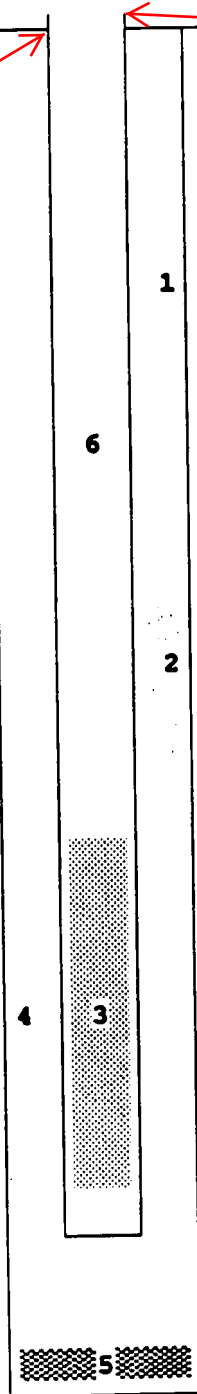

TOP OF BENTONITE SEAL 368.9

TOP OF GRAVEL PACK 363.9

TOP OF SCREEN 363.4

BOTTOM OF SCREEN 354.4

BOTTOM OF GRAVEL PACK 353.4

BOTTOM OF BORE HOLE 353.4

GEOTECHNICAL ENGINEERING SECTION
 CIVIL ENGINEERING DESIGN

AMERICAN ELECTRIC POWER SERVICE CORPORATION

OBSERVATION
 WELL

CDS-04

AEP CIVIL ENGINEERING LABORATORY
LOG OF BORING



JOB NUMBER _____
 COMPANY **INDIANA MICHIGAN POWER COMPANY**
 PROJECT **ROCKPORT PLANT**
 COORDINATES **N 160,702.3 E 521,529.1**
 GROUND ELEVATION **397.9** SYSTEM _____

BORING NO. **9232** DATE _____ SHEET **1** OF **3**
 BORING START **10/18/92** BORING FINISH **10/19/92**
 PIEZOMETER TYPE _____ WELL TYPE **SS**
 HGT. RISER ABOVE GROUND _____ DIA **2.0**
 DEPTH TO TOP OF WELL SCREEN _____ BOTTOM _____
 WELL DEVELOPMENT _____ BACKFILL **VOLCLAY**
 FIELD PARTY **MCR-GCF** RIG **BK-81**

WATER LEVEL	▽ 31.2	▽	▽
TIME			
DATE	11-18-92		

SAMPLE NUMBER	SAMPLE	SAMPLE DEPTH IN FEET		STANDARD PENETRATION RESISTANCE BLOWS / 6"	TOTAL RECOVERY	RQD %	DEPTH IN FEET	GRAPH LOG	U S C S	SOIL / ROCK IDENTIFICATION	WELL	DRILLER'S NOTES
		FROM	TO									
1	SS	1.6	3.1	3-6-8	1.5			x		BROWN/GRAY CLAYEY SILT dry		Well no. 13-S Second hole was drilled to install well. 29.0 Top of bentonite seal. 34.0 Top of gravel pack. 34.0 Began washing hole with drill mud to keep out plug. 34.5 Top of screen. 43.5 Bottom of screen. 44.5 Bottom of gravel pack. Hole drilled with
2	SS	4.1	5.6	4-8-9	1.5		5	x		BROWN SANDY CLAYEY SILT very fine grain, dry to moist.		
3	SS	6.6	8.1	1-1-5	1.5			x				
4	SS	9.1	10.6	3-4-6	1.5		10	x				
5	SS	11.6	13.1	3-4-6	1.5			x				
6	SS	14.1	15.6	3-3-6	1.5		15	x		CLAYEY SAND fine grain, moist.		
7	SS	16.6	18.1	3-3-8	1.5			x				
8	SS	19.1	20.6	4-5-6	1.2		20	x		sand fine grain.		
9	SS	21.6	23.1	4-6-9	1.3			x				
10	SS	24.1	25.6	8-11-11	1.0		25	x		BROWN SAND medium grain, with some pea size gravel, moist.		
11	SS	26.6	28.1	5-7-10	1.2			x		BROWN SAND medium to course grain with pea size gravel.		
12	SS	29.1	30.6	4-7-10	1.3		30	x				
13	SS	31.6	33.1	6-8-9	1.2			x		BROWN SAND medium to course grain, moist to wet.		
14	SS	34.1	35.6	6-9-11	1.0		35	x		BROWN GRAVELLY SAND maximum size 1", saturated		
15	SS	36.6	38.1	8-12-15	1.0			x		BROWN SAND AND GRAVEL		
16	SS	39.1	40.6	8-11-13	1.0		40	x				
17	SS	41.6	43.1	10-14-16	.8			x				
18	SS	44.1	45.6	9-11-16	1.2		45	x				
19	SS	46.6	48.1	8-18-24	1.0			x		grading to more sand 46.6.		

TYPE OF CASING USED			<i>Continued Next Page</i>	
	NQ-2 ROCK CORE		PIEZOMETER TYPE: PT = OPEN TUBE POROUS TIP, SS = OPEN TUBE SLOTTED SCREEN, G = GEONOR, P = PNEUMATIC	
X	6" x 3.25 HSA		WELL TYPE: OW = OPEN TUBE, GM = GEOMON	
X	9" x 6.25 HSA		RECORDER _____	
	HW CASING ADVANCER 4"			
	NW CASING 3"			
	SW CASING 6"			

AMERICAN ELECTRIC POWER SERVICE CORPORATION
 AEP CIVIL ENGINEERING LABORATORY
 LOG OF BORING



JOB NUMBER _____

COMPANY **INDIANA MICHIGAN POWER COMPANY**

BORING NO. **9232** DATE _____ SHEET **2** OF **3**

PROJECT **ROCKPORT PLANT**

BORING START **10/18/92** BORING FINISH **10/19/92**

SAMPLE NUMBER	SAMPLE	SAMPLE DEPTH IN FEET		STANDARD PENETRATION RESISTANCE BLOWS / 6"	TOTAL PENETRATION RESISTANCE	ROD %	DEPTH IN FEET	GRAPH LOG	U S C S	SOIL / ROCK IDENTIFICATION	WELL	DRILLER'S NOTES
		FROM	TO									
20	SS	49.1	50.6	9-16-17	1.0					BROWN GRAVELLY SAND medium to course grain, pea size gravel with 1.5" limestone gravel. 3" LAYER OF FINE GRAIN BROWN SAND 54.3 TO 54.6. GRAY SAND fine to medium grain with some pea size gravel. GRAY GRAVELLY SAND medium to course grain, maximum size 1". 3" seam of pea gravel GRAY SAND fine to medium grain, with gray sandy clay layer 94.7 to 95.0. medium grain GREENISH GRAY SILTY GRAVELLY CLAY fine to medium grain. GREENISH/GRAY SILTY SAND v-fine grain. 104.0 to 105.6 gravelly sand course grain GRAY SAND AND GRAVEL 1" maximum size. GRAY LIMESTONE	6.25 augers and stainless steel plate remaining in boring. Seal made with prepacked bentonite donuts. 34.3-35.7 Spacer. 42.8-44.2 Spacer.	
21	SS	51.6	53.1	10-18-26	1.1							
22	SS	54.1	55.6	13-18-28	1.3		55					
23	SS	56.6	58.1	11-14-18	1.5							
24	SS	59.1	60.6	7-10-12	1.5		60					
25	SS	61.6	63.1	6-11-11	1.2							
26	SS	64.1	65.6	8-10-12	1.0		65					
27	SS	66.6	68.1	8-12-25	1.0							
28	SS	69.1	70.6	6-9-15	1.2		70					
29	SS	71.6	73.1	10-18-28	1.0							
30	SS	74.1	75.6	9-12-15	1.2		75					
31	SS	76.6	78.1	12-15-15	1.5							
32	SS	79.1	80.6	11-15-20	1.3		80					
33	SS	81.6	83.1	12-19-30	1.0							
34	SS	84.1	85.6	12-24-30	1.2		85					
35	SS	86.6	88.1	13-17-28	1.3							
36	SS	89.1	90.6	6-9-14	1.0		90					
37	SS	91.6	93.1	1-2-5	0							
38	SS	94.1	95.6	13-18-26	1.5		95					
39	SS	96.6	98.1	5-10-24	1.5							
40	SS	99.1	100.6	21-31-21	1.5		100					
41	SS	101.6	103.1	7-10-11	1.5							
42	SS	104.1	105.6	10-12-13	1.5		105					
43	SS	106.6	108.1	11-12-20	.6							
44	SS	109.1	110.6	4-6-8	1.2		110					
1	SS	111.5	111.6	50/1	45					111.6 Auger refusal. volclay grout top 30.0 feet of hole.		

Continued Next Page

AMERICAN ELECTRIC POWER SERVICE CORPORATION
 AEP CIVIL ENGINEERING LABORATORY
 LOG OF BORING



JOB NUMBER _____

COMPANY INDIANA MICHIGAN POWER COMPANY

BORING NO. 9232 DATE _____ SHEET 3 OF 3

PROJECT ROCKPORT PLANT

BORING START 10/18/92 BORING FINISH 10/19/92

SAMPLE NUMBER	SAMPLE	SAMPLE DEPTH IN FEET		STANDARD PENETRATION RESISTANCE BLOWS / 6"	TOTAL LENGTH RECOVERED	RQD	DEPTH IN FEET	GRAPH LOG	U S C S	SOIL / ROCK IDENTIFICATION	WELL	DRILLER'S NOTES
		FROM	TO			%						
												This boring was off site, going to set piezometer on company property 10 to 12 feet north. Per farmer, Carl Scaggs and J. Massey-Norton.

COMPANY INDIAN AND MICHIGAN POWER CO.
 PROJECT ROCKPORT ASH LANDFILL
 COORDINATES N.164779.40 E.518743.82
 DATE INSTALLED 12-8-922

WELL CONSTRUCTION
 SUMMARY ELEVATION
 (ft. NGVD)

WELL NO. 14-S
 REF. DATUM PT. 394.45
 GRADE 392.52


MW-14S

5/31/2016
 Reference Point
 394.78
 (top of 2" PVC pipe)

NOTE: CASING PROTECTOR DETAILS
 NOT SHOWN

5/31/2016
 Top of Ground 392.66

- 1 GROUT SEAL VOLCLAY
- 2 BENTONITE SEAL
- 3 SCREEN 9.0 FEET
- 4 GRAVEL PACK
- 5 N.A.
- 6 RISER PIPE 2.0 INCH

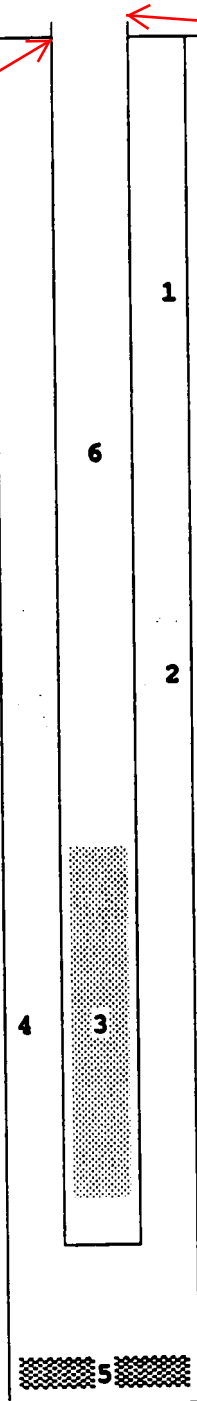

TOP OF BENTONITE SEAL 376.3

TOP OF GRAVEL PACK 371.3

TOP OF SCREEN 370.5

BOTTOM OF SCREEN 361.5

BOTTOM OF GRAVEL PACK 360.5

BOTTOM OF BORE HOLE 360.5

GEOTECHNICAL ENGINEERING SECTION
 CIVIL ENGINEERING DESIGN

OBSERVATION
 WELL

AMERICAN ELECTRIC POWER SERVICE CORPORATION

CDS-04

AEP CIVIL ENGINEERING LABORATORY
LOG OF BORING



JOB NUMBER _____
 COMPANY INDIANA MICHIGAN POWER COMPANY
 PROJECT ROCKPORT PLANT
 COORDINATES N 164,779.4 E 518,743.8
 GROUND ELEVATION 392.5 SYSTEM _____

BORING NO. 9233 DATE _____ SHEET 1 OF 1
 BORING START 09/27/92 BORING FINISH 09/28/92
 PIEZOMETER TYPE _____ WELL TYPE SS
 HGT. RISER ABOVE GROUND _____ DIA 2"
 DEPTH TO TOP OF WELL SCREEN _____ BOTTOM _____
 WELL DEVELOPMENT _____ BACKFILL VOLCLAY
 FIELD PARTY ROUSH/FOLGER RIG B-81

WATER LEVEL	▽ 26.1	▽	▽
TIME			
DATE	9-28-92		

SAMPLE NUMBER	SAMPLE	SAMPLE DEPTH IN FEET		STANDARD PENETRATION RESISTANCE BLOWS / 6"	TOTAL LENGTH RECOVERY	RQD %	DEPTH IN FEET	GRAPH LOG	U S C S	SOIL / ROCK IDENTIFICATION	WELL	DRILLER'S NOTES
		FROM	TO									
1	SPT	1.7	3.2	3-9-16	1.5		5			<u>GRAY AND BROWN SILTY CLAY, dry to moist.</u>		Well no. 14-S Second hole was drilled to install well.
2	SS	5.0	7.0		2.0							
3	SS	7.0	9.0		2.0							
4	SS	10.0	12.0		2.0		10					
5	SS	12.0	14.0		.8							
6	SS	15.0	17.0		.4		15			<u>BROWN SAND GRAVEL</u>		16.2 Top of bentonite seal.
7	SS	17.0	17.2	33-50/.2	.2					<u>REDDISH BROWN SAND w/PEA GRAVEL, medium to coarse grain sand, some 1/4" gravel, dry.</u>		
8	SPT	17.2	18.5		.6							
9	SPT	19.5	21.0	8-20-25	1.4		20					21.2 Top of gravel pack. 22.0 Top of screen.
10	SPT	22.0	23.5	12-13-16	.8							
11	SPT	24.5	26.0	10-15-24	.9		25					Hit water.
12	SPT	27.0	28.5	6-5-5	1.1					<u>BROWN CLAYEY SAND, medium grain, wet.</u>		
13	SPT	29.5	31.0	4-7-12	1.3		30			<u>BROWN SAND, fine to medium grain, some pea gravel, wet.</u>		31.0 Bottom of screen. 32.0 Bottom of gravel pack.
14	SPT	32.0	33.5	4-9-11								Hole drilled with 6.25 augers and stainless steel plates remaining in hole. Seal made with prepacked bentonite donuts and water placed on seal. 22.2-23.6 Spacer. 30.3-31.7 Spacer
15	SPT	34.5	34.8	50/.3	.3		35			<u>BROWN TO TAN SILTY CLAY SHALE</u>		
16	A	34.8	36.4									

TYPE OF CASING USED			PIEZOMETER TYPE: PT = OPEN TUBE POROUS TIP, SS = OPEN TUBE SLOTTED SCREEN, G = GEONOR, P = PNEUMATIC
X	NQ-2 ROCK CORE		
X	6" x 3.25 HSA		WELL TYPE: OW = OPEN TUBE, GM = GEOMON
X	9" x 6.25 HSA		
	HW CASING ADVANCER	4"	
	NW CASING	3"	
	SW CASING	6"	RECORDER _____

COMPANY INDIAN AND MICHIGAN POWER CO.
 PROJECT ROCKPORT ASH LANDFILL
 COORDINATES N.163584.97 E.521886.93
 DATE INSTALLED 11-13-92

WELL CONSTRUCTION
 SUMMARY ELEVATION
 (ft. NGVD)
 WELL NO. 15-S
 REF. DATUM PT. 392.53
 GRADE 390.53


MW-15S

NOTE: CASING PROTECTOR DETAILS
 NOT SHOWN

5/31/2016
 Reference Point
 392.46
 (top of 2" PVC cap)

5/31/2016
 Top of Ground 391.53

- 1 GROUT SEAL VOLCLAY
- 2 BENTONITE SEAL
- 3 SCREEN 9.0 FEET
- 4 GRAVEL PACK
- 5 N.A.
- 6 RISER PIPE 2.0 INCH

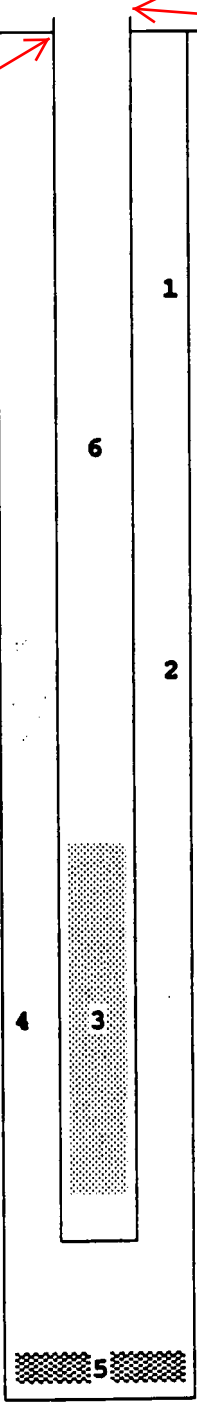

TOP OF BENTONITE SEAL 366.5

TOP OF GRAVEL PACK 361.5

TOP OF SCREEN 360.4

BOTTOM OF SCREEN 351.4

BOTTOM OF GRAVEL PACK 350.4

BOTTOM OF BORE HOLE 350.4

GEOTECHNICAL ENGINEERING SECTION CIVIL ENGINEERING DESIGN	OBSERVATION WELL
AMERICAN ELECTRIC POWER SERVICE CORPORATION	CDS-04

COMPANY INDIAN AND MICHIGAN POWER CO.
 PROJECT ROCKPORT ASH LANDFILL
 COORDINATES N.163578.20 E.521892.67
 DATE INSTALLED 11-13-92

WELL CONSTRUCTION
 SUMMARY ELEVATION
 (ft. NGVD)
 WELL NO. 15-I
 REF. DATUM PT. 392.70
 GRADE 390.46


MW-15I

NOTE: CASING PROTECTOR DETAILS
 NOT SHOWN

5/31/2016
 Reference Point
 392.70
 (top of 2" PVC cap)

5/31/2016
 Top of Ground 391.60

- 1 GROUT SEAL VOLCLAY
- 2 BENTONITE SEAL
- 3 SCREEN 9.0 FEET
- 4 GRAVEL PACK
- 5 N.A.
- 6 RISER PIPE 2.0 INCH

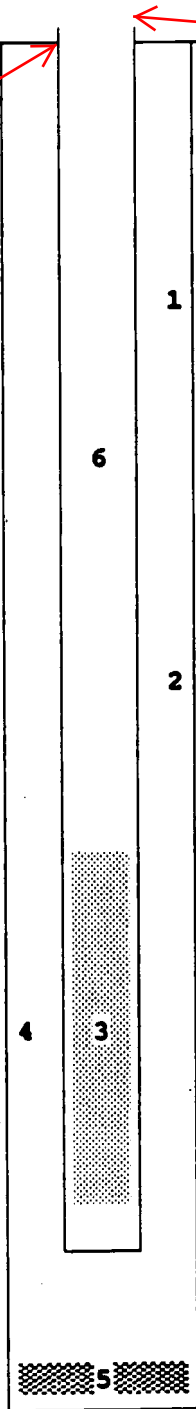

TOP OF BENTONITE SEAL 340.1

TOP OF GRAVEL PACK 335.1

TOP OF SCREEN 334.7

BOTTOM OF SCREEN 325.7

BOTTOM OF GRAVEL PACK 324.7

BOTTOM OF BORE HOLE 324.7

GEOTECHNICAL ENGINEERING SECTION
 CIVIL ENGINEERING DESIGN

OBSERVATION
 WELL

AMERICAN ELECTRIC POWER SERVICE CORPORATION

CDS-04

AEP CIVIL ENGINEERING LABORATORY
LOG OF BORING



JOB NUMBER _____
 COMPANY **INDIANA MICHIGAN POWER COMPANY**
 PROJECT **ROCKPORT PLANT**
 COORDINATES **N 163,585.0 E 521,886.9**
 GROUND ELEVATION **390.5** SYSTEM _____

BORING NO. **9234** DATE _____ SHEET **1** OF **2**
 BORING START **09/12/92** BORING FINISH **09/24/92**
 PIEZOMETER TYPE _____ WELL TYPE **SS**
 HGT. RISER ABOVE GROUND _____ DIA **2"**
 DEPTH TO TOP OF WELL SCREEN _____ BOTTOM _____
 WELL DEVELOPMENT _____ BACKFILL **VOLCLAY**
 FIELD PARTY **ROUSH/FOLGER** RIG **BK-81**

WATER LEVEL	▽ 24.5	▽	▽
TIME			
DATE	9-13-92		

SAMPLE NUMBER	SAMPLE	SAMPLE DEPTH IN FEET		STANDARD PENETRATION RESISTANCE BLOWS / 6"	TOTAL LENGTH RECOVERY	ROD %	DEPTH IN FEET	GRAPH LOG	USCS	SOIL / ROCK IDENTIFICATION	WELL	DRILLER'S NOTES
		FROM	TO									
1	SPT	0.0	1.5	6-7-10	1.5					BROWN-GRAY SILTY CLAY, dry.		Well no. 15-S 15-1 Second and third hole drilled to install wells.
2	SPT	1.5	3.0	4-4-8	1.3							
3	SPT	3.0	4.5	3-4-5	1.5							
4	SPT	4.5	6.0	5-6-9	1.5		5			BROWN-GRAY SILTY CLAY, with a trace of very fine grain sand, dry to moist.		
5	SPT	6.0	7.5	4-7-10	1.5					BROWN w/some GRAY CLAYEY SAND, seams of each throughout.		
6	SPT	7.5	9.0	3-7-9	1.5							
7	SPT	9.0	10.5	3-5-10	1.5		10					
8	SPT	10.5	12.0	3-6-9	1.1							
9	SPT	12.0	13.5	3-7-10	1.5							
10	SPT	13.5	15.0	3-4-5	1.5							
11	SPT	15.0	16.5	3-4-6	1.5		15			BROWN SILTY CLAY, with some fine grain sand.		
12	SPT	16.5	18.0	4-5-7	1.5							
13	SPT	18.0	19.5	2-4-4	1.5							
14	SPT	19.5	21.0	2-2-4	1.5		20			BROWN-GRAY CLAYEY SAND, fine grain, moist.		
15	SPT	21.0	22.5	2-2-3	1.5							
16	SPT	22.5	24.0	2-5-9	1.3							
17	SPT	24.0	25.5	12-16-20	.9		25			BROWN CLAYEY SAND, medium to coarse grain, moist.		24.0 Top of bentonite seal.
18	SPT	25.5	27.0	8-9-12	1.2					RUSTY BROWN SAND w/PEA GRAVEL, medium to coarse grain, wet.		Hit water.
19	SPT	27.0	28.5	6-7-8	1.3							Water level 9-13-92.
20	SPT	28.5	30.0	4-5-6	1.4		30			GRAY SAND w/PEA GRAVEL, medium to coarse grain, some 1/4" to 1/2" gravel		29.0 Top of gravel pack.
21	SPT	30.0	31.5	7-9-14	1.5							30.1 Top of screen.
22	SPT	31.5	33.0	9-12-18	1.5					BROWN SAND, medium to coarse grain, with lens clay.		Began using drill mud.
23	SPT	33.0	34.5	7-7-10	.8					BROWN SAND w/GRAVEL, medium to coarse grain.		
24	SPT	34.5	36.0	5-7-16	1.0		35			TAN-BROWN SAND w/PEA GRAVEL, medium to coarse grain, some 1/4" to 1/2" gravel.		39.1 Bottom of screen.
25	SPT	36.0	37.5	8-17-19	1.0							40.1 Bottom of gravel pack.
26	SPT	37.5	39.0	8-11-20	1.1					SAND, fine to medium grain with lens black organic.		
27	SPT	39.0	40.5	7-14-18	1.0		40			GRAY SAND, medium to coarse grain.		
28	SPT	41.5	43.0	10-22-24	.8					GRAY SAND w/PEA GRAVEL, medium to coarse grain, 1/2" lens organic, some 1/4" to 1/2" gravel.		
29	SPT	44.0	45.5	9-14-17	1.3		45					
30	SPT	46.5	48.0	7-14-20	1.0							

TYPE OF CASING USED			<i>Continued Next Page</i>	
	NQ-2 ROCK CORE		PIEZOMETER TYPE: PT = OPEN TUBE POROUS TIP, SS = OPEN TUBE SLOTTED SCREEN, G = GEONOR, P = PNEUMATIC	
X	6" x 3.25 HSA		WELL TYPE: OW = OPEN TUBE, GM = GEOMON	
X	9" x 6.25 HSA		RECORDER _____	
	HW CASING ADVANCER 4"			
	NW CASING 3"			
	SW CASING 6"			

COMPANY INDIAN AND MICHIGAN POWER CO.
 PROJECT ROCKPORT ASH LANDFILL
 COORDINATES N.162944.89 E.521986.62
 DATE INSTALLED 12-11-92

**WELL CONSTRUCTION
 SUMMARY ELEVATION
 (ft. NGVD)**

WELL NO. 16-S
 REF. DATUM PT. 394.38
 GRADE 392.49


MW-16S

NOTE: CASING PROTECTOR DETAILS
 NOT SHOWN

5/31/2016
 Reference Point
 394.35
 (top of 2" PVC cap)

5/31/2016
 Top of Ground 393.58

- 1 GROUT SEAL VOLCLAY
- 2 BENTONITE SEAL
- 3 SCREEN 9.0 FEET
- 4 GRAVEL PACK
- 5 N.A.
- 6 RISER PIPE 2.0 INCH

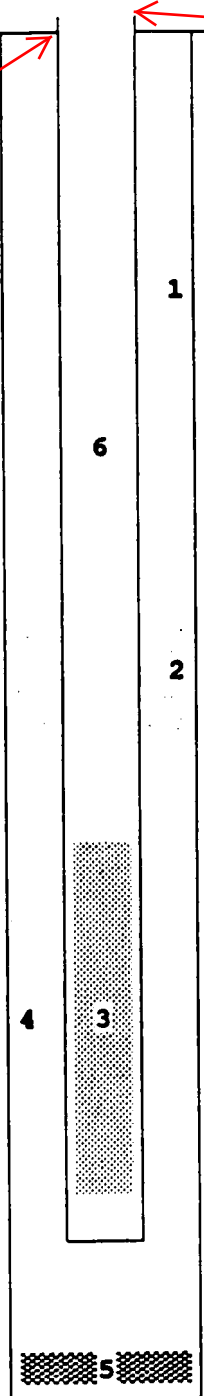

TOP OF BENTONITE SEAL 369.5

TOP OF GRAVEL PACK 364.5

TOP OF SCREEN 363.6

BOTTOM OF SCREEN 354.6

BOTTOM OF GRAVEL PACK 353.6

BOTTOM OF BORE HOLE 353.6

GEOTECHNICAL ENGINEERING SECTION
 CIVIL ENGINEERING DESIGN

AMERICAN ELECTRIC POWER SERVICE CORPORATION

OBSERVATION
 WELL

CDS-04

COMPANY INDIAN AND MICHIGAN POWER CO.
 PROJECT ROCKPORT ASH LANDFILL
 COORDINATES N.162943.87 E.521995.51
 DATE INSTALLED 12-11-92

WELL CONSTRUCTION
 SUMMARY ELEVATION
 (ft. NGVD)

WELL NO. 16-I
 REF. DATUM PT. 394.38
 GRADE 392.64


MW-16I

NOTE: CASING PROTECTOR DETAILS
 NOT SHOWN

5/31/2016
 Reference Point
 394.26
 (top of 2" PVC cap)

5/31/2016
 Top of Ground 393.47

- 1 GROUT SEAL VOLCLAY
- 2 BENTONITE SEAL
- 3 SCREEN 9.0 FEET
- 4 GRAVEL PACK
- 5 N.A.
- 6 RISER PIPE 2.0 INCH

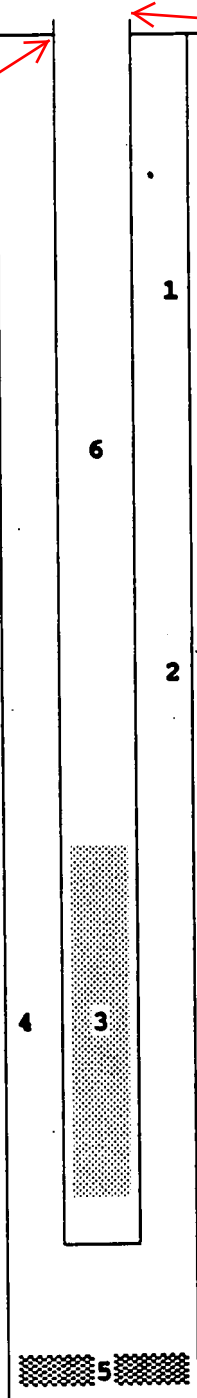

TOP OF BENTONITE SEAL 341.0

TOP OF GRAVEL PACK 336.0

TOP OF SCREEN 334.9

BOTTOM OF SCREEN 325.9

BOTTOM OF GRAVEL PACK 324.9

BOTTOM OF BORE HOLE 324.9

GEOTECHNICAL ENGINEERING SECTION
 CIVIL ENGINEERING DESIGN

OBSERVATION
 WELL

AMERICAN ELECTRIC POWER SERVICE CORPORATION

CDS-04

COMPANY INDIAN AND MICHIGAN POWER CO.
 PROJECT ROCKPORT ASH LANDFILL
 COORDINATES N.162946.25 E.521978.31
 DATE INSTALLED 12-9-92

WELL CONSTRUCTION
 SUMMARY ELEVATION
 (ft. NGVD)
 WELL NO. 16-D
 REF. DATUM PT. 394.47
 GRADE 392.53


MW-16D

NOTE: CASING PROTECTOR DETAILS
 NOT SHOWN

5/31/2016
 Reference Point
 394.38
 (top of 2" PVC cap)

5/31/2016
 Top of Ground 393.83

- 1 GROUT SEAL VOLCLAY
- 2 BENTONITE SEAL
- 3 SCREEN 9.0 FEET
- 4 GRAVEL PACK
- 5 N.A.
- 6 RISER PIPE 2.0 INCH

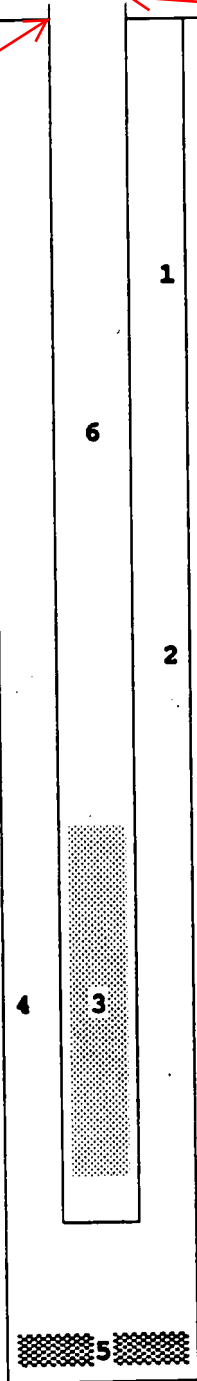

TOP OF BENTONITE SEAL 308.5

TOP OF GRAVEL PACK 303.5

TOP OF SCREEN 302.8

BOTTOM OF SCREEN 293.8

BOTTOM OF GRAVEL PACK 292.8

BOTTOM OF BORE HOLE 292.8

GEOTECHNICAL ENGINEERING SECTION
 CIVIL ENGINEERING DESIGN

AMERICAN ELECTRIC POWER SERVICE CORPORATION

OBSERVATION
 WELL

CDS-04

AMERICAN ELECTRIC POWER SERVICE CORPORATION
 AEP CIVIL ENGINEERING LABORATORY
 LOG OF BORING



JOB NUMBER _____
 COMPANY **INDIANA MICHIGAN POWER COMPANY**
 PROJECT **ROCKPORT PLANT**
 COORDINATES **N 162,944.9 E 521,986.6**
 GROUND ELEVATION **392.5** SYSTEM _____

BORING NO. **9243** DATE _____ SHEET **1** OF **3**
 BORING START **10/14/92** BORING FINISH **10/17/92**
 PIEZOMETER TYPE _____ WELL TYPE **SS**
 HGT. RISER ABOVE GROUND _____ DIA **2.0**
 DEPTH TO TOP OF WELL SCREEN _____ BOTTOM _____
 WELL DEVELOPMENT _____ BACKFILL _____
 FIELD PARTY **MCR-GCF** RIG **BK-81**

WATER LEVEL	▽ 27.5	▽	▽
TIME			
DATE	10-14-92		

SAMPLE NUMBER	SAMPLE	SAMPLE DEPTH IN FEET		STANDARD PENETRATION RESISTANCE BLOWS / 6"	TOTAL RECOVERY	RQD %	DEPTH IN FEET	GRAPH LOG	U S C S	SOIL / ROCK IDENTIFICATION	WELL	DRILLER'S NOTES
		FROM	TO									
1	SS	0.0	1.5	1-2-3	.8					BROWN SILT dry		Well no. 16-S, 16-I, 16-D Wells were installed in three holes.
2	SS	1.5	3.0	11-12-13	.3					BROWN/GRAY SILT dry		
3	SS	3.0	5.0	10-12-12	1.5							
4	ST	5.0	7.0		.2		5			TAN TO BROWN CLAYEY SILT		
5	ST	7.0	9.0		0							
6	SS	9.0	10.0	20	0		10			BROWN SILT with trace of very fine sand		push 2.0, recovery 2.0, time 8, psi 1200
7	ST	10.0	12.0		2.0					BROWN CLAYEY SILT		
8	ST	12.0	14.0		2.0							
9	SS	14.0	15.0	12-15	1.0		15			REDDISH BROWN GRAY SANDY SILT fine grain.		push 2.0, recovery 1.7, time 10 psi 1500
10	ST	15.0	17.0		1.7					BROWN TO TAN CLAYEY SILT with a trace of very fine sand.		
11	SS	17.0	19.0	9-13-15	1.5					BROWN SANDY SILT fine grain.		
12	SS	19.0	20.5	5-8-10	1.2		20			BROWN SANDY CLAYEY SILT fine grain.		
13	SS	20.5	22.0	5-10-9	1.2					BROWN/GRAY SANDY CLAY fine grain.		23.0 Top of bentonite seal.
14	SS	22.0	23.5	4-5-14	1.5							
15	SS	23.5	25.0	6-18-18	1.3		25			REDDISH/BROWN SAND medium grain with some pea size gravel, dry to moist.		
16	SS	25.0	26.5	12-13-15	1.0							28.0 Top of gravel pack.
17	SS	26.5	28.0	5-9-13	1.0					BROWN GRAVELLY SAND medium to course grain, 1/2" maximum size, dry to moist.		
18	SS	28.0	29.5	5-6-7	1.2		30			WET SAND medium to course grain, saturated.		28.9 Top of screen.
19	SS	29.5	31.0	4-6-6	1.0							
20	SS	31.0	32.5	5-5-7	1.1							Began using drill mud to keep out plug.
21	SS	32.5	34.0	6-9-11	1.1					BROWN SAND AND GRAVEL 1/2" maximum size.		
22	SS	34.0	35.5	6-6-10	1.0		35			SAME WITH 3/4" MAXIMUM SIZE.		
23	SS	35.5	37.0	5-5-7	.8							37.9 Bottom of screen.
24	SS	37.0	38.5	4-4-6	.7							
25	SS	38.5	40.0	13-13-9	1.0		40					38.9 Bottom of gravel pack.
26	SS	41.6	43.1	7-11-15	.9							
27	SS	44.1	45.6	8-14-16	1.5		45					
28	SS	46.6	48.1	8-11-13	1.5							

TYPE OF CASING USED				<i>Continued Next Page</i>			
	X	NQ-2 ROCK CORE		PIEZOMETER TYPE: PT = OPEN TUBE POROUS TIP, SS = OPEN TUBE SLOTTED SCREEN, G = GEONOR, P = PNEUMATIC			
	X	6" x 3.25 HSA		WELL TYPE: OW = OPEN TUBE, GM = GEOMON			
	X	9" x 6.25 HSA		RECORDER _____			
		HW CASING ADVANCER 4"					
		NW CASING 3"					
		SW CASING 6"					

AMERICAN ELECTRIC POWER SERVICE CORPORATION
 AEP CIVIL ENGINEERING LABORATORY
 LOG OF BORING



JOB NUMBER _____

COMPANY **INDIANA MICHIGAN POWER COMPANY**

BORING NO. **9243** DATE _____ SHEET **2** OF **3**

PROJECT **ROCKPORT PLANT**

BORING START **10/14/92** BORING FINISH **10/17/92**

SAMPLE NUMBER	SAMPLE	SAMPLE DEPTH IN FEET		STANDARD PENETRATION RESISTANCE BLOWS / 6"	TOTAL PENETRATION RELATIVE	RQD %	DEPTH IN FEET	GRAPH LOG	U S C S	SOIL / ROCK IDENTIFICATION	WELL	DRILLER'S NOTES
		FROM	TO									
29	SS	49.1	50.6	8-11-12	.8					GRAY SAND medium to coarse grain 51.6 Top of bentonite seal. 56.6 Top of gravel pack. 57.7 Top of screen. 66.7 Bottom of screen. 67.7 Bottom of gravel pack. BROWN SAND fine grain. 84.0 Top of bentonite seal. 89.0 Top of gravel pack. 89.7 Top of screen. BROWN SAND fine to medium grain. medium grain. BROWN SAND 100.4 TO 100.5 SEAM OF CLAYEY PEA SIZE GRAVEL. BROWN CLAY SHALE weathered.		
30	SS	50.6	52.1	2-12-22	.9							
31	SS	52.1	53.6	7-11-16	1.0							
32	SS	53.6	55.1	6-11-17	.8		55					
33	SS	55.1	56.6	8-14-14	1.2							
34	SS	56.6	58.1	6-11-16	1.3							
35	SS	58.1	59.6	11-11-16	1.4							
36	SS	59.6	61.1	6-12-15	0		60					
37	SS	61.6	63.1	13-15-15	1.1							
38	SS	64.1	65.6	14-15-15	1.0		65					
39	SS	66.6	68.1	14-16-21	1.2							
40	SS	69.1	70.6	22-26-21	1.0		70					
41	SS	71.6	73.1	12-12-10	1.1							
42	SS	74.1	75.6	6-6-10	.9		75					
43	SS	76.6	78.1	7-8-10	1.5							
44	SS	79.1	80.6	7-7-9	1.3		80					
45	SS	80.6	82.1	8-11-13	1.3							
46	SS	82.1	83.6	8-12-17	1.2							
47	SS	83.6	85.1	6-11-15	1.3		85					
48	SS	85.1	86.6	7-9-14	1.5							
49	SS	86.6	88.1	6-11-15	1.5							
50	SS	88.1	89.6	4-8-13	1.3		90					
51	SS	91.6	93.1	4-6-8	1.4							
52	SS	94.1	95.6	5-5-8	1.3		95					
53	SS	96.6	98.1	6-7-11	1.2							
54	SS	99.1	100.6	4-8-11	.9		100					
55	SS	101.6	102.3	50-50/2	.6							

Continued Next Page

AMERICAN ELECTRIC POWER SERVICE CORPORATION
AEP CIVIL ENGINEERING LABORATORY
 LOG OF BORING



JOB NUMBER _____

COMPANY **INDIANA MICHIGAN POWER COMPANY**

BORING NO. **9243** DATE _____ SHEET **3** OF **3**

PROJECT **ROCKPORT PLANT**

BORING START **10/14/92** BORING FINISH **10/17/92**

SAMPLE NUMBER	SAMPLE	SAMPLE DEPTH IN FEET		STANDARD PENETRATION RESISTANCE BLOWS / 6"	TOTAL LENGTH RECOVERY	RQD	DEPTH IN FEET	GRAPH LOG	U S C S	SOIL / ROCK IDENTIFICATION	WELL	DRILLER'S NOTES
		FROM	TO			%						
												Seal was premade bentonite donuts. 102.7 Auger refusal at 102.7, void clay grouted top of boring.

COMPANY INDIAN AND MICHIGAN POWER CO.
 PROJECT ROCKPORT ASH LANDFILL
 COORDINATES N.164398.59 E.521162.54
 DATE INSTALLED 11-1-92

WELL CONSTRUCTION
 SUMMARY ELEVATION
 (ft. NGVD)
 WELL NO. 17-S
 REF. DATUM PT. 395.46
 GRADE 393.13


MW-17S

NOTE: CASING PROTECTOR DETAILS
 NOT SHOWN

5/31/2016
 Reference Point
 395.34
 (top of 2" PVC cap)

5/31/2016
 Top of Ground 393.85

- 1 GROUT SEAL VOLCLAY
- 2 BENTONITE SEAL
- 3 SCREEN 9.0 FEET
- 4 GRAVEL PACK
- 5 N.A.
- 6 RISER PIPE 2.0 INCH

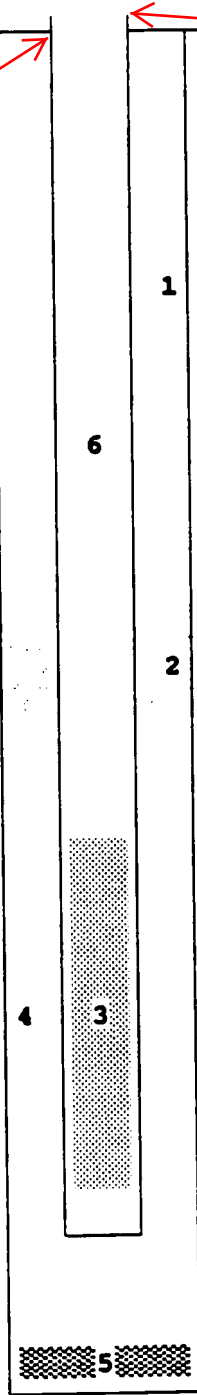

TOP OF BENTONITE SEAL 368.6

TOP OF GRAVEL PACK 363.6

TOP OF SCREEN 362.5

BOTTOM OF SCREEN 353.6

BOTTOM OF GRAVEL PACK 352.6

BOTTOM OF BORE HOLE 352.6

GEOTECHNICAL ENGINEERING SECTION
 CIVIL ENGINEERING DESIGN

AMERICAN ELECTRIC POWER SERVICE CORPORATION

OBSERVATION
 WELL

CDS-04

COMPANY INDIAN AND MICHIGAN POWER CO.
PROJECT ROCKPORT ASH LANDFILL
COORDINATES N.164404.36 E.521157.17
DATE INSTALLED 11-1-92

WELL CONSTRUCTION
SUMMARY ELEVATION
(ft. NGVD)
WELL NO. 17-I
REF. DATUM PT. 395.29
GRADE 393.28


MW-171

NOTE: CASING PROTECTOR DETAILS
NOT SHOWN

5/31/2016
Reference Point
395.40
(top of 2" PVC cap)

5/31/2016
Top of Ground 394.11

- 1 GROUT SEAL VOLCLAY
- 2 BENTONITE SEAL
- 3 SCREEN 9.0 FEET
- 4 GRAVEL PACK
- 5 N.A.
- 6 RISER PIPE 2.0 INCH

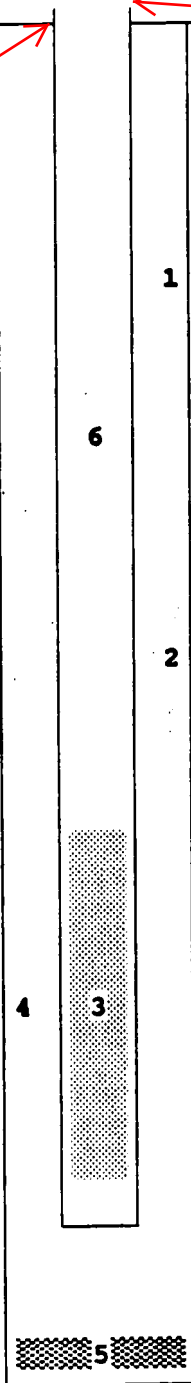

TOP OF BENTONITE SEAL 341.5

TOP OF GRAVEL PACK 337.0

TOP OF SCREEN 336.5

BOTTOM OF SCREEN 326.9

BOTTOM OF GRAVEL PACK 325.9

BOTTOM OF BORE HOLE 325.9

GEOTECHNICAL ENGINEERING SECTION
CIVIL ENGINEERING DESIGN

OBSERVATION
WELL

AMERICAN ELECTRIC POWER SERVICE CORPORATION

CDS-04

AMERICAN ELECTRIC POWER SERVICE CORPORATION
 AEP CIVIL ENGINEERING LABORATORY
 LOG OF BORING



JOB NUMBER _____
 COMPANY **INDIANA MICHIGAN POWER COMPANY**
 PROJECT **ROCKPORT PLANT**
 COORDINATES **N 164,398.6 E 521,162.5**
 GROUND ELEVATION **393.1** SYSTEM _____

BORING NO. **9245** DATE _____ SHEET **1** OF **2**
 BORING START **09/28/92** BORING FINISH **10/06/92**
 PIEZOMETER TYPE _____ WELL TYPE **SS**
 HGT. RISER ABOVE GROUND _____ DIA **2.0**
 DEPTH TO TOP OF WELL SCREEN _____ BOTTOM _____
 WELL DEVELOPMENT _____ BACKFILL **VOLCLAY**
 FIELD PARTY **MCR-GCF** RIG **BK-81**

WATER LEVEL	▽ 27.8	▽	▽
TIME			
DATE	9-28-92		

SAMPLE NUMBER	SAMPLE	SAMPLE DEPTH IN FEET		STANDARD PENETRATION RESISTANCE BLOWS / 6"	TOTAL LENGTH RECOVERY	RQD %	DEPTH IN FEET	GRAPH LOG	U S C S	SOIL / ROCK IDENTIFICATION	WELL	DRILLER'S NOTES
		FROM	TO									
1	SS	0.0	1.5	4-6-8	1.5					BROWN/GRAY SILTY CLAY dry to moist.	Well no. 17-S 17-I Wells were installed in two holes.	
2	SS	1.5	3.0	2-2-3	1.5				more clay			
3	SS	3.0	5.0	2-3-3-4	1.7				REDDISH BROWN CLAY			
4	ST	5.0	7.0				5			BROWN SILTY CLAY		
5	ST	7.0	9.0							BROWN SANDY CLAY fine grain, dry to moist.		
6	SS	9.0	10.0	7-11	1.0		10			BROWN SILTY CLAY		
7	ST	10.0	12.0		2.0					BROWN/GRAY SILTY CLAY moist.		
8	ST	12.0	14.0		2.0					BROWN SANDY CLAY fine grain, dry to moist.		
9	SS	14.0	15.0	2-4	1.0		15			BROWN CLAYEY SAND fine grain, moist.		
10	ST	15.0	17.0		100					SANDY SILTY CLAY fine grain		
11	ST	17.0	19.0		100					BROWN SANDY CLAY fine grain, dry to moist. more sand		
12	SS	19.0	20.5	3-6-7	1.5		20			BROWN SAND medium to course grain, moist to wet.		
13	SS	20.5	22.0	4-5-6	1.5						24.5 Top of bentonite seal.	
14	SS	22.0	23.5	5-8-11	1.5						29.5 Top of gravel pack.	
15	SS	23.5	25.0	3-6-7	1.3						30.5 Top of screen.	
16	SS	25.0	26.5	6-20-26	1.1		25					
17	SS	26.5	28.0	9-16-23	1.4							
18	SS	28.0	29.5	13-22-24	1.0							
19	SS	29.5	31.0	9-17-22	1.2		30					
20	SS	31.0	32.5	14-22-24	1.5							
21	SS	32.5	34.0	11-18-25	1.4							
22	SS	34.0	35.5	11-9-10	1.5		35					
23	SS	35.5	37.0	12-15-20	1.2							
24	SS	37.0	38.5	12-14-25	1.1							
25	SS	38.5	40.0	12-18-25	1.3		40				39.5 Bottom of screen.	
26	SS	41.7	43.2	12-18-20	1.0						40.5 Bottom of gravel pack.	
27	SS	44.2	45.7	11-16-19	1.3		45					
28	SS	46.7	48.2	8-11-12	1.5							

TYPE OF CASING USED				<i>Continued Next Page</i>			
		NQ-2 ROCK CORE		PIEZOMETER TYPE: PT = OPEN TUBE POROUS TIP, SS = OPEN TUBE SLOTTED SCREEN, G = GEONOR, P = PNEUMATIC			
X		6" x 3.25 HSA		WELL TYPE: OW = OPEN TUBE, GM = GEOMON			
X		9" x 6.25 HSA		RECORDER _____			
		HW CASING ADVANCER 4"					
		NW CASING 3"					
		SW CASING 6"					

AMERICAN ELECTRIC POWER SERVICE CORPORATION

AEP CIVIL ENGINEERING LABORATORY

LOG OF BORING



JOB NUMBER _____

COMPANY **INDIANA MICHIGAN POWER COMPANY**

BORING NO. **9245** DATE _____ SHEET **2** OF **2**

PROJECT **ROCKPORT PLANT**

BORING START **09/28/92** BORING FINISH **10/06/92**

SAMPLE NUMBER	SAMPLE	SAMPLE DEPTH IN FEET		STANDARD PENETRATION RESISTANCE BLOWS / 6"	TOTAL LENGTH RECOVERY	RQD %	DEPTH IN FEET	GRAPH LOG	U S C S	SOIL / ROCK IDENTIFICATION	WELL	DRILLER'S NOTES	
		FROM	TO										
29	SS	49.2	50.7	10-11-12	.9								
30	SS	50.7	52.2	9-16-26	1.2								
31	SS	52.2	53.7	8-19-22	1.4							51.8 Top of bentonite seal.	
32	SS	53.7	55.2	10-14-17	1.0		55			GRAY SAND medium grain.			
33	SS	55.2	56.7	11-16-23	1.0					MEDIUM TO COURSE GRAIN WITH 1" SEAM OF COAL 55.3 TO 55.4.		56.3 Top of screen.	
34	SS	56.7	58.2	8-14-20	1.0								56.8 Top of gravel pack.
35	SS	58.2	59.7	10-16-24	1.5		60						
36	SS	61.7	63.2	8-14-17	1.2								
37	SS	64.2	66.7	14-17-19	.9		65						
38	SS	66.7	68.2	15-35-29	1.3							66.4 Bottom of screen.	
39	SS	69.2	69.4	50/2	.1					GRAY CLAY SHALE		67.4 Bottom of gravel pack. Holes were drilled with 6.25 augers and stainless steel plates remaining in hole. Seal were premade bentonite donuts. 56.5-57.9 and 65.7-67.1 spacer.	

AMERICAN ELECTRIC POWER SERVICE CORPORATION
 AEP CIVIL ENGINEERING LABORATORY
 MONITORING WELL CONSTRUCTION




JOB NUMBER _____
 COMPANY **INDIANA MICHIGAN POWER COMPANY** WELL No. **MW-18** BORING No. **MW-18** INSTALLED **10/26/04**
 PROJECT **ROCKPORT PLANT**
 COORDINATES **N 161,048.3 E 518,397.6**
 SYSTEM _____




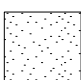

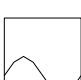
5/31/2016
Top of Ground 398.30

MW-18

5/31/2016
Reference Point
400.65
(top of 2" PVC pipe)

GROUND ELEVATION 397.88 FT.

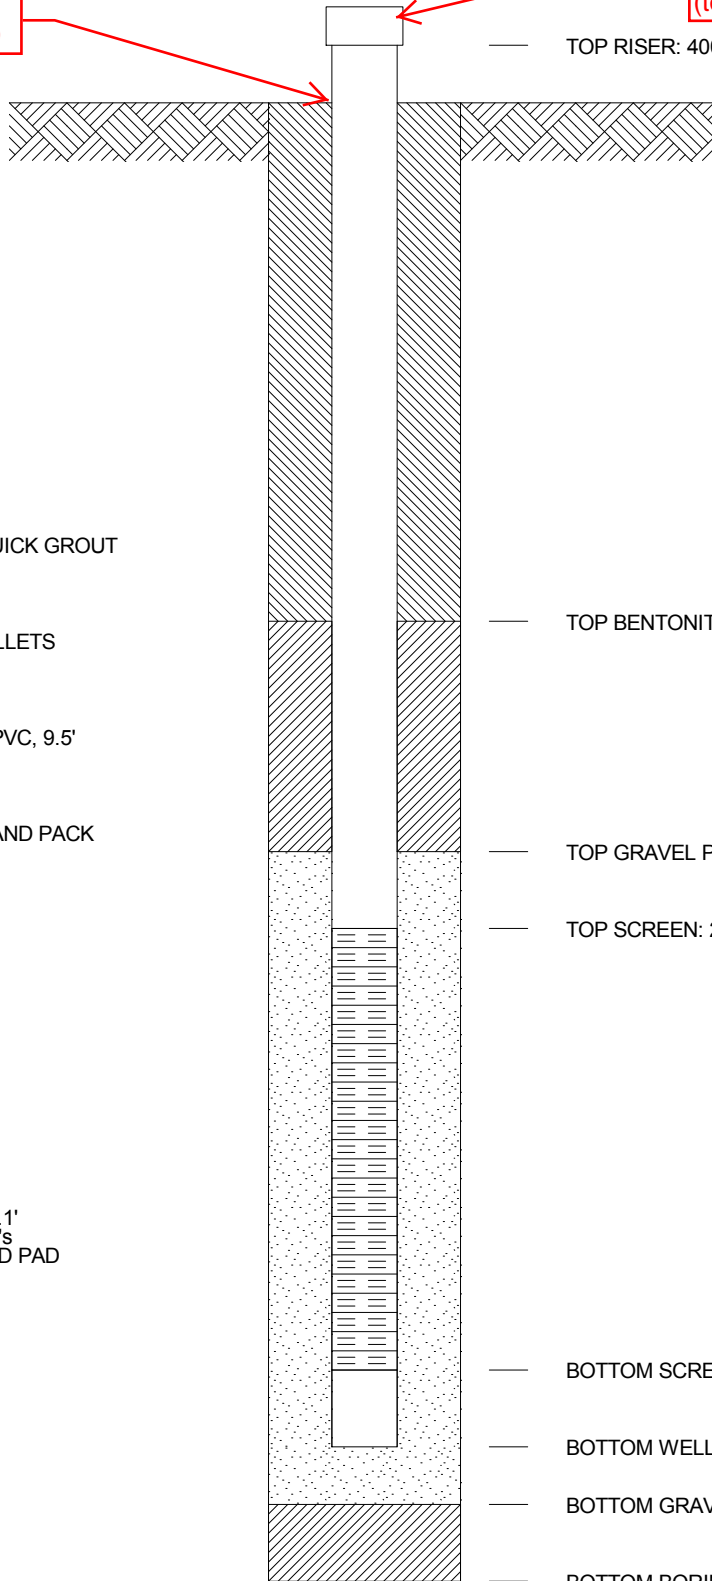

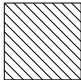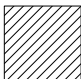-  GROUT SEAL: 300 gallons QUICK GROUT
-  BENTONITE SEAL: 50 lbs PELLETS
-  SCREEN: 2" dia., .020 SLOT PVC, 9.5'
-  GRAVEL PACK: NATURAL SAND PACK
-  RISER PIPE: 2", dia., PVC
-  SPACERS, DEPTH:

-SWL @ INSTALLATION = 42.1'
 -INSTALLED WITH 4.25" HSA's
 -SET PROTECTOR & POURED PAD

AMERICAN ELECTRIC POWER SERVICE CORPORATION
AEP CIVIL ENGINEERING LABORATORY
 LOG OF BORING



JOB NUMBER _____
 COMPANY **INDIANA MICHIGAN POWER COMPANY**
 PROJECT **ROCKPORT PLANT**
 COORDINATES **N 161,048.3 E 518,397.6**
 GROUND ELEVATION **397.9** SYSTEM _____

BORING NO. **MW-18** DATE **9/9/15** SHEET **1** OF **4**
 BORING START **10/25/04** BORING FINISH **10/26/04**
 PIEZOMETER TYPE **SS** WELL TYPE **OW**
 HGT. RISER ABOVE GROUND **2.5** DIA **2"**
 DEPTH TO TOP OF WELL SCREEN **99.7** BOTTOM **108.7**
 WELL DEVELOPMENT _____ BACKFILL **QUICK GROUT**
 FIELD PARTY **MCR / TLS** RIG **BK-81**

Water Level, ft	<input type="checkbox"/>	<input type="checkbox"/>	<input type="checkbox"/>
TIME			
DATE			

SAMPLE NUMBER	SAMPLE	SAMPLE DEPTH IN FEET		STANDARD PENETRATION RESISTANCE BLOWS / 6"	TOTAL LENGTH RECOVERY	RQD %	DEPTH IN FEET	GRAPHIC LOG	USCS	SOIL / ROCK IDENTIFICATION	WELL	DRILLER'S NOTES
		FROM	TO									
1	SS	0.0	2.0	2-3-4	1.3		5			MEDIUM STIFF 5Y 5/6 LIGHT OLIVE BROWN CLAY 1.0 tsf, w/ little amount of fine sand, dry		Boring drilled for the Effluent Dilution System.
2	SS	2.0	3.5	3-4-9	1.5		10			STIFF 5Y 4/4 MODERATE OLIVE BROWN CLAY 2.5 tsf, w/ some fine sand, dry		
3	SS	7.0	8.5	2-2-4	1.5		15			MEDIUM STIFF 10YR 6/6 DARK YELLOWISH ORANGE CLAY 1.0 tsf, w/ trace of fine sand, moist		
4	SS	12.0	13.5	6-8-10	1.5		20			MEDIUM DENSE 5YR 6/4 LIGHT BROWN MEDIUM GRAIN SAND w/ little amount of clay, moist		
5	SS	17.0	18.5	6-8-12	1.5		25			MEDIUM DENSE 5YR 5/6 LIGHT BROWN MEDIUM GRAIN SAND w/ fine gravel, wet		
6	SS	22.0	23.5	5-6-11	1.3							

TYPE OF CASING USED

<input checked="" type="checkbox"/>	NQ-2 ROCK CORE	
<input type="checkbox"/>	6" x 3.25 HSA	
<input type="checkbox"/>	9" x 6.25 HSA	
<input type="checkbox"/>	HW CASING ADVANCER	4"
<input type="checkbox"/>	NW CASING	3"
<input type="checkbox"/>	SW CASING	6"
<input type="checkbox"/>	AIR HAMMER	8"

Continued Next Page

PIEZOMETER TYPE: PT = OPEN TUBE POROUS TIP, SS = OPEN TUBE SLOTTED SCREEN, G = GEONOR, P = PNEUMATIC
 WELL TYPE: OW = OPEN TUBE SLOTTED SCREEN, GM = GEOMON

RECORDER **TLS**

AMERICAN ELECTRIC POWER SERVICE CORPORATION
AEP CIVIL ENGINEERING LABORATORY
 LOG OF BORING



JOB NUMBER _____

COMPANY **INDIANA MICHIGAN POWER COMPANY**

BORING NO. **MW-18** DATE **9/9/15** SHEET **2** OF **4**

PROJECT **ROCKPORT PLANT**

BORING START **10/25/04** BORING FINISH **10/26/04**

SAMPLE NUMBER	SAMPLE	SAMPLE DEPTH IN FEET		STANDARD PENETRATION RESISTANCE BLOWS / 6"	TOTAL LENGTH RECOVERY	RQD	DEPTH IN FEET	GRAPHIC LOG	USCS	SOIL / ROCK IDENTIFICATION	WELL	DRILLER'S NOTES	
		FROM	TO			%							
7	SS	32.0	33.5	4-4-4	1.5		35			LOOSE 5YR 5/6 LIGHT BROWN MEDIUM GRAIN SAND w/ little amount of fine gravel, wet		With HSA's to 37', had a 15 hour SWL of 27.5' Washed heaving sand out of HSA's @ 37.0'. Started inducing water into HSA's @ 37' to prevent heaving sands.	
8	SS	37.0	38.5	6-8-11	1.3		40			MEDIUM DENSE 10YR 5/4 MODERATE YELLOWISH BROWN MEDIUM GRAIN SAND w/ fine gravel, wet			
9	SS	42.0	43.5	6-12-13	1.5		45			LOOSE 5YR 5/6 LIGHT BROWN FINE GRAIN SAND wet			
10	SS	47.0	48.5	4-5-4	1.5		50			LOOSE 10YR 4/2 DARK YELLOWISH BROWN FINE GRAVEL wet			
11	SS	52.0	53.5	5-6-10	1.5		55			MEDIUM DENSE 10YR 5/4 MODERATE YELLOWISH BROWN MEDIUM GRAIN SAND w/ some fine gravel, wet Trace to little coal			
12	SS	57.0	58.5	4-4-5	1.5		60			MEDIUM DENSE 10YR 6/2 PALE YELLOWISH BROWN COARSE GRAIN SAND w/ little amount of fine gravel, trace of coal, wet			
13	SS	62.0	63.5	10-8-8	1.5		65			MEDIUM DENSE 5YR 5/6 LIGHT BROWN COARSE GRAIN SAND w/ fine gravel, wet			
14	SS	67.0	68.5	6-8-8	1.5								

Continued Next Page

AEP_RK_PLANT.GPJ AEP.GDT 9/9/15

AMERICAN ELECTRIC POWER SERVICE CORPORATION
AEP CIVIL ENGINEERING LABORATORY
 LOG OF BORING



JOB NUMBER _____

COMPANY **INDIANA MICHIGAN POWER COMPANY**

BORING NO. **MW-18** DATE **9/9/15** SHEET **3** OF **4**

PROJECT **ROCKPORT PLANT**

BORING START **10/25/04** BORING FINISH **10/26/04**

SAMPLE NUMBER	SAMPLE	SAMPLE DEPTH IN FEET		STANDARD PENETRATION RESISTANCE BLOWS / 6"	TOTAL LENGTH RECOVERY	RQD	DEPTH IN FEET	GRAPHIC LOG	USCS	SOIL / ROCK IDENTIFICATION	WELL	DRILLER'S NOTES
		FROM	TO			%						
							70					
15	SS	72.0	73.5	14-5-8	1.5							
							75					
16	SS	77.0	78.5	5-5-6	1.5					MEDIUM DENSE 5YR 4/4 MODERATE BROWN COARSE GRAIN SAND w/ little amount of fine gravel, wet		
							80			Trace of coal		
17	SS	82.0	83.5	4-4-7	0.9							
							85					
18	SS	87.0	88.5	6-4-5	1.5							
							90					
19	SS	92.0	93.5	4-4-6	1.3					LOOSE 10YR 4/2 DARK YELLOWISH BROWN COARSE GRAIN SAND w/ little amount of fine gravel, trace of coal, wet		
							95					
20	SS	97.0	98.5	5-5-8	1.5					MEDIUM DENSE 5YR 5/6 LIGHT BROWN MEDIUM GRAIN SAND w/ trace of fine gravel, wet		
							100					
21	SS	102.0	103.5	2-4-5	1.5					LOOSE 5YR 5/6 LIGHT BROWN MEDIUM GRAIN SAND w/ trace of fine gravel, wet		
							105					
22	SS	107.0	108.5	15-15-20	1.1					DENSE 5YR 5/6 LIGHT BROWN COARSE		

AEP_RK_PLANT.GPJ AEP.GDT 9/9/15

Continued Next Page

AMERICAN ELECTRIC POWER SERVICE CORPORATION
 AEP CIVIL ENGINEERING LABORATORY
 MONITORING WELL CONSTRUCTION




JOB NUMBER _____
 COMPANY **INDIANA MICHIGAN POWER COMPANY** WELL No. **MW-19** BORING No. **MW-19** INSTALLED **11/4/04**
 PROJECT **ROCKPORT PLANT**
 COORDINATES **N 161,159.0 E 518,561.3**
 SYSTEM _____


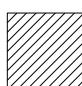



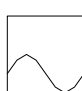
5/31/2016
 Top of Ground 399.15

MW-19

5/31/2016
 Reference Point
 401.44
 (top of 2" PVC pipe)

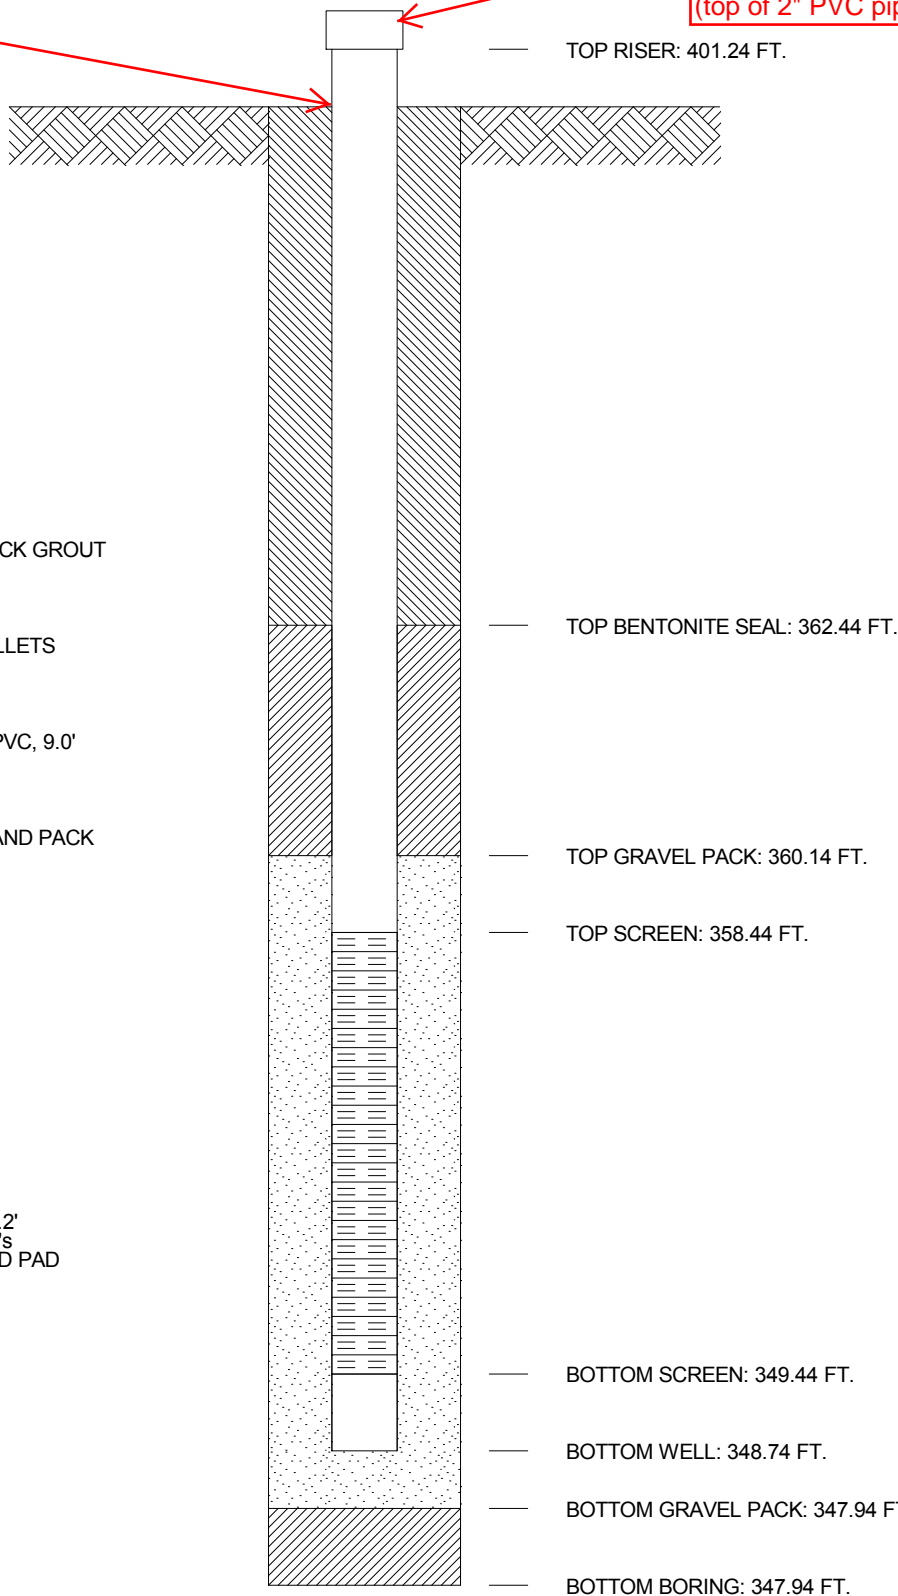GROUND ELEVATION 398.74 FT.



-  GROUT SEAL: 80 gallons QUICK GROUT
-  BENTONITE SEAL: 40 lbs PELLETS
-  SCREEN: 2" dia., .020 SLOT PVC, 9.0'
-  GRAVEL PACK: NATURAL SAND PACK
-  RISER PIPE: 2", dia., PVC
-  SPACERS, DEPTH:

-SWL @ INSTALLATION = 30.2'
 -INSTALLED WITH 4.25" HSA's
 -SET PROTECTOR & POURED PAD

AMERICAN ELECTRIC POWER SERVICE CORPORATION
AEP CIVIL ENGINEERING LABORATORY
 LOG OF BORING



JOB NUMBER _____
 COMPANY **INDIANA MICHIGAN POWER COMPANY**
 PROJECT **ROCKPORT PLANT**
 COORDINATES **N 161,159.0 E 518,561.3**
 GROUND ELEVATION **398.7** SYSTEM _____

BORING NO. **MW-19** DATE **9/9/15** SHEET **1** OF **2**
 BORING START **11/3/04** BORING FINISH **11/4/04**
 PIEZOMETER TYPE **SS** WELL TYPE **OW**
 HGT. RISER ABOVE GROUND **2.5** DIA **2"**
 DEPTH TO TOP OF WELL SCREEN **40.3** BOTTOM **49.3**
 WELL DEVELOPMENT _____ BACKFILL **QUICK GROUT**
 FIELD PARTY **MCR / CB** RIG **BK-81**

Water Level, ft	<input type="checkbox"/>	<input type="checkbox"/>	<input type="checkbox"/>
TIME			
DATE			

SAMPLE NUMBER	SAMPLE	SAMPLE DEPTH IN FEET		STANDARD PENETRATION RESISTANCE BLOWS / 6"	TOTAL LENGTH RECOVERY	RQD %	DEPTH IN FEET	GRAPHIC LOG	USCS	SOIL / ROCK IDENTIFICATION	WELL	DRILLER'S NOTES
		FROM	TO									
1	SS	0.0	1.9	3-3-5	1.5							Boring drilled for the Effluent Dilution System.
		1.9	3.4				5			MEDIUM STIFF 10YR 5/4 MODERATE YELLOWISH BROWN SILTY CLAY 0.75 tsf, w/ some fine sand, dry		
2	SS	6.9	8.4	5-6-8	1.5					STIFF 10YR 5/4 MODERATE YELLOWISH BROWN SILTY CLAY 2.25 tsf, w/ trace of fine sand, dry LOOSE 5YR 5/6 LIGHT BROWN FINE SAND		
3	SS	11.9	13.4	2-2-3	1.5					MEDIUM STIFF 5YR 4/4 MODERATE BROWN SILT w/ little amount of fine sand, moist		
4	SS	16.9	18.4	3-6-8	0.8					MEDIUM DENSE 10YR 6/6 DARK YELLOWISH ORANGE FINE GRAIN SAND dry		
5	SS	21.9	23.4	7-9-10	1.0					MEDIUM DENSE 10YR 6/6 DARK YELLOWISH ORANGE FINE GRAIN SAND w/ trace of fine gravel, dry		
6	SS	26.9	28.4	3-3-5	0.8					LOOSE 10YR 5/4 MODERATE YELLOWISH BROWN FINE GRAIN SAND moist		

TYPE OF CASING USED

<input checked="" type="checkbox"/>	NQ-2 ROCK CORE	
<input type="checkbox"/>	6" x 3.25 HSA	
<input type="checkbox"/>	9" x 6.25 HSA	
<input type="checkbox"/>	HW CASING ADVANCER	4"
<input type="checkbox"/>	NW CASING	3"
<input type="checkbox"/>	SW CASING	6"
<input type="checkbox"/>	AIR HAMMER	8"

Continued Next Page

PIEZOMETER TYPE: PT = OPEN TUBE POROUS TIP, SS = OPEN TUBE SLOTTED SCREEN, G = GEONOR, P = PNEUMATIC
 WELL TYPE: OW = OPEN TUBE SLOTTED SCREEN, GM = GEOMON

RECORDER **MCR**

AEP_RK_PLANT.GPJ AEP.GDT 9/9/15

AMERICAN ELECTRIC POWER SERVICE CORPORATION
AEP CIVIL ENGINEERING LABORATORY
 LOG OF BORING



JOB NUMBER _____

COMPANY **INDIANA MICHIGAN POWER COMPANY**

BORING NO. **MW-19** DATE **9/9/15** SHEET **2** OF **2**

PROJECT **ROCKPORT PLANT**

BORING START **11/3/04** BORING FINISH **11/4/04**

SAMPLE NUMBER	SAMPLE	SAMPLE DEPTH IN FEET		STANDARD PENETRATION RESISTANCE BLOWS / 6"	TOTAL LENGTH RECOVERY	RQD	DEPTH IN FEET	GRAPHIC LOG	USCS	SOIL / ROCK IDENTIFICATION	WELL	DRILLER'S NOTES
		FROM	TO			%						
7	SS	31.9	33.4	2-3-3	0.8		35			LOOSE 10YR 4/2 DARK YELLOWISH BROWN MEDIUM GRAIN SAND w/ little fine gravel, wet		
8	SS	36.9	38.4	4-6-9	0.7		40			MEDIUM DENSE 10YR 4/2 DARK YELLOWISH BROWN MEDIUM GRAIN SAND w/ little fine gravel, wet		
9	SS	41.9	43.4	3-6-7	0.8		45			MEDIUM DENSE 10YR 5/4 MODERATE YELLOWISH BROWN FINE GRAIN SAND moist		
10	SS	46.9	48.4	7-10-11	0.5		50			MEDIUM DENSE 10YR 4/2 DARK YELLOWISH BROWN MEDIUM GRAIN SAND w/ little fine gravel, wet		
												Stopped boring @ 50.8' on 11/04/04. Installed 2" well. See well log.

AMERICAN ELECTRIC POWER SERVICE CORPORATION
 AEP CIVIL ENGINEERING LABORATORY
 MONITORING WELL CONSTRUCTION



JOB NUMBER _____
 COMPANY **INDIANA MICHIGAN POWER COMPANY** WELL No. **MW-20** BORING No. **MW-20** INSTALLED **11/3/04**
 PROJECT **ROCKPORT PLANT**
 COORDINATES **N 160,996.7 E 518,492.4**
 SYSTEM _____




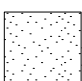


5/31/2016
 Top of Ground 398.49

5/31/2016
 Reference Point
 400.78
 (top of 2" PVC pipe)

GROUND ELEVATION 398.02 FT.

MW-20

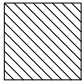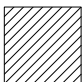TOP RISER: 400.52 FT.

-  GROUT SEAL: 80 gallons QUICK GROUT
-  BENTONITE SEAL: 50 lbs PELLETS
-  SCREEN: 2" dia., .020 SLOT PVC, 9.0'
-  GRAVEL PACK: NATURAL SAND PACK
-  RISER PIPE: 2", dia., PVC
-  SPACERS, DEPTH:

TOP BENTONITE SEAL: 361.32 FT.

TOP GRAVEL PACK: 359.62 FT.

TOP SCREEN: 357.22 FT.

-SWL @ INSTALLATION = 34.8'
 -INSTALLED WITH 4.25" HSA's
 -SET PROTECTOR & POURED PAD

BOTTOM SCREEN: 348.22 FT.

BOTTOM WELL: 347.52 FT.

BOTTOM GRAVEL PACK: 347.52 FT.

BOTTOM BORING: 347.02 FT.

AMERICAN ELECTRIC POWER SERVICE CORPORATION
AEP CIVIL ENGINEERING LABORATORY
 LOG OF BORING



JOB NUMBER _____
 COMPANY **INDIANA MICHIGAN POWER COMPANY**
 PROJECT **ROCKPORT PLANT**
 COORDINATES **N 160,996.7 E 518,492.4**
 GROUND ELEVATION **398.0** SYSTEM _____

BORING NO. **MW-20** DATE **9/9/15** SHEET **1** OF **2**
 BORING START **10/27/04** BORING FINISH **11/3/04**
 PIEZOMETER TYPE **SS** WELL TYPE **OW**
 HGT. RISER ABOVE GROUND **2.5** DIA **2"**
 DEPTH TO TOP OF WELL SCREEN **40.8** BOTTOM **49.8**
 WELL DEVELOPMENT _____ BACKFILL **QUICK GROUT**
 FIELD PARTY **MCR / TLS** RIG **BK-81**

Water Level, ft	<input type="checkbox"/>	<input type="checkbox"/>	<input type="checkbox"/>
TIME			
DATE			

SAMPLE NUMBER	SAMPLE	SAMPLE DEPTH IN FEET		STANDARD PENETRATION RESISTANCE BLOWS / 6"	TOTAL LENGTH RECOVERY	RQD %	DEPTH IN FEET	GRAPHIC LOG	USCS	SOIL / ROCK IDENTIFICATION	WELL	DRILLER'S NOTES
		FROM	TO									
1	SS	0.0	1.8	4-6-5	1.5					STIFF 5YR 5/6 LIGHT BROWN CLAY 1.5 tsf, w/ some fine sand		Boring drilled for the Effluent Dilution System. Weight of hammer pushed spoon With HSA's to 38.3', had a 168 hour SWL of 23.4'
2	SS	1.8	3.3	2-4-4	1.5	5			MEDIUM STIFF MOTTLED 5YR 5/6 LIGHT BROWN & 10Y 6/2 PALE OLIVE CLAY 1.75 tsf, w/ little fine sand			
3	SS	6.8	8.3	0-0-0	1.4	10			SOFT 5YR 3/2 GRAYISH BROWN CLAY 0 tsf			
4	SS	11.8	13.3	3-6-7	1.5	15			MEDIUM STIFF 10YR 5/4 MODERATE YELLOWISH BROWN CLAY w/ SAND 0.5 tsf			
5	SS	16.8	18.3	4-6-8	1.5	20			MEDIUM DENSE 5YR 5/6 LIGHT BROWN COARSE SAND			
6	SS	21.8	23.3	4-7-9	1.5	25			MEDIUM DENSE 10YR 5/4 MODERATE YELLOWISH BROWN COARSE SAND w/ some fine gravel			
6	SS	26.8	28.3	4-7-9	1.5							

TYPE OF CASING USED

<input checked="" type="checkbox"/>	NQ-2 ROCK CORE	
<input type="checkbox"/>	6" x 3.25 HSA	
<input type="checkbox"/>	9" x 6.25 HSA	
<input type="checkbox"/>	HW CASING ADVANCER	4"
<input type="checkbox"/>	NW CASING	3"
<input type="checkbox"/>	SW CASING	6"
<input type="checkbox"/>	AIR HAMMER	8"

Continued Next Page

PIEZOMETER TYPE: PT = OPEN TUBE POROUS TIP, SS = OPEN TUBE SLOTTED SCREEN, G = GEONOR, P = PNEUMATIC
 WELL TYPE: OW = OPEN TUBE SLOTTED SCREEN, GM = GEOMON

RECORDER **TLS**

AEP_RK_PLANT.GPJ AEP.GDT 9/9/15

AMERICAN ELECTRIC POWER SERVICE CORPORATION
AEP CIVIL ENGINEERING LABORATORY
 LOG OF BORING



JOB NUMBER _____

COMPANY **INDIANA MICHIGAN POWER COMPANY**

BORING NO. **MW-20** DATE **9/9/15** SHEET **2** OF **2**

PROJECT **ROCKPORT PLANT**

BORING START **10/27/04** BORING FINISH **11/3/04**

SAMPLE NUMBER	SAMPLE	SAMPLE DEPTH IN FEET		STANDARD PENETRATION RESISTANCE BLOWS / 6"	TOTAL LENGTH RECOVERY	RQD	DEPTH IN FEET	GRAPHIC LOG	USCS	SOIL / ROCK IDENTIFICATION	WELL	DRILLER'S NOTES
		FROM	TO			%						
7	SS	31.8	33.3	3-5-6	1.5		35			MEDIUM DENSE 10YR 4/4 MODERATE BROWN COARSE SAND w/ some fine gravel		
8	SS	36.8	38.3	3-6-7	1.0		40					
9	SS	41.8	43.3	7-7-13	1.0		45			MEDIUM DENSE 10YR 4/2 DARK YELLOWISH BROWN MEDIUM GRAIN SAND w/ little fine gravel, wet		
10	SS	46.8	48.3	6-6-14	1.0		50			MEDIUM DENSE 5YR 5/2 PALE BROWN MEDIUM GRAIN SAND w/ trace of fine gravel, wet		
												Stopped boring @ 51.0' on 11/03/04. Installed 2" well. See well log.

AMERICAN ELECTRIC POWER SERVICE CORPORATION
 AEP CIVIL ENGINEERING LABORATORY
 MONITORING WELL CONSTRUCTION



JOB NUMBER **40881154-01**

COMPANY **AMERICAN ELECTRIC POWER**

WELL No. **S-21**

BORING No. **B-0821S**

INSTALLED **1/13/09**

PROJECT **ROCKPORT LANDFILL**

MW-21S

COORDINATES **N 161,298.6 E 520,310.8**







5/31/2016
 Reference Point
 400.77
 (top of 2" PVC pipe)

SYSTEM _____

5/31/2016
 Top of Ground 398.70

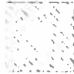GROUND ELEVATION 398.57 FT.

TOP RISER: 400.76 FT.

-  GROUT SEAL: Quick Grout 75 gals
-  BENTONITE SEAL: 3/8" Coated Bentonite Pellets 75 lbs
-  SCREEN: 2" dia., 0.020 Slot Sch 40, 10'
-  GRAVEL PACK: #4 Quartz Sand 350 lbs
-  RISER PIPE: 2", dia., Sch 40
-  SPACERS, DEPTH: 20'

TOP BENTONITE SEAL: 374.97 FT.

TOP GRAVEL PACK: 372.67 FT.

TOP SCREEN: 369.77 FT.

- Drilled w/6.25" HSA's w/stainless steel plate
- SWL @ Install N/A
- Added water to hydrate pellets
- Developed well
- Installing well wizard bladder pump @ later date
- Drill water from on site production well

BOTTOM SCREEN: 359.27 FT.

BOTTOM WELL: 358.67 FT.

BOTTOM GRAVEL PACK: 358.57 FT.

BOTTOM BORING: 358.57 FT.

AMERICAN ELECTRIC POWER SERVICE CORPORATION
 AEP CIVIL ENGINEERING LABORATORY
 MONITORING WELL CONSTRUCTION



JOB NUMBER 40881154-01

COMPANY AMERICAN ELECTRIC POWER

PROJECT ROCKPORT LANDFILL

COORDINATES N 161,299.5 E 520,291.1

SYSTEM _____

WELL No. I-21

BORING No. B-0821I

INSTALLED 1/13/09

MW-21I

5/31/2016
 Reference Point
 400.72
 (top of 2" PVC pipe)

5/31/2016
 Top of Ground 398.23

GROUND ELEVATION 398.52 FT.

TOP RISER: 400.74 FT.



GROUT SEAL: Quick Grout 250 gals

BENTONITE SEAL: 3/8" Coated Bentonite Pellets 50 lbs

SCREEN: 2" dia., 0.020 Slot Sch 40, 10'

GRAVEL PACK: #4 Quartz Sand 325 lbs

RISER PIPE: 2", dia., Sch 40

SPACERS, DEPTH: 40'

TOP BENTONITE SEAL: 350.12 FT.

TOP GRAVEL PACK: 347.52 FT.

TOP SCREEN: 345.42 FT.

BOTTOM SCREEN: 335.92 FT.

BOTTOM WELL: 335.32 FT.

BOTTOM GRAVEL PACK: 335.32 FT.

BOTTOM BORING: 335.32 FT.

- Drilled w/6.25" HSA's w/stainless steel plate
- SWL @ Install N/A
- Added water to hydrate pellets
- Developed well
- Installing well wizard bladder pump @ later date
- Drill water from on site production well

AMERICAN ELECTRIC POWER SERVICE CORPORATION
 AEP CIVIL ENGINEERING LABORATORY
 MONITORING WELL CONSTRUCTION



JOB NUMBER 40881154-01

COMPANY AMERICAN ELECTRIC POWER

WELL No D-21

BORING No. B-0821D

INSTALLED 1/13/09

PROJECT ROCKPORT LANDFILL

MW-21D

5/31/2016
 Reference Point
 400.67
 (top of 2" PVC pipe)







COORDINATES N 161,298.3 E 520,300.3

SYSTEM _____

5/31/2016
 Top of Ground 398.58

GROUND ELEVATION 398.62 FT.

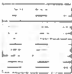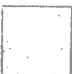TOP RISER: 490.70 FT.

-  GROUT SEAL: Quick Grout 650 gals
-  BENTONITE SEAL: 3/8" Coated Bentonite Pellets 75 lbs
-  SCREEN: 2" dia., 0.020 Slot Sch 40, 10.0
-  GRAVEL PACK: #4 Quartz Sand 325 lbs
-  RISER PIPE: 2", dia., Sch 40
-  SPACERS, DEPTH: 80', 30'

TOP BENTONITE SEAL: 304.52 FT.

TOP GRAVEL PACK: 302.62 FT.

TOP SCREEN: 300.42 FT.

BOTTOM SCREEN: 290.92 FT.

BOTTOM WELL: 290.32 FT.

BOTTOM GRAVEL PACK: 288.62 FT.

BOTTOM BORING: 288.62 FT.

- Drilled w/6.25" HSA's w/stainless steel plate
- SWL @ Install N/A
- Added water to hydrate pellets
- Developed well
- Installing well wizard bladder pump @ later date
- Drill water from on site production well

**AMERICAN ELECTRIC POWER SERVICE CORPORATION
AEP CIVIL ENGINEERING LABORATORY
LOG OF BORING**



JOB NUMBER 40881154-01

COMPANY AMERICAN ELECTRIC POWER

BORING NO. B-0821 DATE 4/29/09 SHEET 1 OF 5

PROJECT ROCKPORT LANDFILL

BORING START 1/6/09 BORING FINISH 1/13/09

COORDINATES N 161,298.3 E 520,300.3

PIEZOMETER TYPE _____ WELL TYPE _____

GROUND ELEVATION 398.6 SYSTEM State Plane using NAD83/2D

HGT. RISER ABOVE GROUND _____ DIA _____

Water Level, R	<input type="checkbox"/>	<input type="checkbox"/>	<input type="checkbox"/>
TIME			
DATE			

DEPTH TO TOP OF WELL SCREEN _____ BOTTOM _____

WELL DEVELOPMENT _____ BACKFILL _____

FIELD PARTY ZLR / RMP RIG D-120

SAMPLE NUMBER	SAMPLE	SAMPLE DEPTH IN FEET		STANDARD PENETRATION RESISTANCE BLOWS / 6"	TOTAL LENGTH RECOVERY	RQD %	DEPTH IN FEET	GRAPHIC LOG	USCS	SOIL / ROCK IDENTIFICATION	WELL	DRILLER'S NOTES
		FROM	TO									
	AUGER	0.0	1.9							OVERBURDEN		<p>SAMPLES COLLECTED JAN 6-13, 2009, BY AEP DRILLERS AND LOGGED ON JAN 30, 2009, BY M K ADKINS.</p> <p>NOTE #1: NO REFERENCE TO MOISTURE CONTENT BECAUSE ALL SAMPLES WERE DAMP TO SATURATED AND HAD BEEN IN STORAGE.</p> <p>NOTE #2: NO REFERENCE TO SORTING BECAUSE SAMPLES HAD BEEN DISTURBED DURING COLLECTION.</p> <p>NOTE #3: SAMPLES WERE COLLECTED OVER 1.5' INTERVALS SPACED @ 2.5'.</p>
1	SPT	1.9	3.4	4-7-11	1.5					CLAY STIFF, SILTY, ABUNDANT Fe STAINING, MINOR ROOT TRACES, MINOR SIDERITE CONCRETIONS, 5Y 7/2		
2	SPT	6.9	8.4	3-3-5	1.5	5				SAND MEDIUM TO DARK BROWN, SILTY, MINOR CLAY, FINE GRAIN, 5YR 5/2 TO 5YR 3/2		
3	SPT	11.9	13.4	3-4-5	1.2	10				SAND MEDIUM DARK BROWN, SLIGHTLY SILTY, FINE GRAIN, 5YR 3/2		
4	SPT	16.9	18.4	6-9-11	1.2	15				SAND MEDIUM DARK BROWN, SLIGHTLY SILTY, MINOR FINE TO MEDIUM GRAIN, VERY MINOR (<1%) WELL ROUNDED QUARTZ PEBBLES, ~0.25 CM DIAMETER, 5YR 3/2		

TYPE OF CASING USED

Continued Next Page

NO-2 ROCK CORE	
6" x 3.25 HSA	
9" x 6.25 HSA	
HW CASING ADVANCER	4'
NW CASING	3'
SW CASING	6'
AIR HAMMER	8'

PIEZOMETER TYPE: PT = OPEN TUBE POROUS TIP, SS = OPEN TUBE SLOTTED SCREEN, G = GEONOR, P = PNEUMATIC

WELL TYPE: OW = OPEN TUBE SLOTTED SCREEN, GM = GEOMON

RECORDER MKA

AEP ROCKPORT LANDFILL.GPJ AEP.GDT 4/29/09

AMERICAN ELECTRIC POWER SERVICE CORPORATION
 AEP CIVIL ENGINEERING LABORATORY
 LOG OF BORING



JOB NUMBER 40881154-01

COMPANY AMERICAN ELECTRIC POWER

BORING NO. B-0821

DATE 4/29/09

SHEET 2 OF 5

PROJECT ROCKPORT LANDFILL

BORING START 1/6/09

BORING FINISH 1/13/09

SAMPLE NUMBER	SAMPLE	SAMPLE DEPTH IN FEET		STANDARD PENETRATION RESISTANCE BLOWS / 6"	TOTAL LENGTH RECOVERY	RQD	DEPTH IN FEET	GRAPHIC LOG	USCS	SOIL / ROCK IDENTIFICATION	WELL	DRILLER'S NOTES
		FROM	TO			%						
5	SPT	21.9	28.4	11-14-18	1.3		25			SAND MEDIUM DARK BROWN, SLIGHTLY SILTY, FINE TO MEDIUM GRAIN, W/ ~15% WELL ROUNDED QUARTZ PEBBLES, UP TO 1 CM DIAMETER, 5YR 3/2		
6	SPT	26.9	28.4	8-11-14	1.3		30			SAND MEDIUM DARK BROWN, SLIGHTLY SILTY, FINE TO COARSE GRAIN, W/ ~1% WELL ROUNDED QUARTZ PEBBLES, UP TO 1 CM DIAMETER, 5YR 3/2		
7	SPT	31.9	33.4	7-8-12	1.4		35			SAND MEDIUM DARK BROWN, SLIGHTLY SILTY, FINE TO COARSE GRAIN, W/ ~10-15% WELL ROUNDED QUARTZ PEBBLES, UP TO 1 CM DIAMETER, 5YR 3/2		
8	SPT	38.9	38.4	9-10-9	1.5		40			SAND MEDIUM DARK BROWN, SLIGHTLY SILTY, FINE TO COARSE GRAIN, W/ ~30% WELL ROUNDED QUARTZ PEBBLES, UP TO 1.5 CM DIAMETER, 5YR 3/2		
9	SPT	41.9	43.4	5-7-11	1.2		45			SAND MEDIUM DARK BROWN SLIGHTLY SILTY, FINE TO COARSE GRAIN, W/ ~5-10% WELL ROUNDED QUARTZ PEBBLES, UP TO 1 CM DIAMETER, 5YR 3/2		

AEP ROCKPORT LANDFILL.GPJ AEP.GDT 4/29/09

Continued ext Page

AMERICAN ELECTRIC POWER SERVICE CORPORATION
 AEP CIVIL ENGINEERING LABORATORY
 LOG OF BORING



JOB NUMBER 40881154-01

COMPANY AMERICAN ELECTRIC POWER

BORING NO. B-0821 DATE 4/29/09 SHEET 3 OF 5

PROJECT ROCKPORT LANDFILL

BORING START 1/6/09 BORING FINISH 1/13/09

SAMPLE NUMBER	SAMPLE	SAMPLE DEPTH IN FEET		STANDARD PENETRATION RESISTANCE BLOWS / 6"	TOTAL LENGTH RECOVERY %	RQD %	DEPTH IN FEET	GRAPHIC LOG	USCS	SOIL / ROCK IDENTIFICATION	WELL	DRILLER'S NOTES
		FROM	TO									
10	SPT	48.9	48.4	5-7-14	1.5		50			SAND MEDIUM DARK BROWN, SLIGHTLY SILTY, FINE TO COARSE GRAIN, W/ ~5-10% WELL ROUNDED QUARTZ PEBBLES, UP TO 1 CM DIAMETER, 5YR 3/2		
11	SPT	51.9	53.4	5-9-13	1.3		55			SAND MEDIUM DARK BROWN, SLIGHTLY SILTY, FINE TO COARSE GRAIN, W/ ~5-10% WELL ROUNDED QUARTZ PEBBLES, UP TO 1 CM DIAMETER, 5YR 3/2		
12	SPT	56.9	58.4	8-8-14	1.3		60			SAND MEDIUM DARK BROWN, SLIGHTLY SILTY, FINE TO COARSE GRAIN, FRAGMENTS UP TO 2 CM DIAMETER, 5YR 3/2		
13	SPT	61.9	63.4	5-6-11	1.5		65			SAND MEDIUM DARK BROWN, SLIGHTLY SILTY, FINE TO COARSE GRAIN, W/ ~15% WELL ROUNDED QUARTZ PEBBLES, UP TO 0.5 CM DIAMETER, 5YR 3/2		
14	SPT	66.6	68.1	4-11-18	1.5		70			SAND MEDIUM DARK BROWN, SLIGHTLY SILTY, FINE TO COARSE GRAIN, W/ ~15% WELL ROUNDED QUARTZ PEBBLES, UP TO 0.5 CM DIAMETER, 5YR 3/2		

AEP ROCKPORT LANDFILL OPJ AEP-GOT 4/29/09

Continued Next Page

AMERICAN ELECTRIC POWER SERVICE CORPORATION
 AEP CIVIL ENGINEERING LABORATORY
 LOG OF BORING



JOB NUMBER 40881154-01

COMPANY AMERICAN ELECTRIC POWER

BORING NO. B-0821 DATE 4/29/09 SHEET 4 OF 5

PROJECT ROCKPORT LANDFILL

BORING START 1/6/09 BORING FINISH 1/13/09

SAMPLE NUMBER	SAMPLE	SAMPLE DEPTH IN FEET		STANDARD PENETRATION RESISTANCE BLOWS / 6"	TOTAL LENGTH RECOVERY %	RQD %	DEPTH IN FEET	GRAPHIC LOG	USCS	SOIL / ROCK IDENTIFICATION	WELL	DRILLER'S NOTES
		FROM	TO									
15	SPT	71.9	73.4	12-28-7	1.5					SAND FINE TO MEDIUM GRAIN, 5YR 3/2, W/SANDSTONE FRAGMENTS, POORLY CEMENTED, @LIVE GRAY 5GY 8/1		
							75					
16	SPT	76.9	78.4	7-11-12	1.5					SAND FINE TO COARSE GRAIN, W/15-20% WELL ROUNDED QUARTZ PEBBLES, UP TO 0.5 CM DIAMETER, 5YR 3/2		
							80					
17	SPT	81.9	83.4	2-5-5	1.5					SAND FINE TO COARSE GRAIN, W/15-20% WELL ROUNDED QUARTZ PEBBLES, UP TO 0.5 CM DIAMETER, 5YR 3/2		
							85					
18	SPT	86.9	88.4	2-3-7	1.5					SAND FINE TO COARSE GRAIN, W/15-20% WELL ROUNDED QUARTZ PEBBLES, UP TO 0.5 CM DIAMETER, 5YR 3/2		
							90					
19	SPT	91.9	93.4	3-5-9	1.5					SAND FINE TO COARSE GRAIN, W/5-10% WELL ROUNDED QUARTZ PEBBLES, W/ 0.5 CM DIAMETER, 5YR 3/2		
							95					
20	SPT	98.9	98.4	5-6-9	.9					SAND FINE TO COARSE GRAIN, W/5-10% WELL ROUNDED QUARTZ PEBBLES, W/ 0.5		

AEP ROCKPORT LANDFILL.GPJ AEP.GDT 4/29/09

Continued Next Page

AMERICAN ELECTRIC POWER SERVICE CORPORATION
 AEP CIVIL ENGINEERING LABORATORY
 LOG OF BORING



JOB NUMBER 40881154-01

COMPANY AMERICAN ELECTRIC POWER

BORING NO. B-0821 DATE 4/29/09 SHEET 5 OF 5

PROJECT ROCKPORT LANDFILL

BORING START 1/6/09 BORING FINISH 1/13/09

SAMPLE NUMBER	SAMPLE	SAMPLE DEPTH IN FEET		STANDARD PENETRATION RESISTANCE BLOWS / 6"	TOTAL LENGTH RECOVERY %	RQD %	DEPTH IN FEET	GRAPHIC LOG	USCS	SOIL / ROCK IDENTIFICATION	WELL	DRILLER'S NOTES
		FROM	TO									
										CM DIAMETER, 5YR 3/2		
21	SPT	101.9	103.4	3-3-6	1.0		100			SAND FINE GRAIN, W/5-10% WELL ROUNDED QUARTZ PEBBLES, W/ 0.5 CM DIAMETER, 5YR 4/4		
22	SPT	108.9	108.4	5-5-17	1.5		105			SAND FINE TO COARSE GRAIN, W/15% WELL ROUNDED QUARTZ PEBBLES, W/ 0.25 CM DIAMETER, 10YR 4/2		
23	SPT	108.9	109.8	2-50/4	.7		110			SAND FINE TO COARSE GRAIN, W/5-10% WELL ROUNDED QUARTZ PEBBLES, W/ 0.25 CM DIAMETER, 10YR 4/2		
24	SPT	111.9	112.2	50/3	.3					SANDSTONE POORLY CEMENTED W/INTERBEDDED CLAY/CLAYSTONE, 5B 7/1 TO 5B 5/1		

APPENDIX D
PIEZOMETRIC DATA


Appendix D-1

Ohio River Hydrograph, 2010-2015



AEP Rockport Plant

Ohio River Hydrograph, 2010-2015

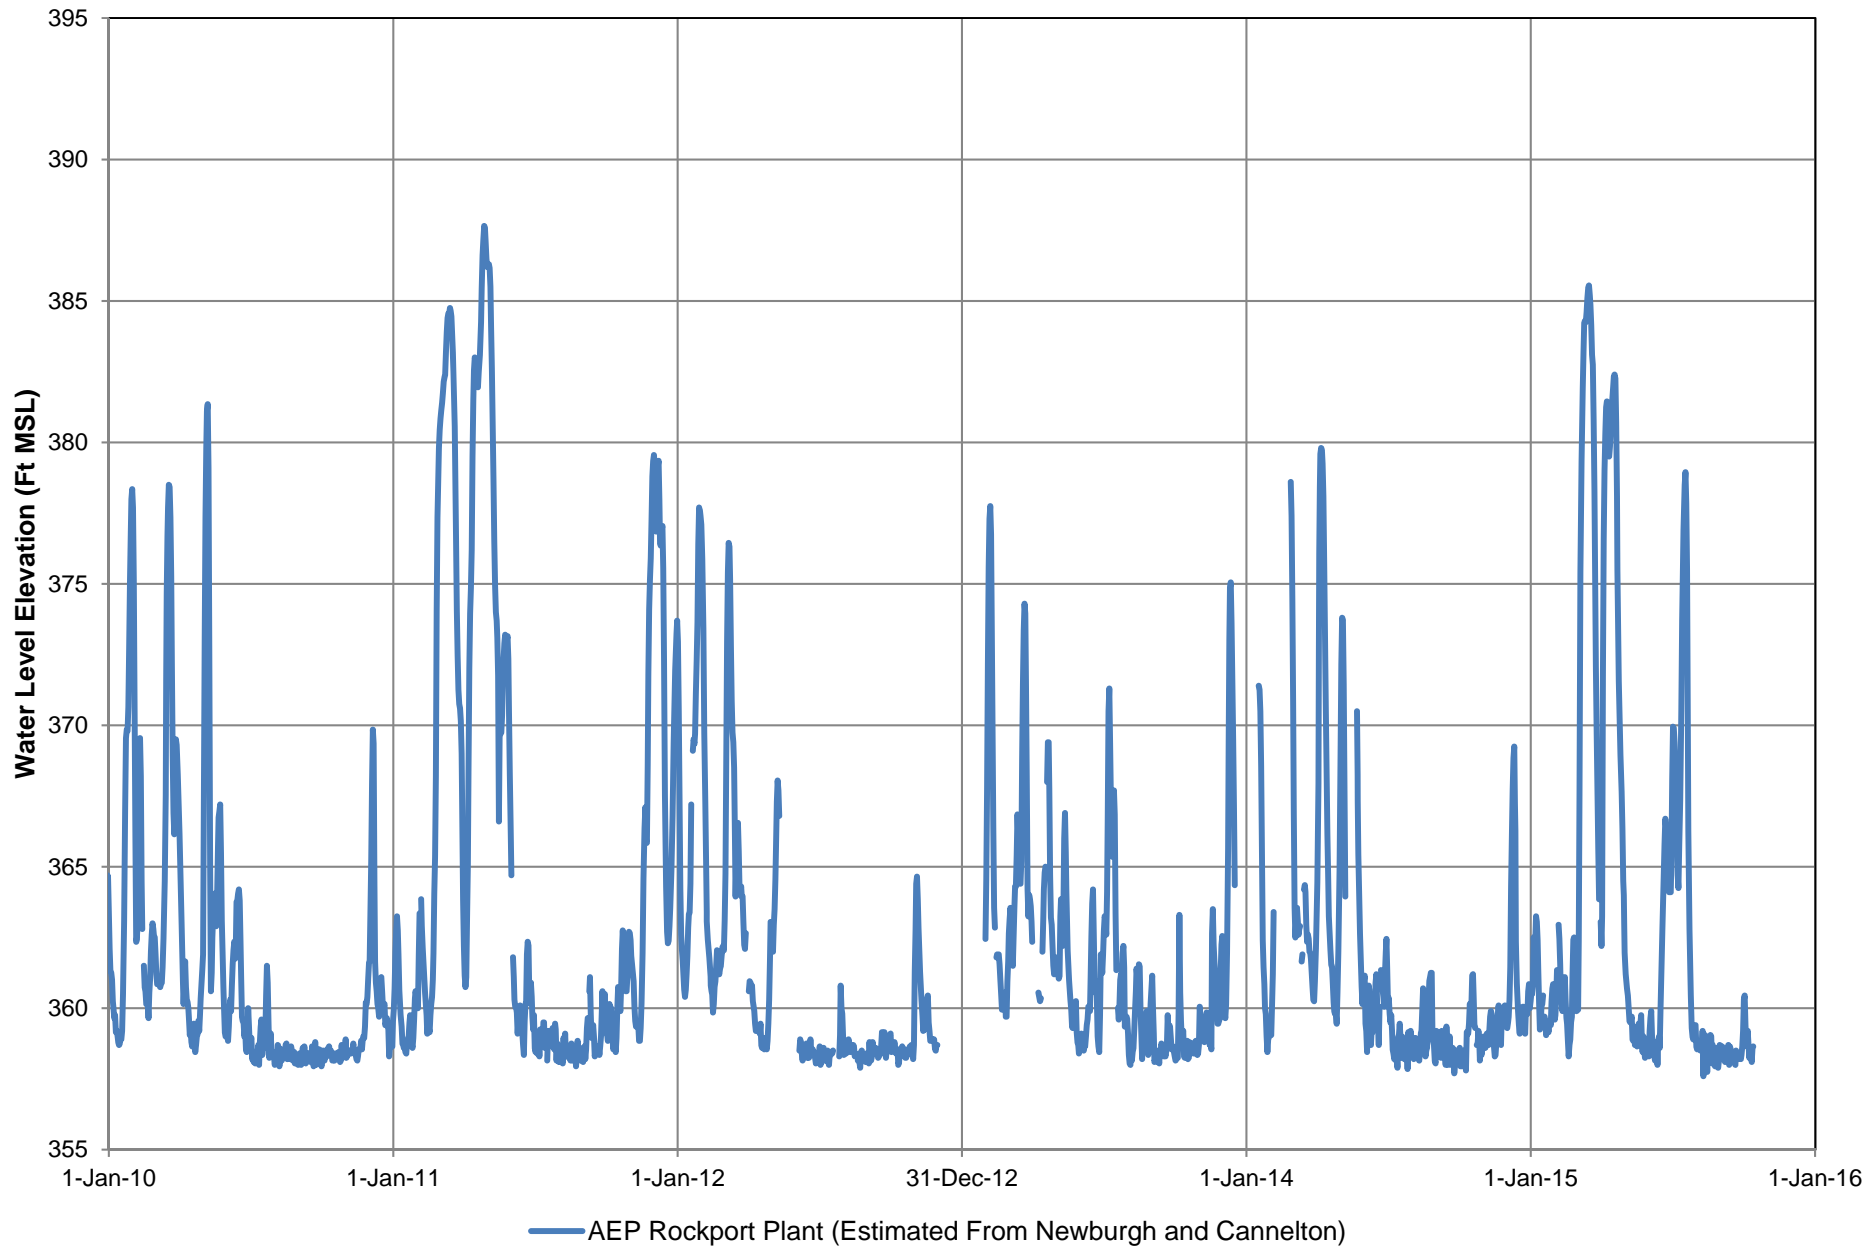

Appendix D-2

Landfill Piezometric Maps, 2010-2013

AMERICAN ELECTRIC POWER
 ROCKPORT PLANT FLYASH LANDFILL GROUNDWATER SAMPLING
 OWNED BY CHRYSLER FINANCIAL GROUP
 DATE/FIELD CONDITIONS: May 18, 2010/CLOUDY, 60 DEGREES F, STATIC WATER LEVELS MEASURED May 18, 2010.

LEGEND


- FIELD BENCHMARK
- MW-8S MONITORING WELL
- POTENTIOMETRIC CONTOUR (BASED ON SHALLOW "S" WELLS)
- DIRECTION OF GROUNDWATER FLOW
- WATER SUPPLY WELL
- CLOSED MONITORING WELL
- LANDFILL BOUNDARY
- TRANSMISSION LINES

REFERENCE DRAWINGS

- 12-30104 WELL LOCATION PLAN
- 12-30101 ASH AREA MONITORING WELLS CONSTRUCTION DETAILS TABLE
- 12-30550 ASH AREA AS BUILT MAPPING

WELL NO.	REF. DATUM POINT FT. (A)	** FEET TO STATIC LEVEL (B)	CALC. STATIC LEVEL (C)	*** 3 WELL VOLUMES (GAL)	ACTUAL AMT. PURGED GAL.	FIELD pH (S.U.)	FIELD Temp (Deg F)	FIELD COND (umhos)	TIME OF SAMPLING	NOTES
I 1S	397.29	28.95	368.34	5.9	7.5	7.46	60.0	608	1204	Clear
I 1I	397.34	29.04	368.30	17.2	25.8	7.39	59.9	517	1136	Clear
I 1D	397.32	28.85	368.47	28.9	34.0	7.39	59.9	563	1200	Clear
I 15S	392.62	23.98	368.64	8.9	13.9	7.59	61.4	686.5	1331	Clear
I 15I	392.82	24.14	368.68	20.7	22.4	7.30	61.2	2318	1321	Clear
I 16S	394.39	25.84	368.55	7.0	7.8	7.27	64.2	639	1243	Clear
I 16I	394.37	25.80	368.57	20.5	22.1	7.49	60.9	660	1325	Clear
I 16D	394.49	28.88	365.61	34.6	45.2	7.37	62.0	600	1321	Clear
I 17S	395.49	26.65	368.84	7.8	8.5	7.49	60.2	722	1403	Clear
I 17I	395.36	26.50	368.86	20.7	22.2	7.02	61.8	1677	1440	Clear
S 2S	399.24	30.44	368.80							
S 2I	399.26	30.45	368.81							
S 2D	399.28	30.47	368.81							
S 3S	396.81	CLOSED	5-8-08							
S 3I	397.05	28.40	368.65							
S 4S	396.58	27.82	368.76	6.5	7.1	5.61	59.4	204.8	845	Clear
S 4I	397.02	28.26	368.76	17.9	18.4	6.97	57.7	470.6	911	Clear
S 5S	396.00	2.91	393.09	13.2	17.0	7.39	59.8	2645	948	Clear
S 5I	392.10	0.90	391.20							
S 6S	394.89	26.72	368.17							
S 7S	393.66	25.44	368.22							
S 7I	393.62	25.40	368.22							
S 8S	393.91	24.62	369.29	8.3	11.2	7.50	57.5	545	853	Clear
S 8I	393.70	24.25	369.45	20.8	23.8	7.31	58.7	606	1001	Clear
S 9S	403.08	12.83	390.25							
S 10S	408.41	10.07	398.34							
S 11S	399.98	31.58	368.40							
S 12S	403.65	35.87	367.78							
S 13S	399.92	31.49	368.43							
S 14S	394.68	25.32	369.36							
S 18	400.38	31.78	368.60							
S 19	401.24	32.40	368.84							
S 20	400.52	31.64	368.88							
S 21S	400.76	32.12	368.64	2.1	2.7	7.56	58.1	623.5	1028	Slightly turbid, brown
S 21I	400.63	32.05	368.58	13.2	14	7.05	59.9	523.5	1004	Clear
S 21D	400.73	32.05	368.68	34.8	48.6	7.68	59.1	575.1	1150	Clear

***STATIC LEVELS ARE TO BE TAKEN ON EACH WELL AT EVERY SAMPLING EVENT (A-B-C)
 ***(REF. DATUM POINT - FEET TO STATIC LEVEL) - BOTTOM OF WELL ELEV. X .16 X 3 = 3 WELL VOLUMES (GAL)

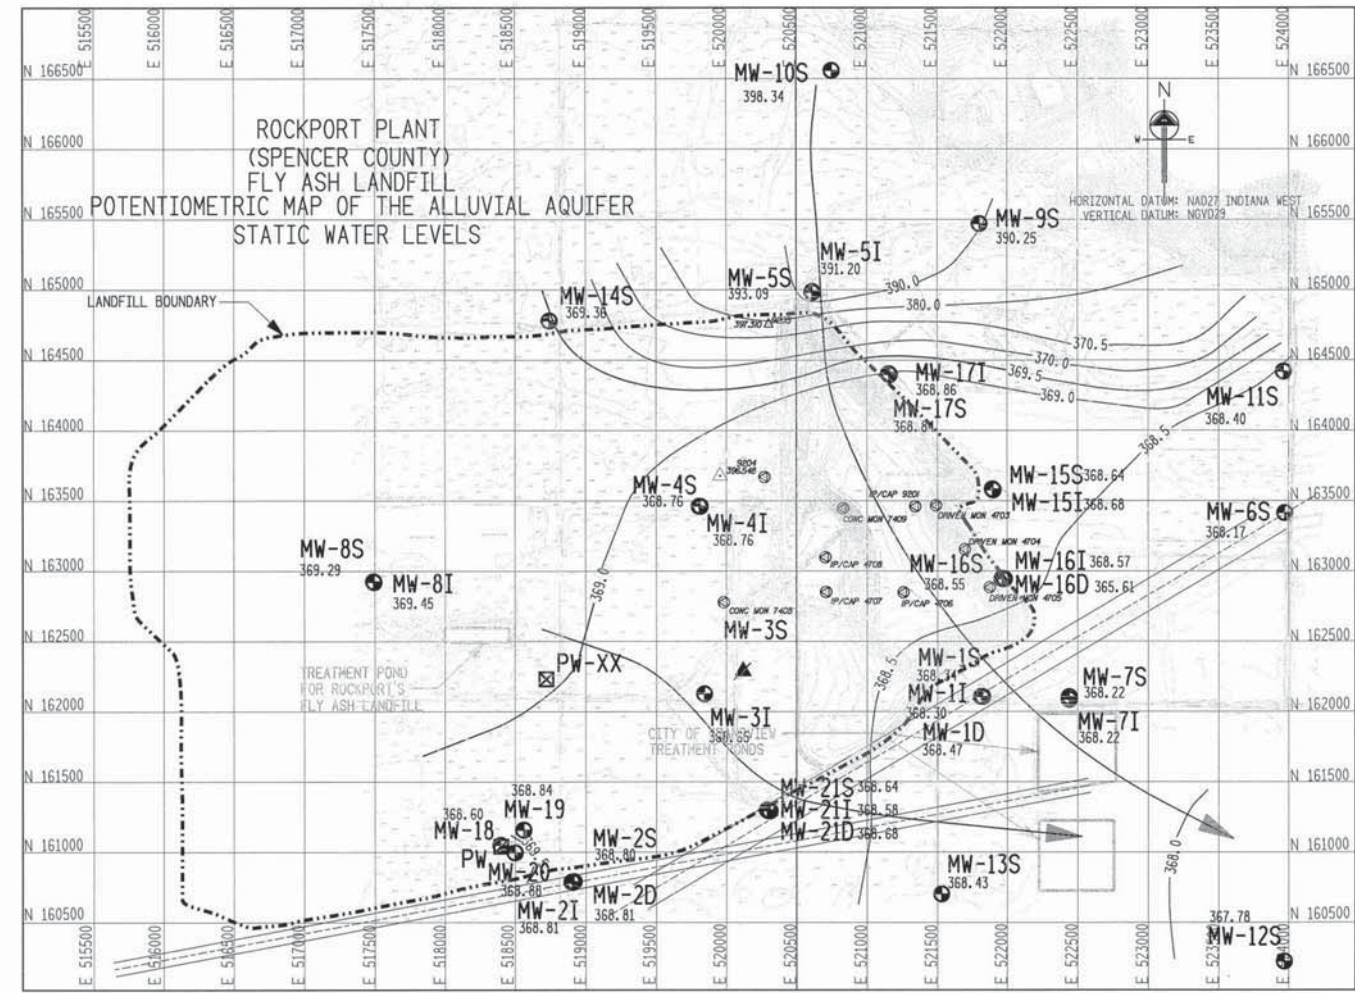

DATE	NO.	DESCRIPTION	APPROV.
7/9/2010	Y	STATIC WATER LEVELS MEASURED MAY 18, 2010.	PJA
1/7/10	X	DELETED PREVIOUS REVISIONS A THRU X. REVISED TO SHOW STATIC WATER LEVELS MEASURED NOV. 9, 2009.	PJA

REVISIONS
 Sr/RK/12/Geo-Hydro_Site/30105.dgn
 THIS DRAWING IS THE PROPERTY OF THE AMERICAN ELECTRIC POWER SERVICE CORP. AND IS LOANED UPON CONDITION THAT IT IS NOT TO BE REPRODUCED OR COPIED, IN WHOLE OR IN PART, OR USED FOR FURNISHING INFORMATION TO ANY PERSON WITHOUT THE WRITTEN CONSENT OF THE AEP SERVICE CORP., OR FOR ANY PURPOSE DETRIMENTAL TO THEIR INTEREST, AND IS TO BE RETURNED UPON REQUEST.



INDIANA MICHIGAN POWER CO
 ROCKPORT PLANT
 ROCKPORT INDIANA

POTENTIOMETRIC MAP

DWG. NO. 12-30105-Y

SCALE: AS SHOWN
 CIVIL ENGINEERING
 DESIGNED BY: J. J. Massey-Norton
 CHECKED BY: J. J. Massey-Norton
 APPROVED BY: J. J. Massey-Norton
 DATE: 12-1-10
 AEP SERVICE CORP. RIVERSIDE PLAZA COLUMBUS, OH 43215

NOVEMBER 2, 2010

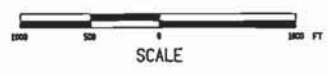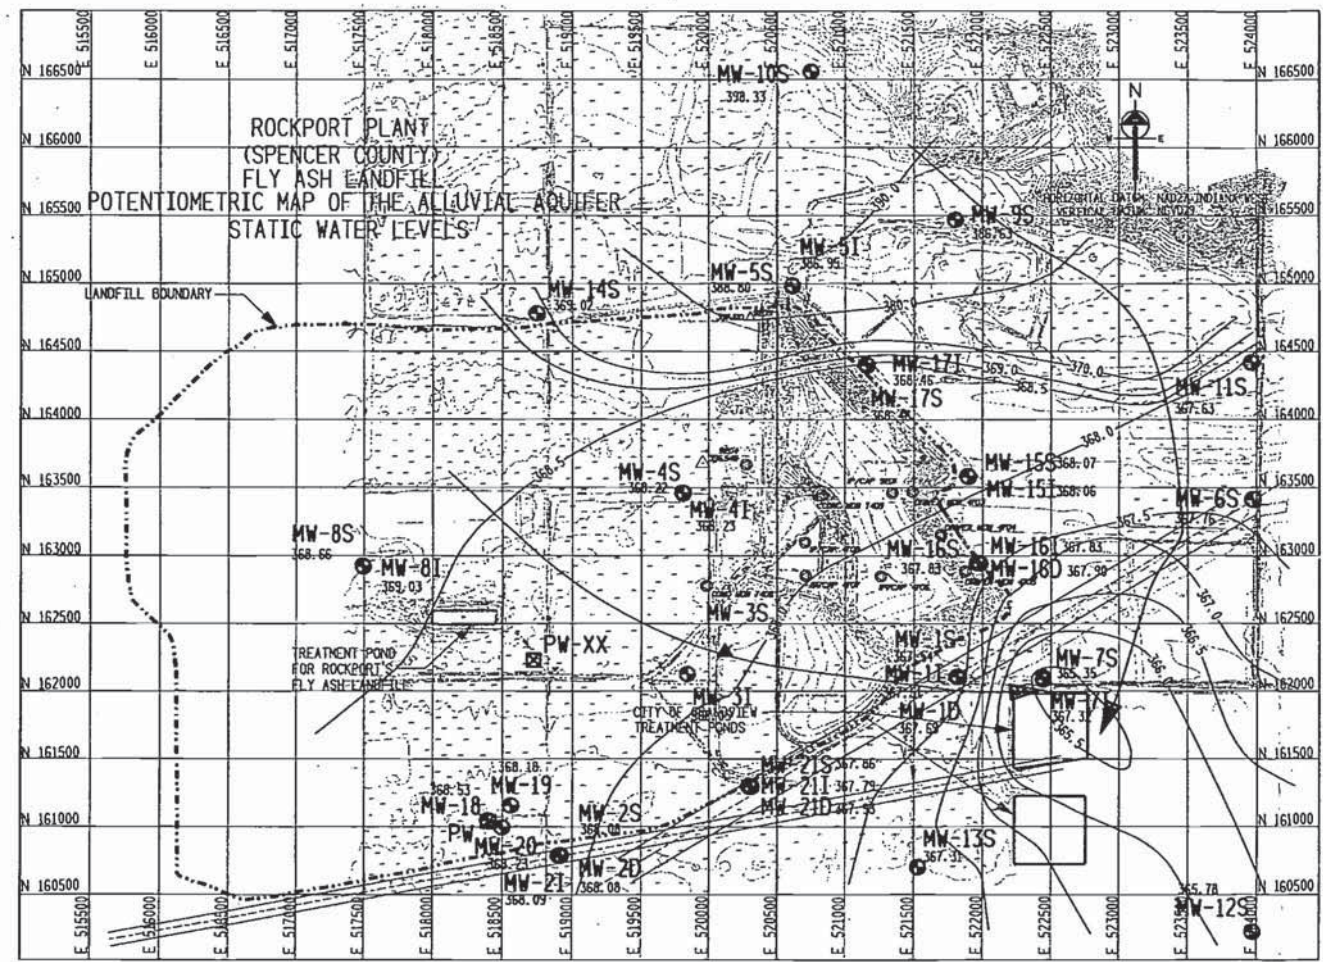

AMERICAN ELECTRIC POWER
 ROCKPORT PLANT FLY ASH LANDFILL GROUNDWATER SAMPLING
 SAMPLED POTENTIOMETRIC WELLS
 DATE/FIELD CONDITIONS: NOV. 3, 2010/NOV. 2010

WELL NO.	REF. DATUM POINT FT. (A)	** FEET TO STATIC LEVEL (B)	CALC. STATIC LEVEL (C)	*** 3 WELL VOLUMES (GAL)	ACTUAL AMT. PURGED GAL.	FIELD pH (S. U.)	FIELD Temp (Deg F)	FIELD COND (uS/cm)	TIME OF SAMPLING	NOTES
1S	397.29	29.75	367.54	5.5	7.0	7.61	56.7	646	1104	Clear
1I	397.34	29.83	367.51	16.8	18.5	7.40	57.2	542	1136	Clear
1D	397.32	29.63	367.69	28.6	30.7	7.39	57.7	585	1208	Clear
15S	392.62	24.55	368.07	8.7	9.6	7.29	57.4	706	1239	Clear
15I	392.82	24.76	368.06	20.4	22.8	7.24	57.4	1912	1324	Clear
16S	394.39	26.56	367.83	6.7	7.2	7.60	57.8	672	1200	Clear
16I	394.37	26.54	367.83	20.2	21.2	7.74	58.7	667	1243	Clear
16D	394.49	26.59	367.90	35.7	36.9	7.66	58.5	640	1308	Clear
17S	395.49	27.03	368.46	7.6	8.0	7.37	56.9	840	1345	Clear
17I	395.36	26.90	368.46	20.5	20.9	7.14	57.5	1607	1420	Clear
2S	399.24	31.16	368.08							
2I	399.26	31.17	368.09							
2D	399.28	31.20	368.08							
3S	396.81	CLOSED	5-8-08							
3I	397.05	29.00	368.05							
4S	396.58	28.36	368.22	6.2	7.5	7.80	56.0	191	902	Clear
4I	397.02	28.79	368.23	17.7	19.0	7.45	56.0	481	930	Clear
5S	396.00	7.20	388.80	11.2	14.8	7.34	56.0	2060	1036	Clear
5I	392.10	5.15	386.95							
6S	394.89	27.13	367.76							
7S	393.66	28.31	365.35							
7I	393.62	26.30	367.32							
8S	393.91	25.25	368.66	7.9	9.2	8.05	56.0	542	944	Clear
8I	393.70	24.67	369.03	20.6	21.8	7.57	56.9	675	955	Clear
9S	403.08	16.45	386.63							
10S	408.41	10.08	398.33							
11S	399.98	32.35	367.63							
12S	403.65	37.87	365.78							
13S	399.92	32.61	367.31							
14S	394.68	25.66	369.02							
18	400.38	31.85	368.53							
19	401.24	33.06	368.18							
20	400.52	32.29	368.23							
21S	400.76	32.90	367.86	1.7	2.7	7.94	57.0	516	1028	Clear
21I	400.63	32.84	367.79	12.8	14.3	7.63	57.0	530	1034	Clear
21D	400.73	32.80	367.93	34.4	36.0	7.81	56.6	592	1130	Clear

**STATIC LEVELS ARE TO BE TAKEN ON EACH WELL AT EVERY SAMPLING EVENT (4-8-08)
 ***REF. DATUM POINT - FEET TO STATIC LEVEL - BOTTOM OF WELL ELEV. 3.2' IS 3' x 3' WELL VOLUMES (GAL)

LEGEND

- FIELD BENCHMARK
- MW-BS MONITORING WELL
- 371 POTENTIOMETRIC CONTOUR (BASED ON SHALLOW "S" WELLS)
- DIRECTION OF GROUNDWATER FLOW
- WATER SUPPLY WELL
- CLOSED MONITORING WELL
- LANDFILL BOUNDARY
- TRANSMISSION LINES

REFERENCE DRAWINGS

- 12-30104 WELL LOCATION PLAN
- 12-30101 ASH AREA MONITORING WELLS CONSTRUCTION DETAILS TABLE
- 12-30550 ASH AREA AS BUILT MAPPING

REV.	DATE	DESCRIPTION	APPD.
1	11/03/10	STATIC WATER LEVELS MEASURED NOV. 3, 2010.	JJA
2	7/9/10	STATIC WATER LEVELS MEASURED MAY 15, 2010.	PJA
3	1/7/10	DELETED PREVIOUS REVISIONS A THRU V. REVISED TO SHOW STATIC WATER LEVELS MEASURED NOV. 3, 2010.	PJA

REVISIONS
 S: /RK/12/Geo_Hydro_Site/30105.dgn

THIS DRAWING IS THE PROPERTY OF THE AMERICAN ELECTRIC POWER SERVICE CORP. AND IS LOANED UNDER AGREEMENT THAT IT IS NOT TO BE REPRODUCED OR COPIED, IN WHOLE OR IN PART, OR USED FOR FURTHER INFORMATION TO ANY PERSON WITHOUT THE WRITTEN CONSENT OF THE AEP SERVICE CORP., OR FOR ANY PURPOSE DETRIMENTAL TO THEIR INTEREST, AND IS TO BE RETURNED UPON REQUEST.

INDIANA MICHIGAN POWER CO
 ROCKPORT PLANT
 ROCKPORT INDIANA

POTENTIOMETRIC MAP

DRG. NO. 12-30105-Z


SCALE IS DIM CIVIL ENGINEERING

DATE 11-03-10

J. J. M...
 J. J. M...
 J. J. M...

AEP SERVICE CORP.
 1 RIVERSIDE PLAZA
 COLUMBUS, OH 43225

MAY 10, 2011

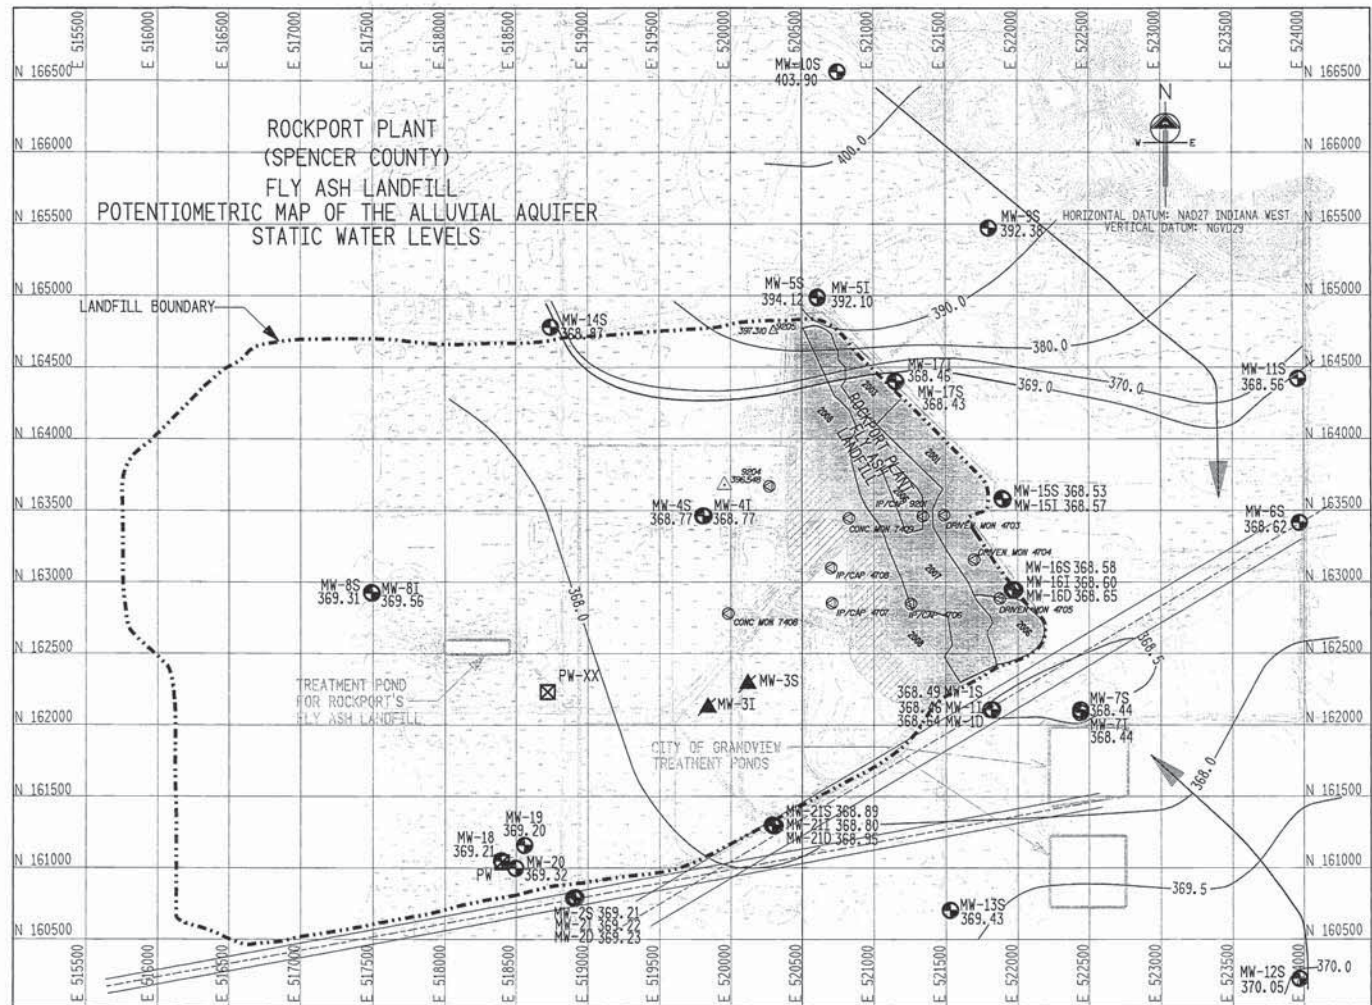

AMERICAN ELECTRIC POWER
 ROCKPORT PLANT FLY ASH LANDFILL GROUNDWATER SAMPLING
 SAMPLED BY CASEY SANDERS HANUS
 DATE/FIELD CONDITIONS: MAY 12, 2011/CLEAR 72 DEG F, STATIC WATER LEVELS MEASURED MAY 10, 2011.

WELL NO.	REF. DATUM POINT F.T. (A)	FEET TO STATIC LEVEL (B)	CALC. STATIC LEVEL (C)	3 WELL VOLUMES (GAL)	ACTUAL AMT. PURGED GAL.	FIELD pH (S.U.)	FIELD Temp (Deg F)	FIELD COND (umhos)	TIME OF SAMPLING	NOTES
1S	397.29	28.80	368.49	5.9	6.9	7.29	61.9	580	1019	Clear
1I	397.34	28.88	368.46	17.3	19.1	7.32	66.4	580	1118	Clear
1D	397.32	28.68	368.64	29.0	31.2	7.31	65.7	557	1018	Clear
15S	392.62	24.09	368.53	8.9	9.6	7.38	63.2	689	1205	Clear
15I	392.82	24.25	368.57	20.7	22.8	7.17	62.8	1870	1245	Clear
16S	394.39	25.81	368.58	7.0	8.5	7.63	63.2	714	1155	Clear
16I	394.37	25.77	368.60	20.5	21.5	7.54	63.0	662	1306	Clear
16D	394.49	25.84	368.65	36.1	38.9	7.56	63.0	645	1115	Clear
17S	395.49	27.06	368.43	7.6	9.6	7.20	63.2	756	1315	Clear
17I	395.36	26.90	368.46	20.5	22.3	7.14	60.8	1561	1320	Clear
2S	399.24	30.03	369.21							
2I	399.26	30.04	369.22							
2D	399.28	30.05	369.23							
3S	396.81	CLOSED	5-8-08							
3I	397.05	CLOSED	4-25-11							
4S	396.58	27.81	368.77	6.5	7.6	7.25	59.1	217.2	718	Clear
4I	397.02	28.25	368.77	17.9	19.8	7.04	60.8	470.0	745	Clear
5S	396.00	1.88	394.12	13.7	18.7	7.32	62.0	3110	920	Clear
5I	392.10	0.00	392.10							
6S	394.89	26.27	368.62							
7S	393.66	25.22	368.44							
7I	393.62	25.18	368.44							
8S	393.91	24.60	369.31	8.3	10.7	7.62	59.2	526	720	Clear
8I	393.70	24.14	369.56	20.9	21.9	7.45	60.1	681.5	752	Clear
9S	403.08	10.70	392.38							
10S	408.41	4.51	403.90							
11S	399.98	31.42	368.56							
12S	403.65	33.60	370.05							
13S	399.92	30.49	369.43							
14S	394.68	25.81	368.87							
18	400.39	31.17	369.21							
19	401.24	32.04	369.20							
20	400.52	31.20	369.32							
21S	400.76	31.87	368.89	2.2	3.5	7.46	61.8	435	818	Clear
21I	400.63	31.83	368.80	13.3	14.1	7.36	63.3	526	853	Clear
21D	400.73	31.78	368.95	34.9	36.4	7.53	64.1	581	953	Clear

***STATIC LEVELS ARE TO BE TAKEN ON EACH WELL AT EVERY SAMPLING EVENT (4-8-03)
 ***REF. DATUM POINT - FEET TO STATIC LEVEL - BOTTOM OF WELL ELEV. 1 X 16 X 3 - 3 WELL VOLUMES (GAL)

LEGEND

- FIELD BENCHMARK
- MW-8S MONITORING WELL
- POTENTIOMETRIC CONTOUR (BASED ON SHALLOW "S" WELLS)
- DIRECTION OF GROUNDWATER FLOW
- WATER SUPPLY WELL
- CLOSED MONITORING WELL
- LANDFILL BOUNDARY
- TRANSMISSION LINES
- 30" COVER PLACED

REFERENCE DRAWINGS

- 12-30104 WELL LOCATION PLAN
- 12-30101 ASH AREA MONITORING WELLS CONSTRUCTION DETAILS TABLE
- 12-30550 ASH AREA AS BUILT MAPPING

DATE	NO.	DESCRIPTION	APPROV.
7/1/10	AB	CLOSED WELL MW-3I. STATIC WATER LEVELS MEASURED MAY 10, 2011.	JFZ
4/5/11	AA	ADDED 2010 AS-BUILT MAPPING.	GFZ
2/20/10	Z	STATIC WATER LEVELS MEASURED NOV. 3, 2010.	GFZ
7/9/10	Y	STATIC WATER LEVELS MEASURED MAY 18, 2010.	PJA
1/7/10	X	DELETED PREVIOUS REVISIONS A THRU W. REVISED TO SHOW STATIC WATER LEVELS MEASURED NOV. 9, 2009.	PJA

THIS DRAWING IS THE PROPERTY OF THE AMERICAN ELECTRIC POWER SERVICE CORP. AND IS LOANED UPON CONDITION THAT IT IS NOT TO BE REPRODUCED OR COPIED, IN WHOLE OR IN PART, OR USED FOR FURNISHING INFORMATION TO ANY PERSON WITHOUT THE WRITTEN CONSENT OF THE AEP SERVICE CORP. FOR ANY PURPOSE DETRIMENTAL TO THEIR INTEREST, AND IS TO BE RETURNED UPON REQUEST.

INDIANA MICHIGAN POWER CO
 ROCKPORT PLANT
 ROCKPORT INDIANA

POTENTIOMETRIC MAP

DWG. NO. 12-30105-AB

SCALE: AS SHOWN
 CIVIL ENGINEERING
 APPROVED BY: J. J. Massey-Holton

AMERICAN ELECTRIC POWER
 AEP SERVICE CORP.
 1 RIVERSIDE PLAZA
 COLUMBUS, OH 43215


74-02
 RECEIVED
 JUL 12 2011
 DEPARTMENT OF ENVIRONMENTAL MANAGEMENT
 OFFICE OF LAND QUALITY

NOVEMBER 8, 2011

AMERICAN ELECTRIC POWER
 ROCKPORT PLANT FLY ASH LANDFILL GROUNDWATER SAMPLING
 SAMPLED BY: CARY SANDERS HANCO
 DATE/FIELD CONDITIONS: NOV. 10, 2010/SUNNY, WINDY, 48 DEG F, STATIC WATER LEVELS MEASURED NOV. 8, 2011.

WELL NO.	REF. DATUM FT. (A)	FEET TO STATIC LEVEL (B)	CALC. STATIC LEVEL (C)	3 WELL VOLUMES (GAL)	ACTUAL AMT. PURGED GAL.	FIELD pH (S. U.)	FIELD Temp (Deg F)	FIELD COND (umhos)	TIME OF SAMPLING	NOTES
1S	397.29	26.95	370.34	6.8	8.2	7.58	57.2	630.7	939	Clear
1I	397.34	27.03	370.31	18.1	20.5	7.21	58.1	536.6	1006	Clear
1D	397.32	26.84	370.48	29.9	34.8	7.34	58.1	579.7	1043	Clear
15S	392.62	21.75	370.87	10.0	10.5	7.30	57.9	690	1204	Clear
15I	392.82	21.93	370.89	21.8	23.8	7.26	57.3	1805	1245	Clear
16S	394.39	23.80	370.59	8.0	8.5	7.50	58.3	644	1033	Clear
16I	394.37	23.77	370.60	21.5	22.8	7.71	58.0	648	1112	Clear
16D	394.49	23.74	370.75	37.1	40.8	7.66	57.6	649	1136	Clear
17S	395.49	24.29	371.20	8.9	9.2	7.28	56.3	789	1250	Clear
17I	395.36	24.16	371.20	21.8	22.3	7.35	55.8	1428	1318	Clear
2S	399.24	28.41	370.83							
2I	399.26	28.42	370.84							
2D	399.28	28.46	370.82							
3S	396.81	CLOSED	5-8-08							
3I	397.05	CLOSED	4-25-11							
4S	396.58	25.72	370.86	7.5	8.2	6.30	56.5	225	831	Clear
4I	397.02	25.99	371.03	19.0	19.4	7.21	55.6	505.9	858	Clear
5S	396.00	6.25	389.75	11.6	15.6	7.39	57.2	2286	953	Clear
5I	392.10	4.21	387.89							
6S	394.89	24.95	369.94							
7S	393.66	23.54	370.12							
7I	393.62	23.52	370.10							
8S	393.91	22.35	371.56	9.3	13.6	7.03	56.7	538.5	835	Clear
8I	393.70	21.91	371.79	21.9	24.1	7.41	56.8	698.2	852	Clear
9S	403.08	15.93	387.15							
10S	408.41	11.23	397.18							
11S	399.98	29.46	370.52							
12S	403.65	35.33	368.32							
13S	399.92	29.90	370.02							
14S	394.68	22.90	371.78							
18	400.39	29.51	370.87							
19	401.24	30.31	370.93							
20	400.52	29.58	370.94							
21S	400.76	30.08	370.68	3.1	3.6	7.53	57.4	540.9	1145	Clear
21I	400.63	30.00	370.63	14.2	14.8	7.71	57.5	499.6	1125	Clear
21D	400.73	29.98	370.75	35.8	38.0	7.61	56.5	595.8	1220	Clear

**STATIC LEVELS ARE TO BE TAKEN ON EACH WELL AT EVERY SAMPLING EVENT (A-B-C)
 ***REF. DATUM POINT - FEET TO STATIC LEVEL - BOTTOM OF WELL ELEV. X .38 X 3 = 3 WELL VOLUMES (GAL)

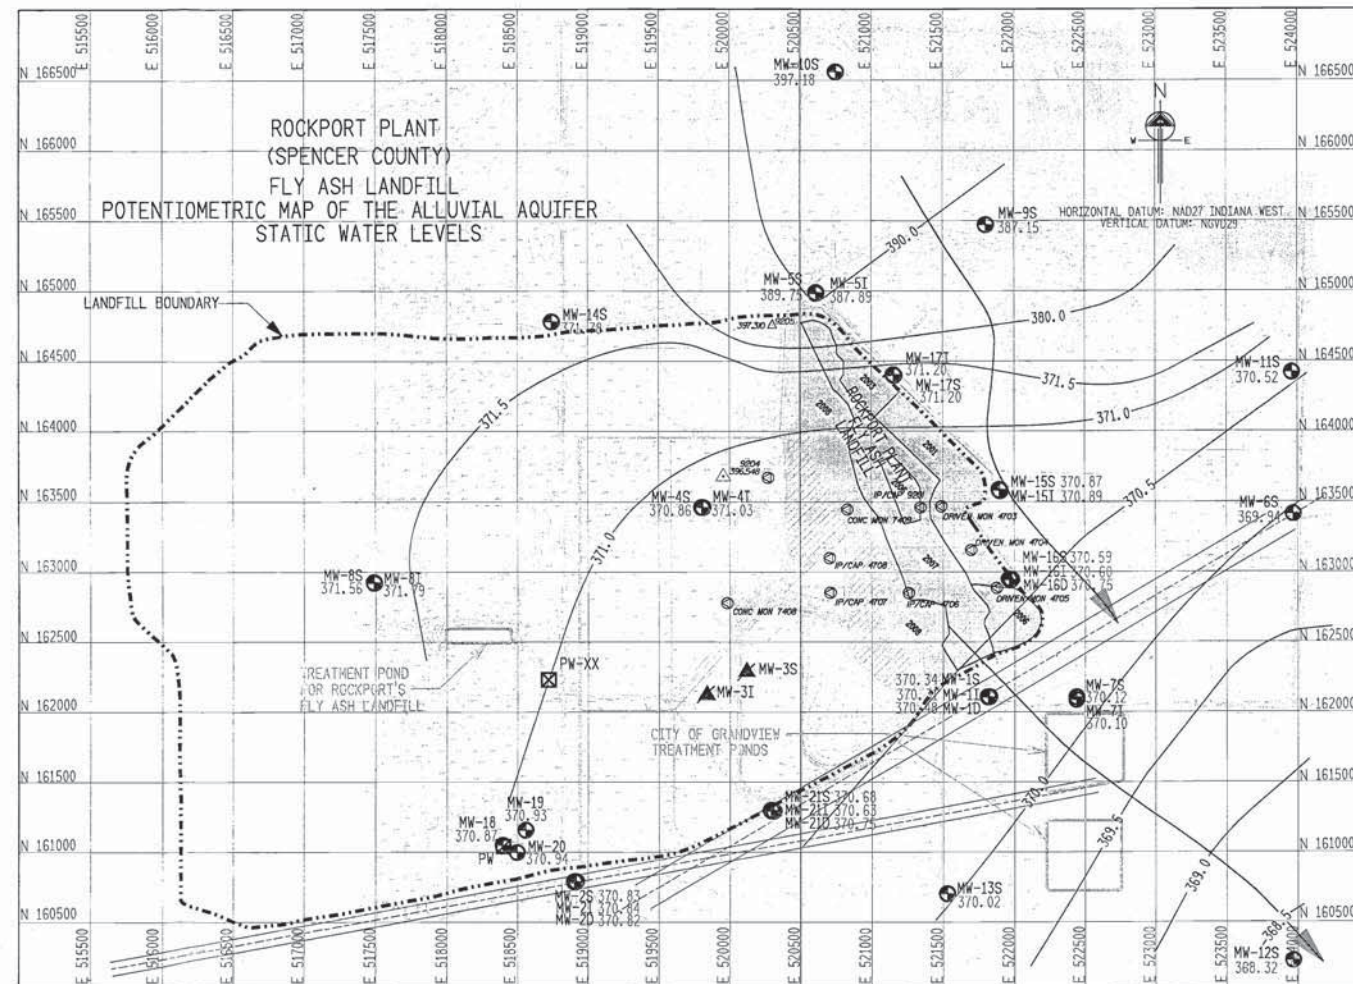

LEGEND

- FIELD BENCHMARK
- MW-BS MONITORING WELL
- POTENTIOMETRIC CONTOUR (BASED ON SHALLOW "S" WELLS)
- DIRECTION OF GROUNDWATER FLOW
- WATER SUPPLY WELL
- CLOSED MONITORING WELL
- LANDFILL BOUNDARY
- TRANSMISSION LINES
- 30" COVER PLACED

REFERENCE DRAWINGS

- 12-30104 WELL LOCATION PLAN
- 12-30701 ASH AREA MONITORING WELLS CONSTRUCTION DETAILS TABLE
- 12-30550 ASH AREA AS-BUILT MAPPING

RECEIVED
 JAN 05 2012
 DEPARTMENT OF ENVIRONMENTAL MANAGEMENT
 OFFICE OF LAND QUALITY

123011	BC	STATIC WATER LEVELS MEASURED NOV. 10, 2010.	JAN 07
DATE	NO.	DESCRIPTION	APPR.
REVISIONS			

THIS DRAWING IS CLASSIFIED AS:
AEP PUBLIC

REFERENCE AEP'S CORPORATE INFORMATION SECURITY POLICY


THIS DRAWING IS THE PROPERTY OF THE AMERICAN ELECTRIC POWER SERVICE CORP. AND IS LOANED UPON CONCERN THAT IT IS NOT TO BE REPRODUCED OR COPIED IN WHOLE OR IN PART. SOLELY FOR FURNISHING INFORMATION TO ANY PERSON WITHOUT THE WRITTEN CONSENT OF THE AEP SERVICE CORP. OR FOR ANY PURPOSE DETRIMENTAL TO THEIR INTEREST. AND IS TO BE RETURNED UPON REQUEST.

INDIANA MICHIGAN POWER COMPANY
ROCKPORT PLANT.
 ROCKPORT INDIANA
 GEOTECHNICAL
POTENTIOMETRIC MAP

DATE: 12	DRAWING NUMBER: 30105	REV: ac
SCALE: AS SHOWN	CIVIL ENGINEERING	
DR: JJJ	APPROVED BY: J.J. Massey-Norton	
CHK: JF	DATE SUBMITTED:	
DES: JF		
ENG: JF	AEP SERVICE CORP. 1 RIVERSIDE PLAZA COLUMBUS, OH 43215	

74-02
 AT 100126
 Spencer Co.

NOVEMBER 5, 2012

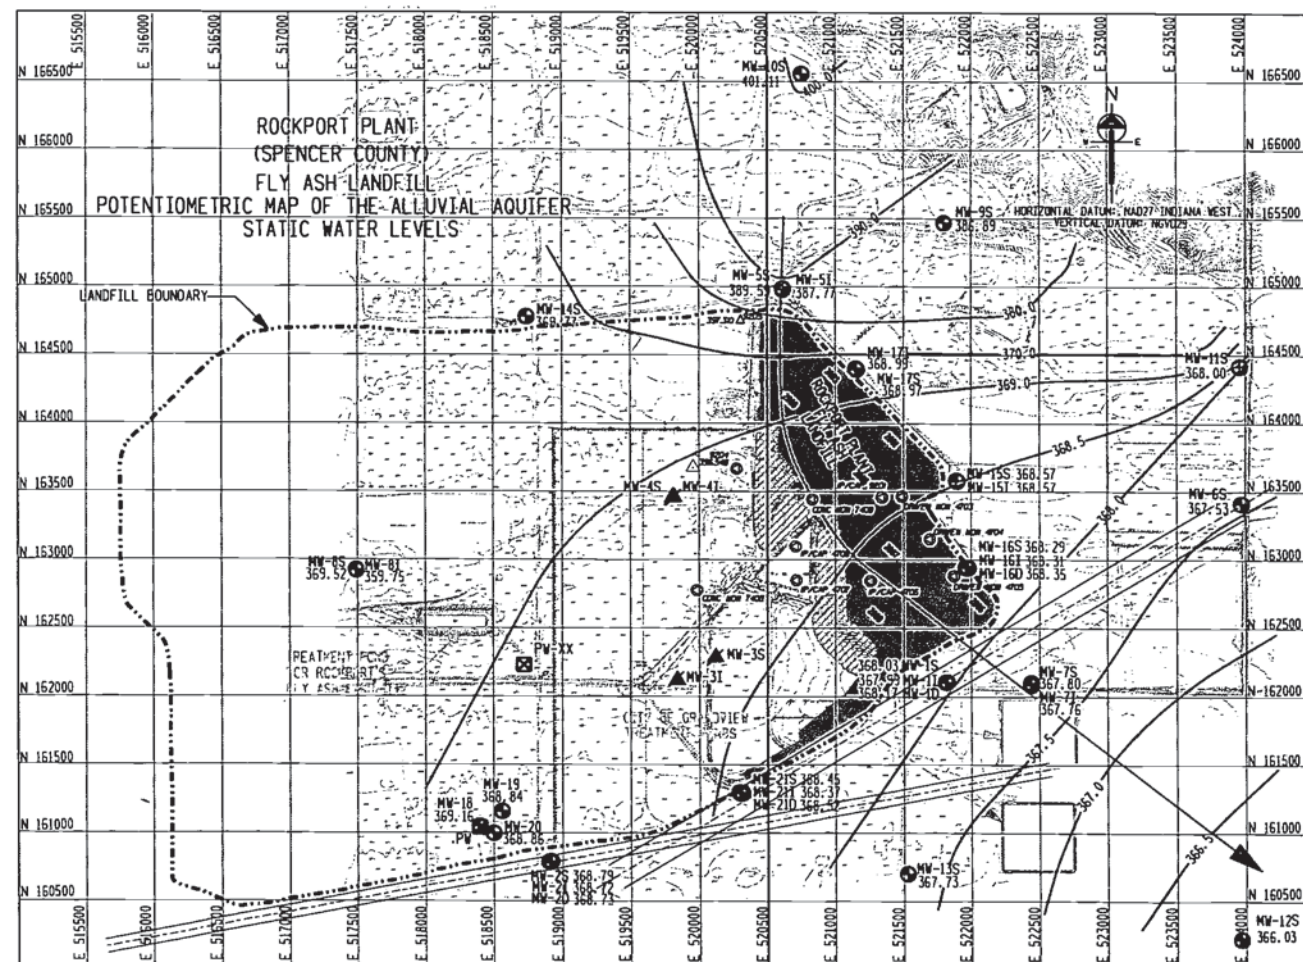

AMERICAN ELECTRIC POWER
 ROCKPORT PLANT FLYASH LANDFILL GROUNDWATER SAMPLING
 SAMPLED BY CAREY SANDOZ HANUS
 DATE/FIELD CONDITIONS: NOV 7, 2012/CLOUDY, WINDY, COOL 59 DEG F, STATIC WATER LEVELS MEASURED NOV 5, 2012.

WELL NO.	REF. DATUM POINT FT. (A)	** FEET TO STATIC LEVEL (B)	CALC. STATIC LEVEL (C)	3 WELL VOLUMES (GAL)	ACTUAL AMT. PURGED GAL.	FIELO pH (S. U.)	FIELO Temp (Deg F)	FIELO COND (uS/cm)	TIME OF SAMPLING	NOTES
I 1S	397.29	29.26	368.03	5.7	8.2	8.18	57.2	637	1024	Clear
I 1I	397.34	29.35	367.99	17.0	19.4	8.04	24.3	529	955	Clear
I 10	397.32	29.15	368.17	28.8	32.7	8.00	56.7	552	1030	Clear
I 15S	392.62	24.05	368.57	8.9	11.8	7.21	57.5	719	1107	Clear
I 15I	392.82	24.25	368.57	20.7	24.6	7.24	57.5	1485	1102	Clear
I 16S	394.39	26.10	368.29	6.9	9.0	7.42	59.0	684	1002	Clear
I 16I	394.37	26.06	368.31	20.4	28.5	7.54	59.0	650	935	Clear
I 16D	394.49	26.14	368.35	35.9	37.8	7.58	58.5	627	954	Clear
I 17S	395.49	26.52	368.97	7.9	9.0	7.22	57.5	816	1149	Clear
I 17I	395.36	26.37	368.99	20.7	21.8	7.13	57.0	1393	1223	Clear
S 2S	399.24	30.45	368.79							
S 2I	399.26	30.54	368.72							
S 2D	399.28	30.55	368.73							
S 3S	396.81	CLOSED	5-8-08							
S 3I	397.05	CLOSED	4-25-11							
S 4S	396.58	CLOSED	4-17-12							
S 4I	397.02	CLOSED	4-17-12							
I 5S	396.00	6.41	389.59	11.6	15.1	7.44	58.5	2100	922	Clear
I 5I	392.10	4.33	387.77							
I 6S	394.89	27.36	367.53							
I 7S	393.66	25.86	367.80							
I 7I	393.62	25.86	367.76							
I 8S	393.91	24.39	369.52	8.4	13.1	7.87	54.5	545	841	Clear
I 8I	393.70	33.95	359.75	16.1	19.3	7.96	52.8	642	846	Clear
I 9S	403.08	16.19	386.89							
I 10S	408.41	7.30	401.11							
I 11S	399.98	31.98	368.00							
I 12S	403.65	37.62	366.03							
I 13S	399.92	32.19	367.73							
I 14S	394.68	24.91	369.77							
I 18	400.38	31.22	369.16							
I 19	401.24	32.40	368.84							
I 20	400.52	31.66	368.86							
I 21S	400.76	32.31	368.45	2.0	6.5	7.69	54.3	482	1105	Clear
I 21I	400.63	32.26	368.37	13.1	14.8	7.92	57.3	530	1121	Clear
I 21D	400.73	32.21	368.52	34.7	35.6	7.89	57.0	579	1237	Clear

**STATIC LEVELS ARE TO BE TAKEN ON EACH WELL AT EVERY SAMPLING EVENT (A-B-C)
 ***COND. DATUM POINT - FEET TO STATIC LEVEL - BOTTOM OF WELL ELEV. 3' x 1.5' x 3' 3" WELL VOLUMES (GAL)

LEGEND

- SPOT ELEVATION
- INTERMEDIATE CONTOUR
- INDEX CONTOUR
- DEPRESSION CONTOUR
- TREES AND TREELINE
- STRUCTURE AND BUILDING
- FENCE
- POLE
- ROADS
- EDGE OF WATER
- RUMBLE / CATCH BASIN
- POWER POLE
- PIPES
- TOWER
- FIELD BENCHMARK
- MONITORING WELL
- POTENTIOMETRIC CONTOUR (BASED ON SHALLOW WELLS)
- DIRECTION OF GROUNDWATER FLOW
- WATER SUPPLY WELL
- CLOSED MONITORING WELL
- LANDFILL BOUNDARY
- TRANSMISSION LINES
- 30" COVER PLACED

REFERENCE DRAWINGS

- 12-30097A BASELINE GROUND WATER QUALITY & POTENTIOMETRIC ELEVATIONS FOR 9/10/05
- 12-30550 ASH AREA AS BUILT MAPPING
- 12-30100 ASH AREA BORING LOCATION PLAN ACTIVE FILL AREA 1993
- 12-30101 ASH AREA MONITORING WELLS CONSTRUCTION DETAILS TABLE
- 12-30104 WELL LOCATION PLAN

DATE: 11/05/12
 DESCRIPTION: STATIC WATER LEVELS MEASURED NOV. 5, 2012.
 REVISIONS:

THIS DRAWING IS CLASSIFIED AS:
AEP PUBLIC

REFERENCE AEP'S CORPORATE INFORMATION SECURITY POLICY


THIS DRAWING IS THE PROPERTY OF THE AMERICAN ELECTRIC POWER SERVICE CORP. AND IS LOANED UNDER AGREEMENT THAT IT IS NOT TO BE REPRODUCED OR COPIED, IN WHOLE OR IN PART, OR USED FOR PUBLISHING INFORMATION TO ANY PERSON WITHOUT THE WRITTEN CONSENT OF THE AEP SERVICE CORP. FOR ANY PURPOSE OTHER THAN THAT FOR WHICH IT WAS LOANED, AND IS TO BE RETURNED UPON REQUEST.

INDIANA MICHIGAN POWER COMPANY
ROCKPORT PLANT
 ROCKPORT INDIANA
 GEOTECHNICAL
POTENTIOMETRIC MAP

DATE: 11/05/12
 DRAWING NUMBER: 30105
 SCALE: AS SHOWN
 CIVIL ENGINEERING
 DR: J. J. M...
 IN CHARGE: J. J. M...
 APPROVED: J. J. M...
 DATE REVIEWED: 11/05/12
 AEP SERVICE CORP.
 1 RIVERSIDE PLAZA
 COLUMBUS, OH 43215

7402

MAY 13, 2013

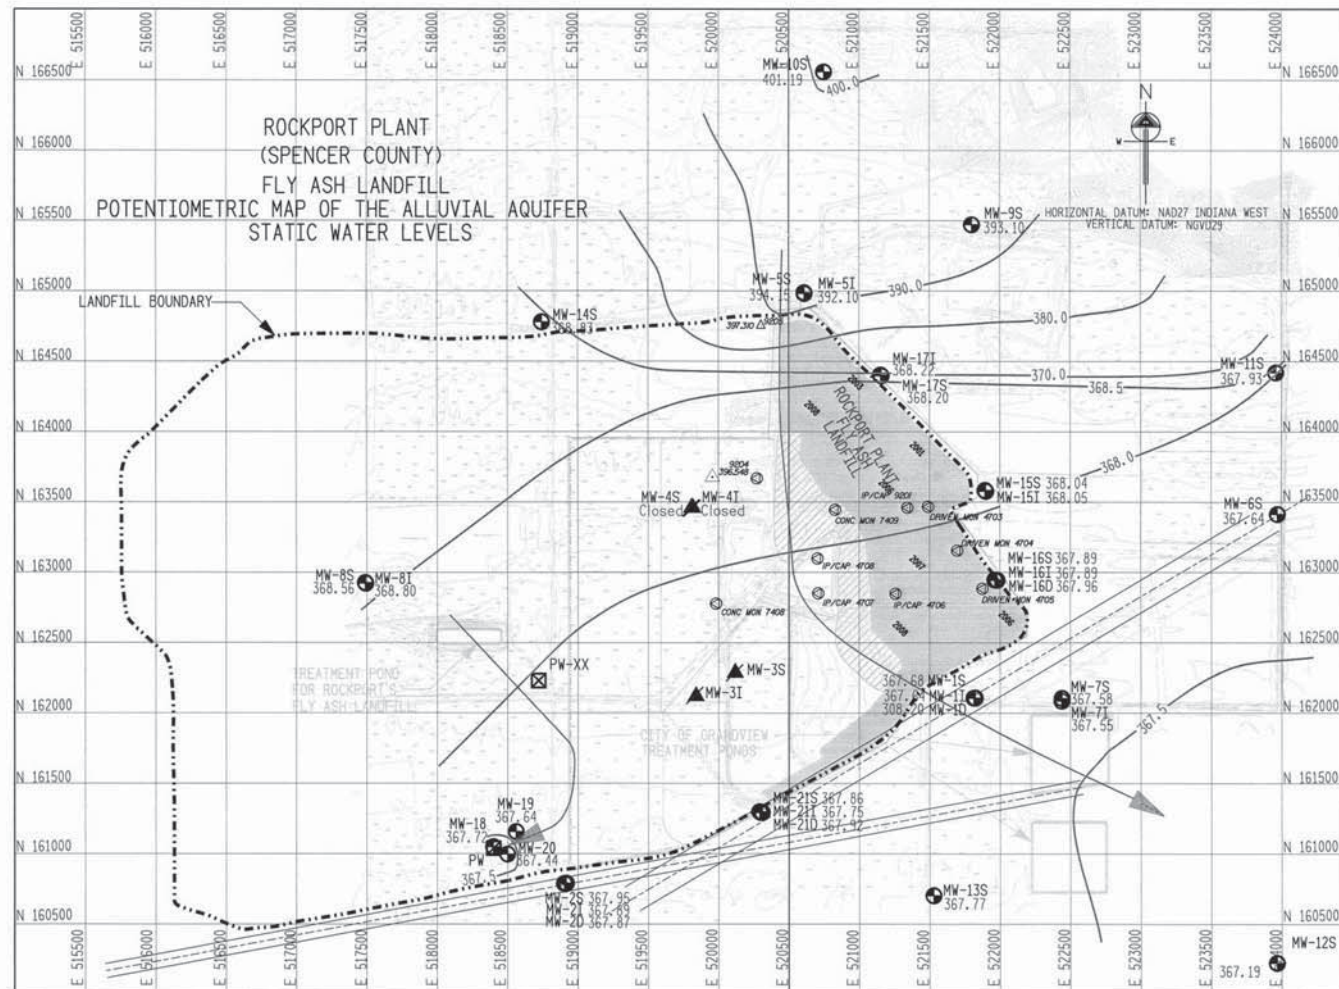

AMERICAN ELECTRIC POWER
 ROCKPORT PLANT FLY ASH LANDFILL GROUNDWATER SAMPLING
 SAMPLED BY: CAREY SANDERS HARRIS
 DATE/FIELD CONDITIONS: MAY 13, 2013/SUNNY, WARM 80 DEG F, STATIC WATER LEVELS MEASURED MAY 13, 2013.

WELL NO.	REF. DATUM POINT FT. (A)	** FEET TO STATIC LEVEL (B)	CALC. STATIC LEVEL (C)	*** 3 WELL VOLUMES (GAL)	ACTUAL AMT. PURGED GAL.	FIELD pH (S. U.)	FIELD Temp (Deg F)	FIELD COND (umhos)	TIME OF SAMPLING	NOTES
1S	397.29	29.61	367.68	5.6	6.3	7.28	60.2	622	917	Clear
1T	397.34	29.70	367.64	16.9	20.9	7.53	60.0	528	1026	Clear
1D	397.32	29.50	367.82	28.6	31.9	7.58	59.6	546	1033	Clear
15S	392.62	24.58	368.04	8.7	8.7	7.17	59.0	727	1128	Clear
15T	392.82	24.77	368.05	20.4	21.2	7.21	58.7	1675	1134	Clear
16S	394.39	26.50	367.89	6.7	7.5	7.39	60.5	682	949	Clear
16T	394.37	26.48	367.89	20.2	21.3	7.67	60.0	657	1048	Clear
16D	394.49	26.53	367.96	35.7	36.8	7.47	59.5	636	1057	Clear
17S	395.49	27.29	368.20	7.5	7.9	7.31	58.4	778	1208	Clear
17T	395.36	24.14	368.22	20.4	21.1	7.23	58.2	1411	1200	Clear
2S	399.24	31.29	367.95	5.1	5.7	7.58	59.0	382.5	1108	Clear
2T	399.26	31.37	367.89	16.1	16.4	8.00	58.90	481.3	1156	Clear
2D	399.28	31.41	367.87	28.1	29.6	7.73	58.4	591.7	1208	Clear
3S	396.81	CLOSED	5/8/2008							
3T	397.05	CLOSED	4/25/2011							
4S	396.58	CLOSED	4/17/2012							
4T	397.02	CLOSED	4/17/2012							
5S	396.00	1.85	394.15	13.8	17.9	7.59	59.5	2970	1010	Clear
5T	392.10	0.00	392.10							
6S	394.89	27.25	367.64							
7S	393.66	26.08	367.58							
7T	393.62	26.07	367.55							
8S	393.91	25.35	368.56	7.9	11.1	7.66	58.5	586	850	Clear
8T	393.70	24.90	368.80	20.5	21.2	7.55	58.5	622	910	Clear
9S	403.08	11.14	393.10							
10S	408.41	7.22	401.19							
11S	399.98	32.05	367.93							
12S	403.65	36.46	367.19							
13S	399.92	32.15	367.77							
14S	394.68	25.85	368.83							
18	400.38	32.66	367.72							
19	401.24	33.60	367.64							
20	400.52	33.08	367.44							
21S	400.76	32.90	367.86	1.7	1.8	8.04	59.7	505	1215	Clear
21T	400.63	32.88	367.75	12.8	13.2	7.53	59.8	531	1258	Clear
21D	400.73	32.81	367.92	34.4	37.0	7.86	59.3	577	1350	Clear

***STATIC LEVELS ARE TO BE TAKEN ON EACH WELL AT EVERY SAMPLING EVENT (A-B-C)
 ***(REF. DATUM POINT - FEET TO STATIC LEVEL) - BOTTOM OF WELL ELEV. X 3 X .18 X 3 = 3 WELL VOLUMES (GAL)

LEGEND

- SPOT ELEVATION
- INTERMEDIATE CONTOUR
- INDEX CONTOUR
- DEPRESSION CONTOUR
- TREES AND TREELINE
- STRUCTURE AND BUILDING
- FENCE
- POLE
- ROADS
- EDGE OF WATER
- MANHOLES / CATCH BASIN
- POWER POLE
- PIPES
- TOWER
- FIELD BENCHMARK
- MONITORING WELL
- POTENTIOMETRIC CONTOUR (BASED ON SHALLOW S WELLS)
- DIRECTION OF GROUNDWATER FLOW
- WATER SUPPLY WELL
- CLOSED MONITORING WELL
- LANDFILL BOUNDARY
- TRANSMISSION LINES
- 30" COVER PLACED

- REFERENCE DRAWINGS**
- 12-30097A BASELINE GROUND WATER QUALITY & POTENTIOMETRIC ELEVATIONS FOR 9/10/85
 - 12-30550 ASH AREA AS BUILT MAPPING
 - 12-30100 ASH AREA BORING LOCATION PLAN ACTIVE FILL AREA 1993
 - 12-30101 ASH AREA MONITORING WELLS CONSTRUCTION DETAILS TABLE
 - 12-30104 WELL LOCATION PLAN

DATE	NO.	DESCRIPTION	APPROVED
07/02/13	AF	STATIC WATER LEVELS MEASURED MAY 13, 2013.	JAN OFP

THIS DRAWING IS CLASSIFIED AS:
AEP PUBLIC

REFERENCE AEP'S CORPORATE INFORMATION SECURITY POLICY

THIS DRAWING IS THE PROPERTY OF THE AMERICAN ELECTRIC POWER SERVICE CORP. AND IS LOANED UPON CONDITION THAT IT IS NOT TO BE REPRODUCED OR COPIED, IN WHOLE OR IN PART, OR USED FOR FURNISHING INFORMATION TO ANY PERSON WITHOUT THE WRITTEN CONSENT OF THE AEP SERVICE CORP. OR FOR ANY PURPOSE BEYOND THAT TO THEIR INTEREST, AND IS TO BE RETURNED UPON REQUEST.

INDIANA MICHIGAN POWER COMPANY

ROCKPORT PLANT

ROCKPORT INDIANA

GEOTECHNICAL

POTENTIOMETRIC MAP

DATE	DRAWING NUMBER	REV
12	30105	AF
SCALE: AS SHOWN	CIVIL ENGINEERING	
DR: JJJ		
CH: JT #14		
SUP:		
ENG:		
DATE: SEE REV'S		

APPROVED BY: *J. J. Massey-Norton*

AMERICAN ELECTRIC POWER
 AEP SERVICE CORP.
 1 RIVERSIDE PLAZA
 COLUMBUS, OH 43215

CROSS REFS:

CROSS REFS:

CROSS REFS:

Appendix D-3
Landfill Piezometric Data

Appendix D-3
Landfill Monitoring Well Piezometric Data
AEP Rockport Plant, Indiana

Well ID	1S	1I	1D	2S	2I	2D	3S	3I
Min	365.88	365.84	365.89	366.86	366.94	366.96	366.81	366.84
Max	371.54	371.48	371.53	370.94	370.96	370.95	370.69	370.7
Date								
11/18/1992								
5/5/1995								
11/28/1995								
6/6/1996								
11/12/1998					370.09	370.09		
5/27/1999	368.88	368.90	368.90					
11/17/1999		367.13	367.17					
5/10/2000	366.90	366.85	366.91	367.59	367.59	367.59	367.29	367.35
11/8/2000	366.32	365.84	366.33	366.86	366.94	366.96	366.81	366.84
12/29/2000					366.94			
5/8/2001	366.57	366.54	366.57	367.15	367.17	367.14	366.92	367.00
5/29/2001								
11/7/2001	365.88	365.84	365.89					
11/13/2001								
5/29/2002	367.39	367.64	367.70					
8/1/2002								
11/13/2002	367.78	367.75	367.78					
5/14/2003	368.62	368.62	368.63					
11/6/2003	369.39	369.35	369.41					
5/19/2004	370.48	370.44	370.47	370.84	370.85	370.85	370.69	370.70
11/9/2004	370.02	369.99	370.03					
5/17/2005	371.54	371.48	371.53					
11/8/2005	369.15	369.13	369.16	369.74	369.75	369.73	369.70	369.74
5/9/2006	367.99	367.94	368.27					
11/8/2006	367.24	367.20	367.25					
5/9/2007	369.19	369.15	369.20					
11/12/2007	367.68	367.65	367.71	368.24				
5/6/2008	369.68	369.62	369.65					
11/20/2008	369.12	369.07	369.12					
5/20/2009	368.02	368.00	368.04					
7/14/2009								
9/9/2009								
11/10/2009	367.62	367.59	367.74					
1/19/2010								
3/17/2010								
5/18/2010	368.34	368.30	368.47					
11/3/2010	367.54	367.51	367.69					
1/4/2011								
1/10/2011								
1/17/2011								
2/8/2011								
2/14/2011								
3/2/2011								
3/22/2011								
5/12/2011	368.49	368.46	368.64					
11/10/2011	370.34	370.31	370.48					
5/8/2012	370.57	370.54	370.70	370.94	370.96	370.95		
11/7/2012	368.03	367.99	368.17	368.72	368.72	368.73		
5/16/2013	367.68	367.64	367.82	367.88	367.89	367.87		
8/21/2013				368.49	368.48	368.46		
11/4/2013	367.46	367.40	367.59	367.74	367.74	367.73		
1/20/2014				367.52	367.49	367.52		
5/7/2014	368.37	368.35	368.52	368.34	368.21	368.23		
11/11/2014	367.98	367.95	368.13	368.28	368.28	368.29		
5/5/2015	367.59	367.55	367.73	368.25	368.21	368.20		

Note: Elevations in feet above Mean Sea Level (MSL, equivalent to NGVD29)

Appendix D-3
Landfill Monitoring Well Piezometric Data
AEP Rockport Plant, Indiana

Well ID	4S	4I	5S	5I	6S	7S	7I	8S
Min	366.52	366.5	388.8	387.63	365.95	366.15	366.31	367.1
Max	371.89	371.86	394.52	392.9	370.65	370.41	371.9	371.56
Date								
11/18/1992								
5/5/1995								
11/28/1995								
6/6/1996								
11/12/1998	370.28	370.26	390.41					370.87
5/27/1999	369.35	369.47	392.50					370.05
11/17/1999	367.99	367.99	389.20					368.71
5/10/2000	367.39	367.40	392.93	391.00	366.61	366.79	366.78	368.06
11/8/2000	367.05	367.04	391.56	389.63	365.95	366.15	366.31	367.70
12/29/2000								
5/8/2001	367.13	367.13	392.11	390.34	366.33	366.41	366.40	367.72
5/29/2001								
11/7/2001	366.52	366.50	391.51					367.10
11/13/2001								
5/29/2002	368.01	368.00	393.72					368.58
8/1/2002								
11/13/2002	368.40	368.42	390.96					368.91
5/14/2003	368.98	368.98	394.52					369.53
11/6/2003	369.92	369.90	390.61					370.32
5/19/2004	370.76	370.78	393.85	391.95	370.65	370.37	370.35	371.21
11/9/2004	370.96	370.65		390.87				371.20
5/17/2005	371.89	371.86		392.90			371.90	
11/8/2005	369.97	369.97	389.50	387.63	368.75	368.98	368.94	370.61
5/9/2006	368.45	368.45	393.30					369.02
11/8/2006	367.66	367.64	394.29					368.17
5/9/2007	369.37	369.38	392.90					369.81
11/12/2007	368.44	368.47	389.40					369.45
5/6/2008	369.68	368.69	392.81					370.22
11/20/2008	369.85	369.87	389.49					370.50
5/20/2009	368.58	368.59	394.29					369.24
7/14/2009								
9/9/2009								
11/10/2009	368.28	368.31	393.55					368.91
1/19/2010								
3/17/2010								
5/18/2010	368.76	368.76	393.09					369.29
11/3/2010	368.22	368.23	388.80					368.66
1/4/2011								
1/10/2011								
1/17/2011								
2/8/2011								
2/14/2011								
3/2/2011								
3/22/2011								
5/12/2011	368.77	368.77	394.12					369.31
11/10/2011	370.86	371.03	389.75					371.56
5/8/2012			391.46	389.55	370.39	370.41	370.41	371.46
11/7/2012			389.59	387.77	367.53	367.80	367.76	369.52
5/16/2013				392.10	367.64	367.58	367.55	368.56
8/21/2013								
11/4/2013			390.76	388.96	367.33	367.32	367.29	368.23
1/20/2014								
5/7/2014			394.43					368.59
11/11/2014			390.60					368.84
5/5/2015			393.54					368.34

Appendix D-3
Landfill Monitoring Well Piezometric Data
AEP Rockport Plant, Indiana

Well ID	8I	9S	10S	11S	12S	13S	14S	15S
Min	367.23	386.89	400.09	366.33	364.85	366.2	367.85	366.24
Max	372.48	393.1	402.92	370.75	370.05	370.56	371.6	371.76
Date								
11/18/1992				368.96				
5/5/1995								
11/28/1995								
6/6/1996								
11/12/1998	371.00							
5/27/1999	370.20							369.18
11/17/1999	368.85							367.58
5/10/2000	368.25	390.35	400.79	366.76	366.59	367.15	368.05	367.11
11/8/2000	367.85	389.11	400.09	366.33	364.85	366.20	367.85	366.75
12/29/2000								
5/8/2001	367.96	390.01	400.65	366.65	365.75	366.62	367.90	366.86
5/29/2001								367.88
11/7/2001	367.23							366.24
11/13/2001								368.21
5/29/2002	368.76							367.88
8/1/2002								369.23
11/13/2002	369.09							368.21
5/14/2003	369.70							368.87
11/6/2003	370.49							369.82
5/19/2004	371.38	391.89	402.92	370.67	370.05	370.56	371.29	370.82
11/9/2004	371.34							370.40
5/17/2005	372.48							371.76
11/8/2005	370.79	387.77	402.81	369.32	367.11	368.87	370.95	369.65
5/9/2006	369.19							368.29
11/8/2006	368.33							367.54
5/9/2007	369.96							369.38
11/12/2007	369.18							368.14
5/6/2008	370.38							369.67
11/20/2008	370.65							369.63
5/20/2009	369.40							368.37
7/14/2009								
9/9/2009								
11/10/2009	369.09							368.07
1/19/2010								
3/17/2010								
5/18/2010	369.45							368.64
11/3/2010	369.03							368.07
1/4/2011								
1/10/2011								
1/17/2011								
2/8/2011								
2/14/2011								
3/2/2011								
3/22/2011								
5/12/2011	369.56				370.05			368.53
11/10/2011	371.79				368.32			370.87
5/8/2012	371.70	388.61	401.18	370.75	369.43	370.51	371.60	371.00
11/7/2012		386.89	401.11	368.00	366.03	367.73	369.77	368.57
5/16/2013	368.80	393.10	401.19	367.93	367.19	367.77	368.83	368.04
8/21/2013								
11/4/2013	368.65	388.04	401.18	367.78	365.97	367.26	368.70	367.99
1/20/2014								
5/7/2014	368.89							368.69
11/11/2014	369.14							368.56
5/5/2015	368.62							367.86

Appendix D-3
Landfill Monitoring Well Piezometric Data
AEP Rockport Plant, Indiana

Well ID	15I	16S	16I	16D	17S	17I	18	19
Min	366.25	366.09	366.11	366.14	366.55	366.56	367.64	367.64
Max	371.79	371.73	371.75	370.9	371.88	371.25	367.72	367.79
Date								
11/18/1992								
5/5/1995			368.02					
11/28/1995		368.30	368.33	368.33	368.84	368.85		
6/6/1996						369.66		
11/12/1998								
5/27/1999	369.16	369.08	369.08	369.11	369.41	369.42		
11/17/1999	367.65	367.38	367.38	367.44	367.97	367.98		
5/10/2000	367.12	367.05	367.06	367.10	367.23	367.27		
11/8/2000	366.76	366.58	366.62	366.61	367.08	367.05		
12/29/2000								
5/8/2001	366.88	366.76	366.77	366.79	367.08	367.05		
5/29/2001								
11/7/2001	366.25	366.09	366.11	366.14	366.55	366.56		
11/13/2001								
5/29/2002	367.90	367.86	367.92	367.94	367.92	367.91		
8/1/2002	369.25			369.23		369.26		
11/13/2002	368.22	368.04	367.98	368.09	368.50	368.51		
5/14/2003	368.90	368.85	368.83	368.90	368.95	368.98		
11/6/2003	369.86	369.70	369.64	369.72	370.04	370.08		
5/19/2004	370.73	370.67	370.71	370.74	370.84	370.81		
11/9/2004	370.45	370.28	370.28	370.34	370.69	370.71		
5/17/2005	371.79	371.73	371.75	370.80	371.88			
11/8/2005	369.68	369.43	369.44	369.49	370.06	370.06		
5/9/2006	368.33	368.20	368.19	368.24	368.49	368.52		
11/8/2006	367.57	367.49	367.43	367.50	367.74	367.76		
5/9/2007	369.42	369.34	369.39	369.48	369.42	369.44		
11/12/2007	368.18	367.98	367.97	368.04	368.54	368.55		
5/6/2008	369.67	369.80	369.82	369.84	369.59			
11/20/2008	369.65	369.40	369.34	369.45	369.98	369.95		
5/20/2009	368.42	368.25	368.26	368.32	368.64	368.65		
7/14/2009								
9/9/2009								
11/10/2009	368.10	367.88	367.86	367.93	368.49	368.51		
1/19/2010								
3/17/2010								
5/18/2010	368.68	368.55	368.57		368.84	368.86		
11/3/2010	368.06	367.83	367.83	367.90	368.46	368.46		
1/4/2011				367.15				
1/10/2011				367.03				
1/17/2011		366.99	366.98	367.03				
2/8/2011		366.58	366.59	366.63				
2/14/2011		366.59	366.59	366.64				
3/2/2011		366.40	366.41	366.46				
3/22/2011		366.79	366.79	366.84				
5/12/2011	368.57	368.58	368.60	368.65	368.43	368.46		
11/10/2011	370.89	370.59	370.60	370.75	371.20	371.20		
5/8/2012	371.01	370.84	370.83	370.90	371.21	371.25		
11/7/2012	368.57	368.29	368.31	368.35	368.97	368.99		
5/16/2013	368.05		367.89	367.96	368.20	368.22	367.72	367.64
8/21/2013								
11/4/2013	367.98	367.73	367.75	367.82	368.35	368.27	367.64	367.79
1/20/2014								
5/7/2014	368.68	368.61	368.63	368.69	368.81	368.81		
11/11/2014	368.57	368.29	368.30	368.38	368.94	368.94		
5/5/2015	367.83	367.77		367.84	367.87	367.87		

Appendix D-3
Landfill Monitoring Well Piezometric Data
AEP Rockport Plant, Indiana


Well ID	20	21S	21I	21D
Min	367.44	366.8	367.57	367.7
Max	368.11	370.81	370.73	370.85
Date				
11/18/1992				
5/5/1995				
11/28/1995				
6/6/1996				
11/12/1998				
5/27/1999				
11/17/1999				
5/10/2000				
11/8/2000				
12/29/2000				
5/8/2001				
5/29/2001				
11/7/2001				
11/13/2001				
5/29/2002				
8/1/2002				
11/13/2002				
5/14/2003				
11/6/2003				
5/19/2004				
11/9/2004				
5/17/2005				
11/8/2005				
5/9/2006				
11/8/2006				
5/9/2007				
11/12/2007				
5/6/2008				
11/20/2008				
5/20/2009		368.23	368.22	368.21
7/14/2009		368.73	368.72	368.72
9/9/2009		368.40	368.46	368.46
11/10/2009		367.98	367.92	368.04
1/19/2010		366.80	367.76	367.82
3/17/2010		368.01	367.93	368.07
5/18/2010		368.64	368.68	368.68
11/3/2010		367.86	367.79	367.93
1/4/2011				
1/10/2011				
1/17/2011				
2/8/2011				
2/14/2011				
3/2/2011				
3/22/2011				
5/12/2011		368.89	368.80	368.95
11/10/2011		370.68	370.63	370.75
5/8/2012		370.81	370.73	370.85
11/7/2012		368.45	368.37	368.52
5/16/2013	367.44	367.86	367.75	367.92
8/21/2013				
11/4/2013	368.11	367.66	367.57	367.70
1/20/2014				
5/7/2014		368.33	368.30	368.45
11/11/2014		368.20	368.06	368.30
5/5/2015		367.87	367.75	367.92

Appendix D-4

Landfill Monitoring Well Hydrographs


AEP Rockport Plant

Landfill - Monitoring Well Hydrographs (All)

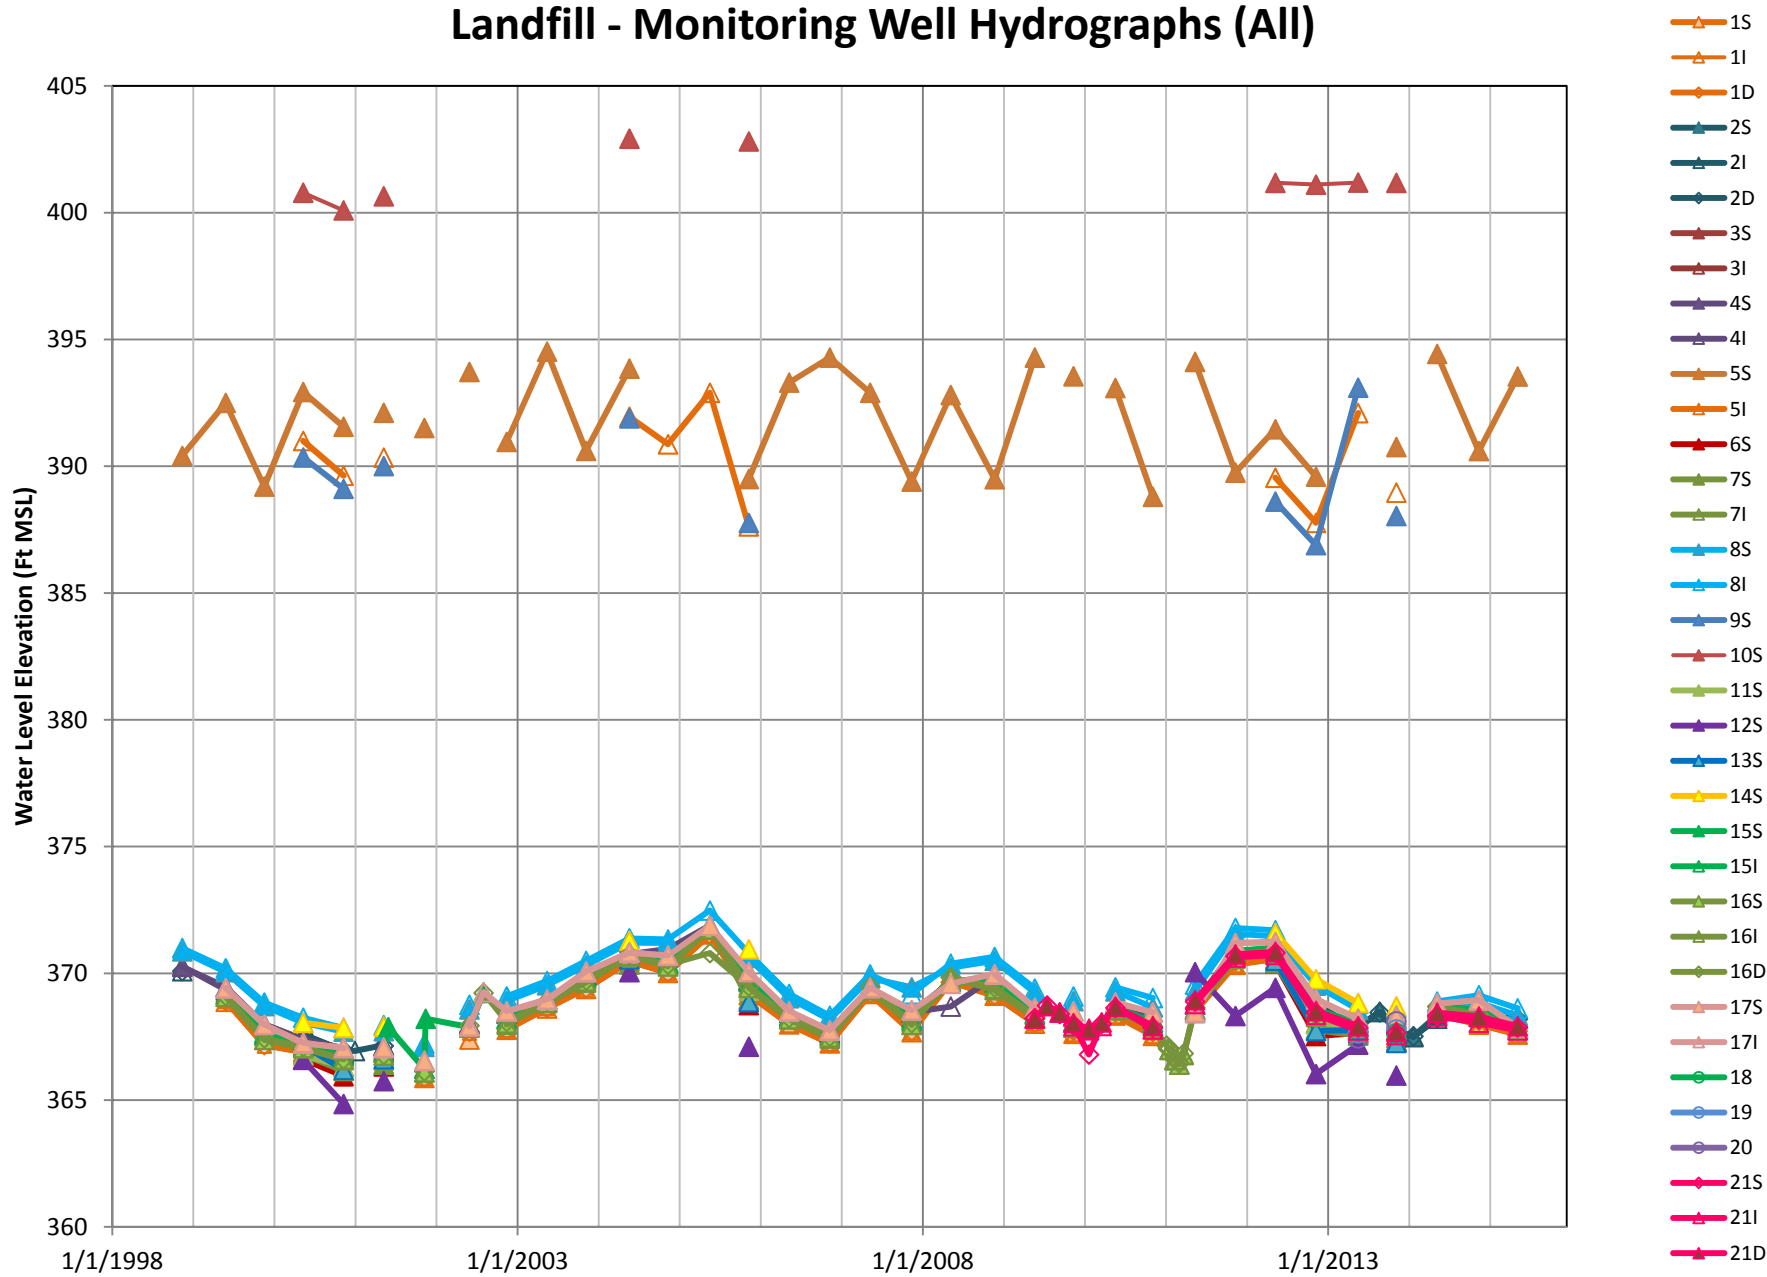

AEP Rockport Plant

Landfill - Monitoring Well Hydrographs

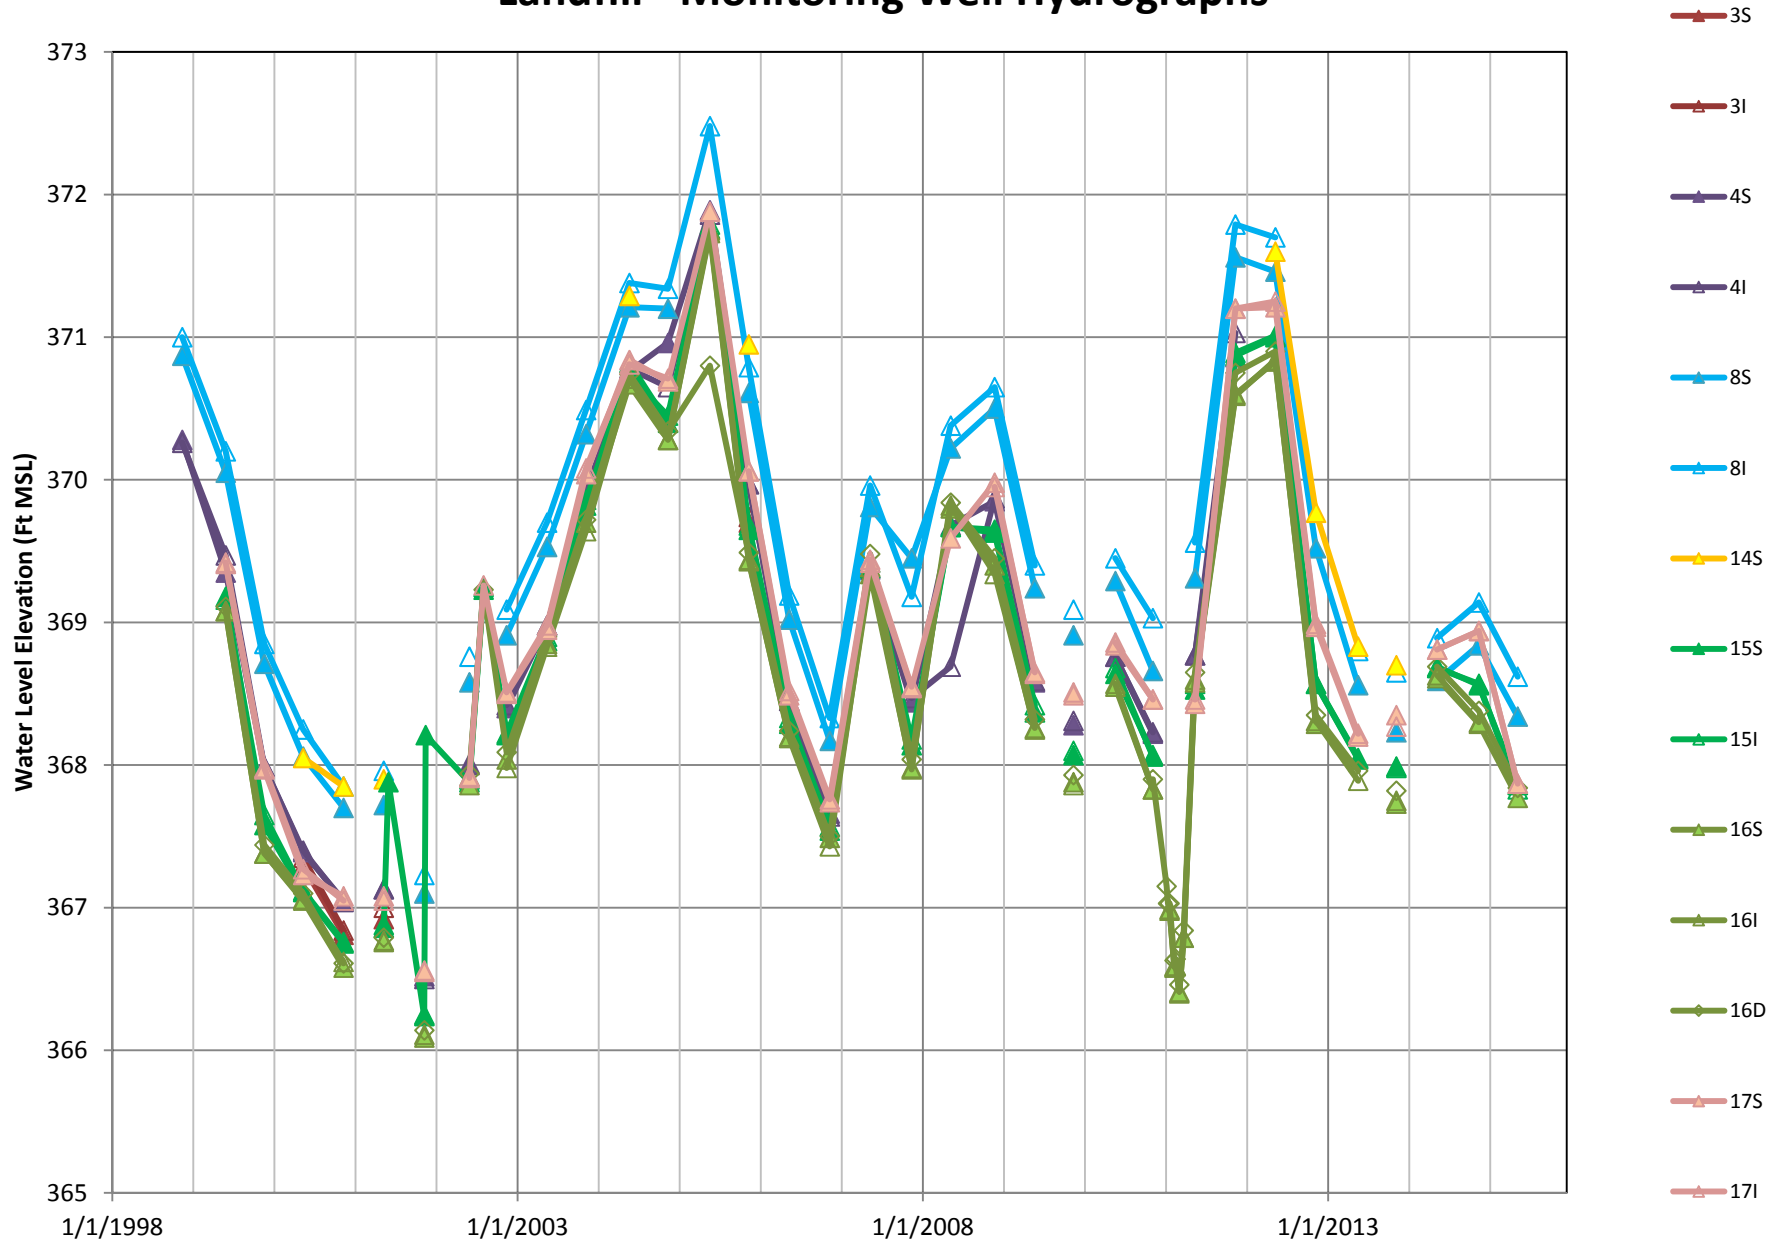

AEP Rockport Plant

Landfill - Monitoring Well Hydrographs

